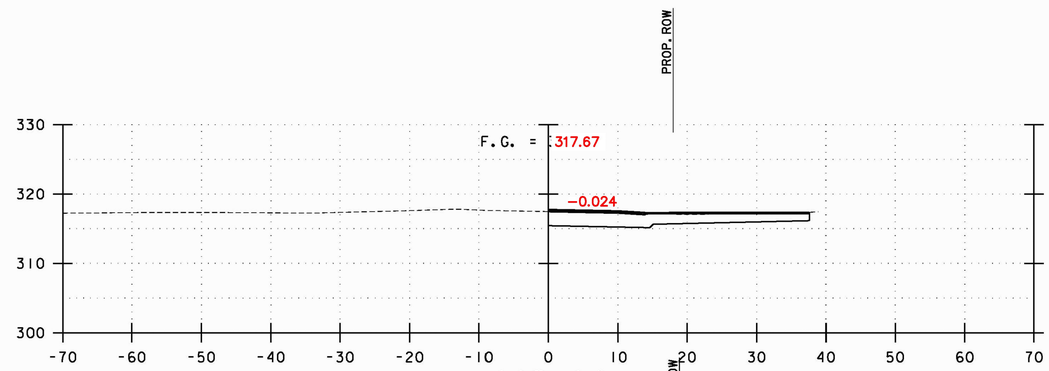

118+14

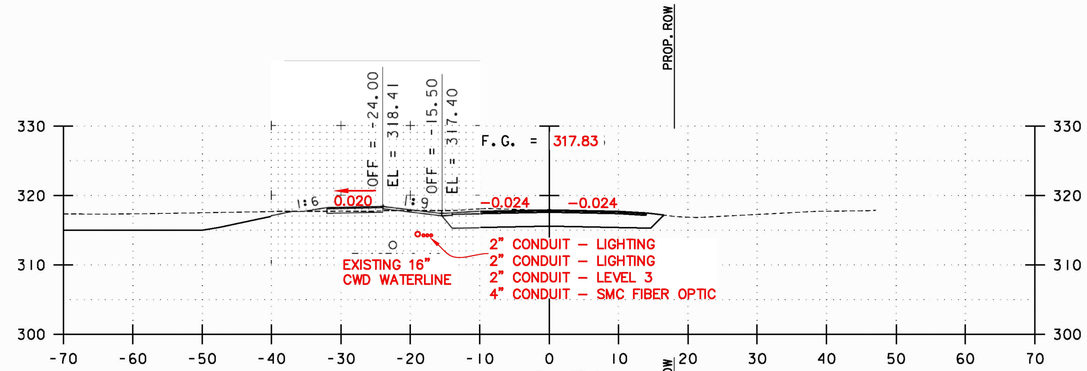

119+50

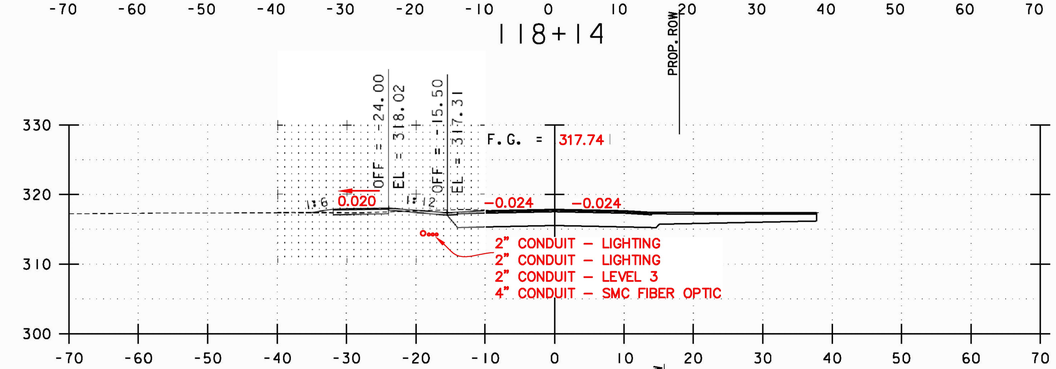

118+00

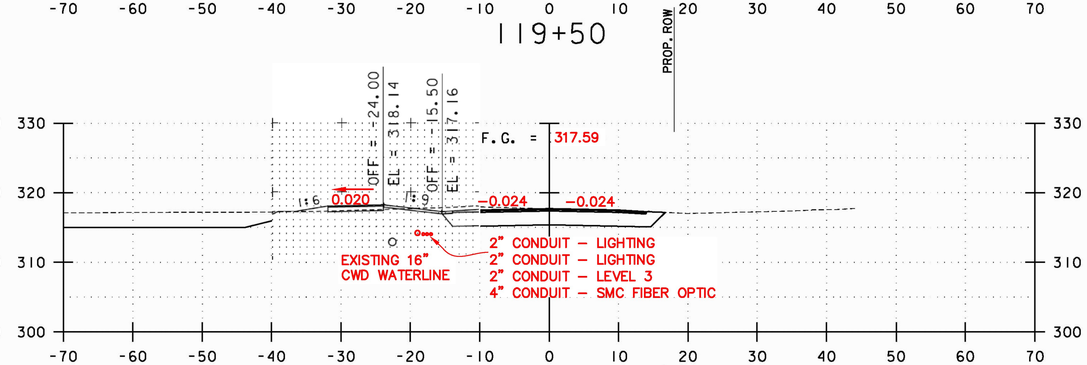

119+00

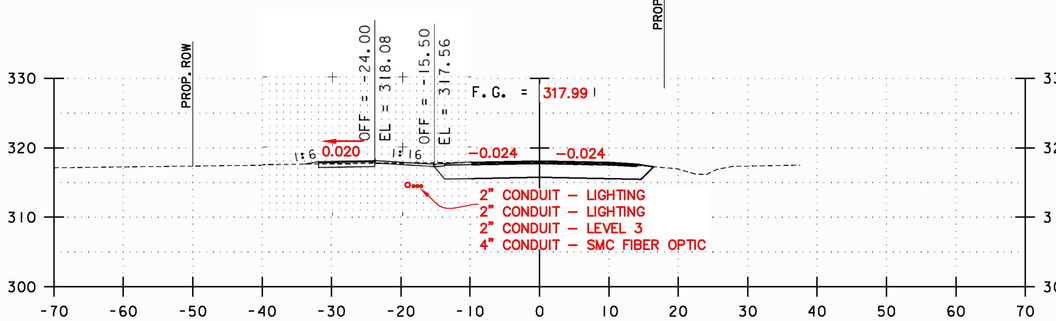

117+50

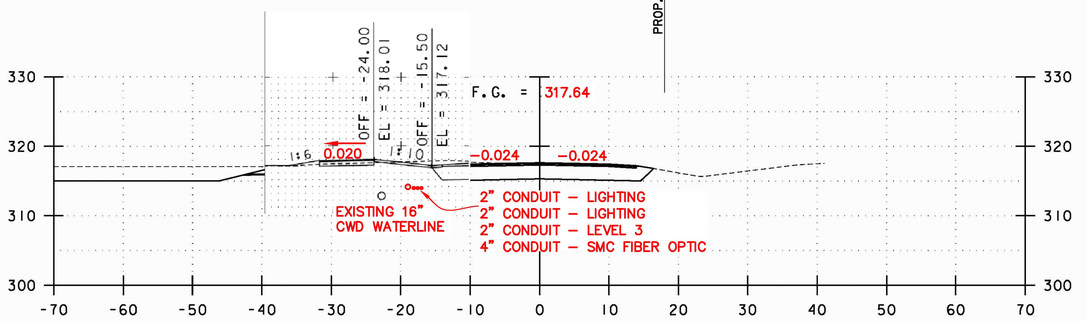

118+50

RECORD DRAWING

DATE: DECEMBER 21, 2012

0 10 20
SCALE

Stantec

PROJECT NAME:	COLCHESTER CAMPUS CONNECTOR
PROJECT NUMBER:	TCSP TCSE (007)

FILE NAME: ...\Plot Files\132-145_xs.ptf	PLOT DATE: 12/2/2010
PROJECT LEADER: JBL	DRAWN BY: TFD
DESIGNED BY: TFD	CHECKED BY: GGG
MAINLINE XS-8	SHEET 146 OF 153