SEE FINAL SECTIONS PLOT DATE 11-20-06.

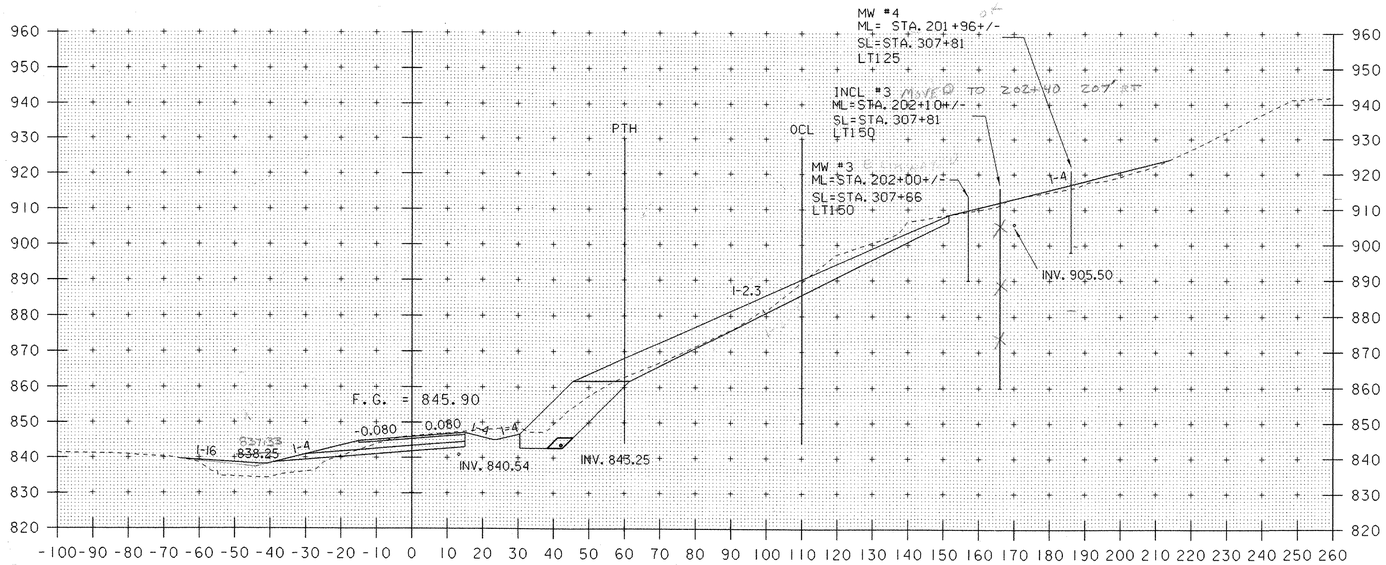

202+00

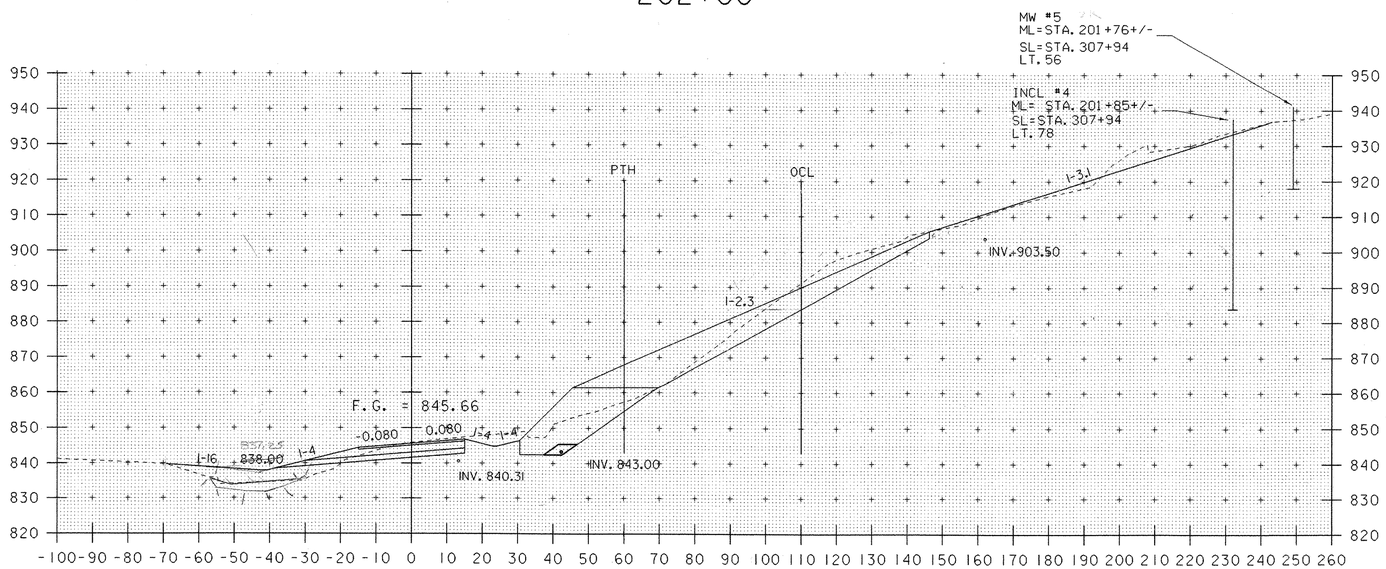

201+80

Muck (A1)

8.25/0.16 = 51.56 FT²

KRM 1-10-07

0 20 40
SCALE IN FEET

STA. 201+80 TO STA. 202+00

PROJECT NAME: HARDWICK	
PROJECT NUMBER: STP ST 030-3(4)	
FILE NAME: d04e060xslx.dgn	PLOT DATE: 18-OCT-2005
PROJECT LEADER: A. BOMBARDIER	DRAWN BY: M. NUTTER
DESIGNED BY: M. NUTTER	CHECKED BY: A. BOMBARDIER
IPARM NAME: de060xsl5.i	SHEET 47 OF 63