TEMPORARY 4" WHITE LINE, PAINT
DURABLE 4" WHITE LINE, THERMOPLASTIC
STA 126+50 TO 128+42 SOLID LT
STA 126+50 TO 131+50 SOLID RT
STA 128+90 TO 131+50 SOLID LT

TEMPORARY 4" YELLOW LINE, PAINT
DURABLE 4" YELLOW LINE, THERMOPLASTIC
STA 126+50 TO 128+43 SOLID LT & RT
STA 128+83 TO 131+50 SOLID LT & RT

TEMPORARY CROSSWALK MARKING, PAINT
STA 128+56 TO 128+80 LT

SPECIAL PROVISION
(DURABLE CROSSWALK MARKING, IMPRINTED/COLORIZED)
STA 128+56 TO 128+80 LT

CONSTRUCT SIDEWALK RAMP W/DETECTABLE WARNING SURFACE (CAST IRON)
STA 128+57 LT (TYPE 1)
STA 128+79 LT (TYPE 1)

CHANGING ELEVATION OF DROP INLETS, CATCH BASINS OR MANHOLES
~~STA 126+65 RT (CB)~~
~~STA 128+48 LT (CB)~~
STA 128+50 RT (CB)
STA 131+24 LT (CB)
STA 131+24 RT (CB)

CHANGING ELEVATION OF SEWER MANHOLES
STA 126+65 RT (SMH)
STA 127+58 RT (SMH)
STA 128+60 LT (SMH)

ADJUST ELEVATION OF VALVE BOX
STA 128+66 LT (WSO)

REHAB OF DI, CB
128+48 LT
126+65 RT

STEEL BEAM GUARDRAIL, GALVANIZED W/8 FEET POSTS
STA 126+50 TO 131+50 RT

REMOVAL AND DISPOSAL OF GUARDRAIL
STA 126+50 TO 131+50 RT

BITUMINOUS CONCRETE CURB, TYPE B
STA 126+60 TO 131+50 RT

REMOVING SIGNS
AS SHOWN - 15

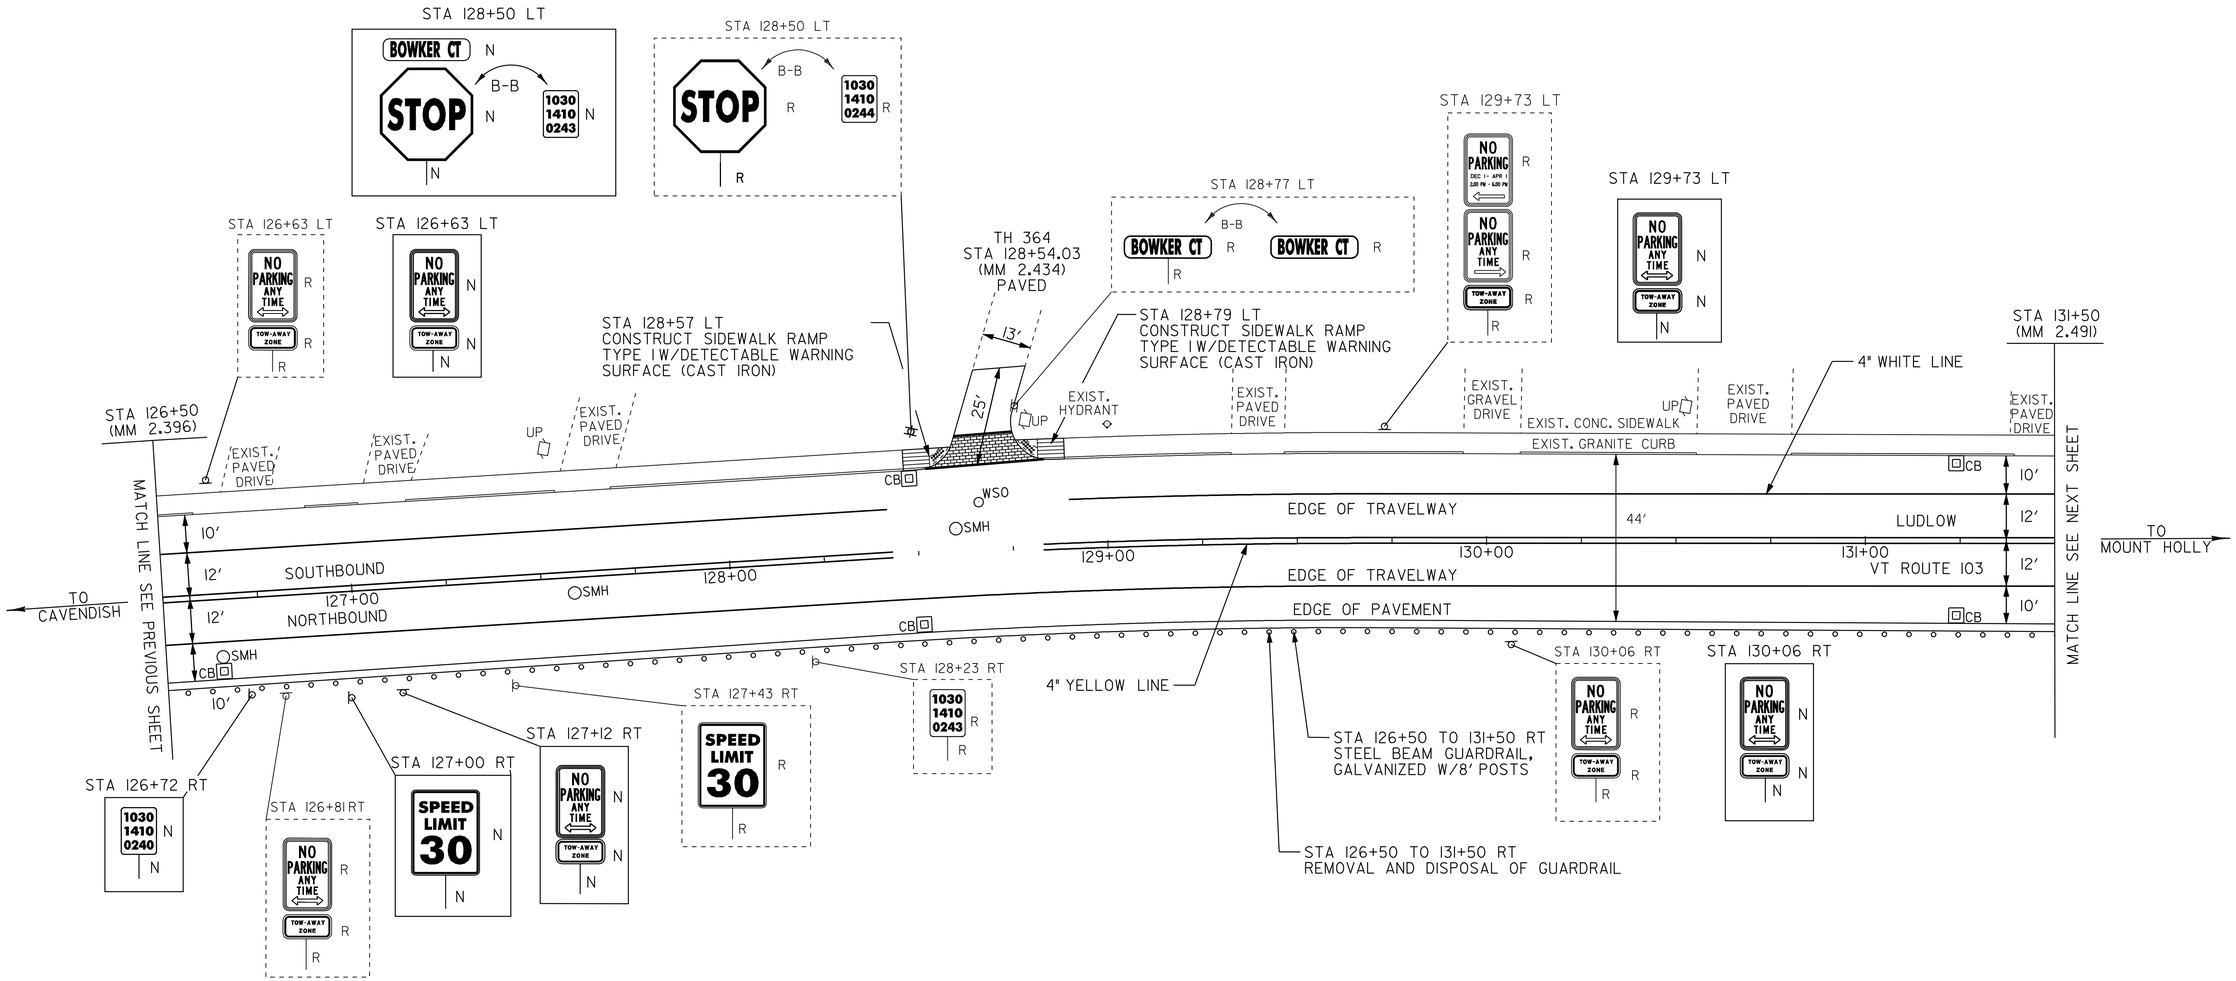

NOT TO SCALE

LEGEND

R	=	REMOVE EXISTING
S	=	SALVAGE
R&S	=	REMOVE AND SALVAGE
N	=	NEW
RET	=	RETAIN
B-B	=	BACK TO BACK
o—o	=	NEW RAIL
x—x	=	EXISTING RAIL

PAVING PROJECT LAYOUT #13

PROJECT: LUDLOW
PROJECT NO.: NH 2409(I)S
DESIGN FILE NAME: /pave/05B008/pb008.dgn
IPARM FILE NAME: pb008ial3.i
SURVEYED BY: CLD ENGINEERS, INC
SURVEY DATE: 11/05
SQUAD LEADER: PIS
DRAWN BY: MRS
CLD REF. NO.: 05-0389
PLOT DATE: 20-MAY-2010 14
SHEET: 25 OF 51