STATE OF VERMONT
AGENCY OF TRANSPORTATION

TRAFFIC SIGN SUMMARY SHEET #6

MILEMARKER, STATION, OR SIGN NUMBER	SIGN LEGEND	SIGN DIMENSIONS EA	WIDTH (in)	HEIGHT (in)	NEW & SALVAGED SIGNS "A"	"B"	SALV SIGN	SALV TIS	EXIST POST RETAIN	EXIST POST SALVAGE	NEW SIGN POSTS NO. OF POSTS	FLANGED CHANNEL lb/ft 1.12	2.0	3.0	SQUARE STEEL (in) 1.75 lb/ft 1.88	2.0 lb/ft 2.16	2.5 lb/ft 3.35	ANCHOR	SLEEVE	TUBULAR ALUMINUM Ø (in) 3.0 lb/ft 1.3	4.0 lb/ft 1.7	4.0 MOD lb/ft 1.7	TUBULAR STEEL Ø (in) FOUNDATION	3.0 lb/ft 7.6	3.5 lb/ft 9.0	4.0 lb/ft 10.8	5.0 lb/ft 14.6	W-SHAPE STEEL FTG. SIZE 24"	30"	WEIGHT	POST SIZE	SIGN FRAME REQUIRED	REMARKS	SIGN DETAIL DETAIL ON SHEET NUMBER	STD. SHEET NUMBER
											OPTION ITEMS																									
STA 108+17 LT		1	30	30	6.25						1			X 15		X		X																	E-152
		1	24	12	2.00																														E-152
STA 111+84 LT		1	24	30	5.00						1			X 13		X		X																	E-142
STA 113+76 RT		1	6	10	0.42						1		~~X~~	8	X			X																	E-138
STA 113+77 LT		1	32	9	2.00																												MOUNT TO UTILITY POLE USING BANDS W/RUBBER GASKET		E-123
116+08 RT	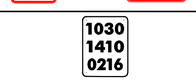	1 1	30 24	30 12	6.25 2.00						1			15																					
STA 114+42 LT		1	6	10	0.42						1		~~X~~	8	X			X																	E-138
STA 114+78 RT		1	24	30	5.00						1			X 13		X		X																	E-142
STA 115+46 RT		1	21	15	2.19						1			X 13		X		X																	E-136B
		1	30	24	5.00																														E-136B
116+50 LT		1 1	30 24	30 12	6.25 2.00						1			15																					
STA 116+10 LT		1	12	18	1.50						1			X 12		X		X																R7-108		
STA 116+38 LT		1	12	18	1.50						1			X 12		X		X																R7-108		
STA 116+60 LT		1	24	12	2.00						1			X 14		X		X																	E-136B
		1	30	24	5.00																														E-136B
												FT	FT	FT	FT	FT	FT		EA	LB	LB	LB		LB	LB	LB	LB								
													~~30~~	~~105~~	~~30~~	~~105~~																				
TOTALS		SF ~~38.28~~ 54.78	SF	EA.	SF							FT ~~135~~ 138			FT ~~135~~					LB			EA.	LB				EA.	EA.	LB					

FINAL POST LENGTHS ARE TO BE DETERMINED IN THE FIELD. POST SIZES ARE COMPUTED BASED ON INFORMATION FURNISHED ON THE STANDARD SHEETS AND THE ROADWAY TRAFFIC & SAFETY SECTION'S "SIGN POST DESIGN GUIDELINE."

TRAFFIC SIGN SUMMARY SHEET #6

PROJECT NAME: LUDLOW
PROJECT NUMBER: NH 2409(I)S

FILE NAME: /pave/05B008/pb008.dgn
PROJECT LEADER: PTS
DESIGNED BY: NLL
IPARM FILE NAME: pb008ts06.i
PLOT DATE: 20-MAY-2010 14:3
DRAWN BY: MRS
CHECKED BY: NLL
SHEET 38 OF 51