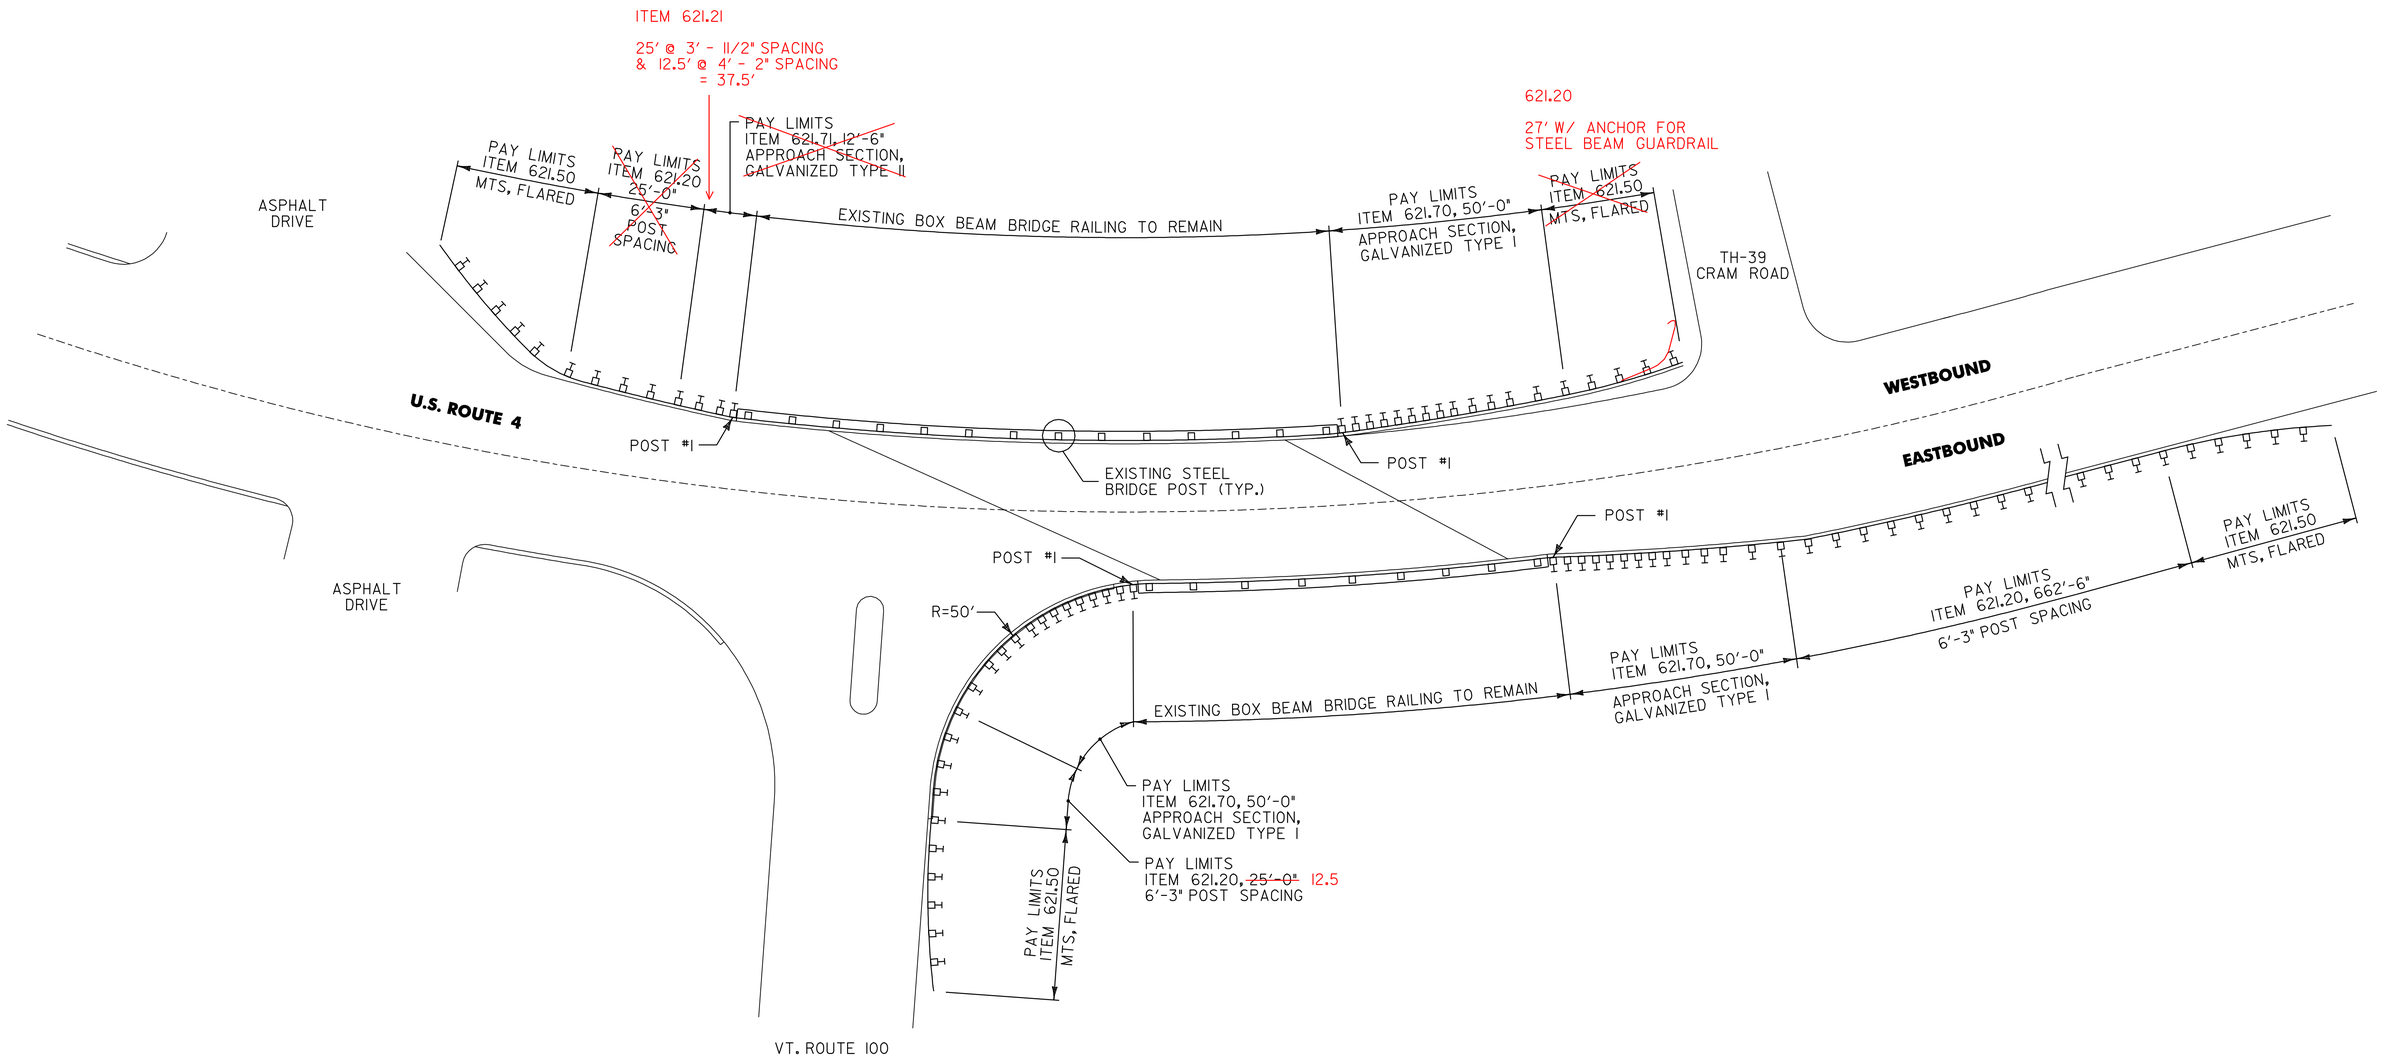

BR 35 BRIDGEWATER MM 0.079 = STA. 4+17.12

NOT TO SCALE

BRIDGE DETAIL SHEET #2	PROJECT NAME: KILLINGTON - BRIDGEWATER PROJECT NUMBER: NH 2502(1)S
	FILE NAME: p05b036.dgn PROJECT LEADER: D.E.G. DESIGNED BY: J.S.P. IPARM FILE: p05b036bd02.i PLOT DATE: 15-MAY-2008 14 DRAWN BY: C.A.K. CHECKED BY: D.E.G. SHEET 66 OF 74