(W)ILMINGTON
HES 010-1(38)

BR. 20 PRECAST CONCRETE CATCH BASIN

√1 EA

DOL. 20615 18" CPEP (SL)

√72 LF

DOL. 70115 18" CPEP

√1 EA

202.31 SPUR BORROW

E.M. BY C.GREENWOOD
USED FOR UNDERCUT & BACKFILL DUE TO POOR MATERIAL

1'x 4.5'x 60' = √270 CF
1.5'x 3.0'x 71' = √319.5 CF
1'x 4.5'x 72' = √324 CF

√913 CF ÷ 27
= √34 CY

613.12 STONE FILL, TYPE B

E.M. BY C.GREENWOOD

1'x 9'x 12' = √108 CF
÷ 27
= √4 CY

649.31 GEOTEXTILE UNDER STONE FILL

9 x 12 = 108 SY

= √12 SY

2010 ROUTE RELOCATION OF CRETTS

















NOTE
5/11/10

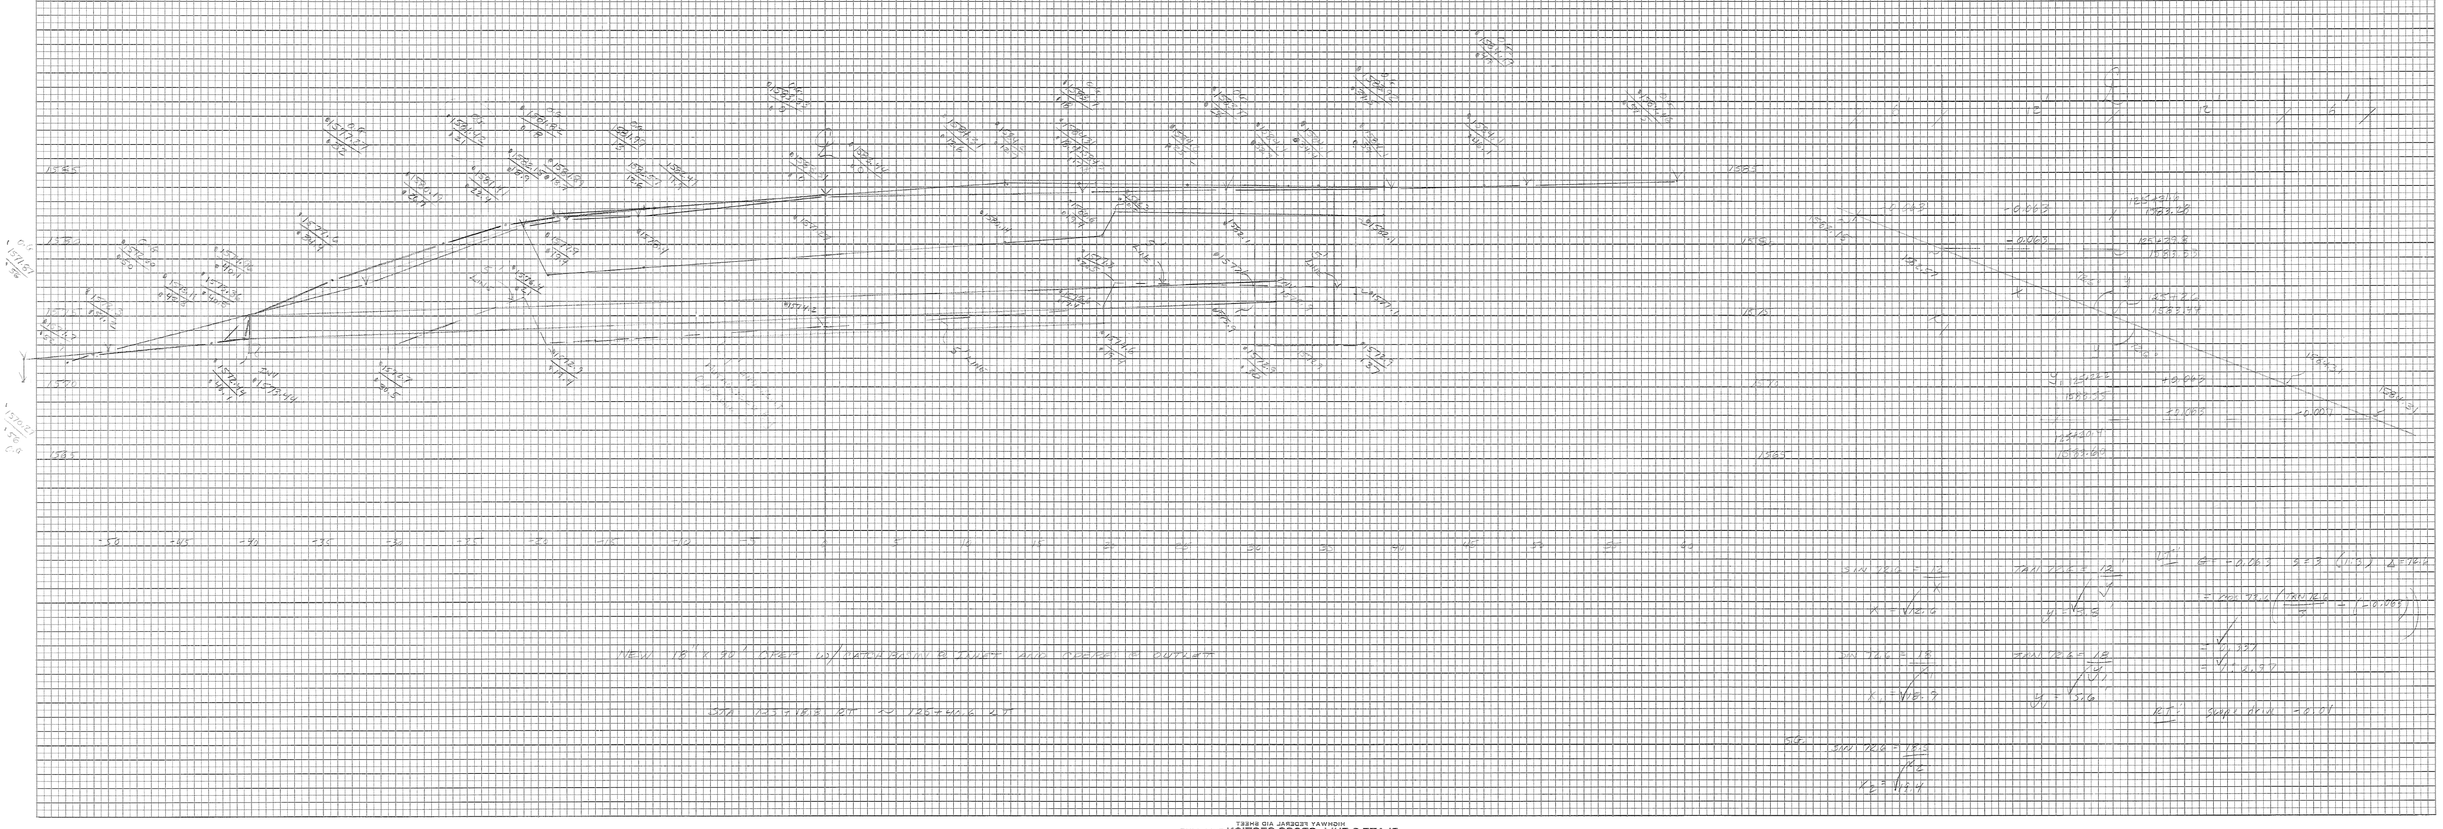

HIGHWAY FEDERAL AID SHEET
PLATE 3-FULL CROSS SECTION-FULL LINE
NATIONAL PRINTING
PRINTED IN U.S.A.