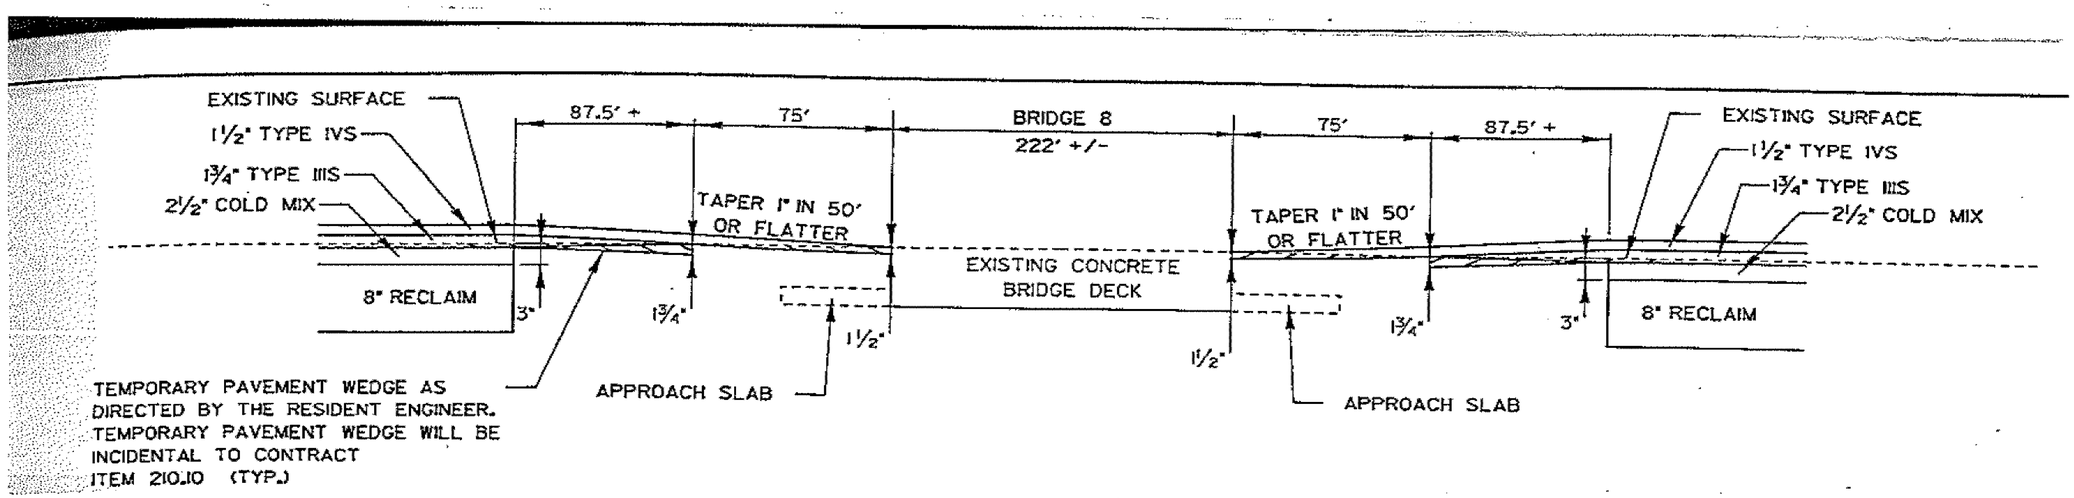BRIDGE TRANSITION AREA DETAIL