646.402 DURABLE 4 INCH WHITE LINE, THERMOPLASTIC OR
646.403 DURABLE 4 INCH WHITE LINE, EPOXY PAINT OR
646.404 DURABLE 4 INCH WHITE LINE, POLYUREA
(ALL LINES WILL INCLUDE EDGE LINE BREAKS AND RADII FOR TOWN HIGHWAYS)
WARREN:
STA 50+00.00 - STA 55+50.00 LT & RT

646.412 DURABLE 4 INCH YELLOW LINE, THERMOPLASTIC OR
646.413 DURABLE 4 INCH YELLOW LINE, EPOXY PAINT OR
646.414 DURABLE 4 INCH YELLOW LINE, POLYUREA
(ALL LINES WILL INCLUDE C/L BREAKS FOR TOWN HIGHWAYS) S=SOLID, D=DASHED
WARREN:

	LT ℄	RT
STA 50+00.00 - STA 55+50.00	S -	S

646.602 TEMPORARY 4 INCH WHITE LINE, PAINT
(ALL LINES WILL INCLUDE EDGE LINE BREAKS AND RADII FOR TOWN HIGHWAYS)
WARREN:
STA 50+00.00 - STA 55+50.00 LT & RT

646.612 TEMPORARY 4 INCH YELLOW LINE, PAINT
(ALL LINES WILL INCLUDE C/L BREAKS FOR TOWN HIGHWAYS) S=SOLID, D=DASHED
WARREN:

	LT ℄	RT
STA 50+00.00 - STA 55+50.00	S -	S

675.50 REMOVING SIGNS
AS SHOWN - 1

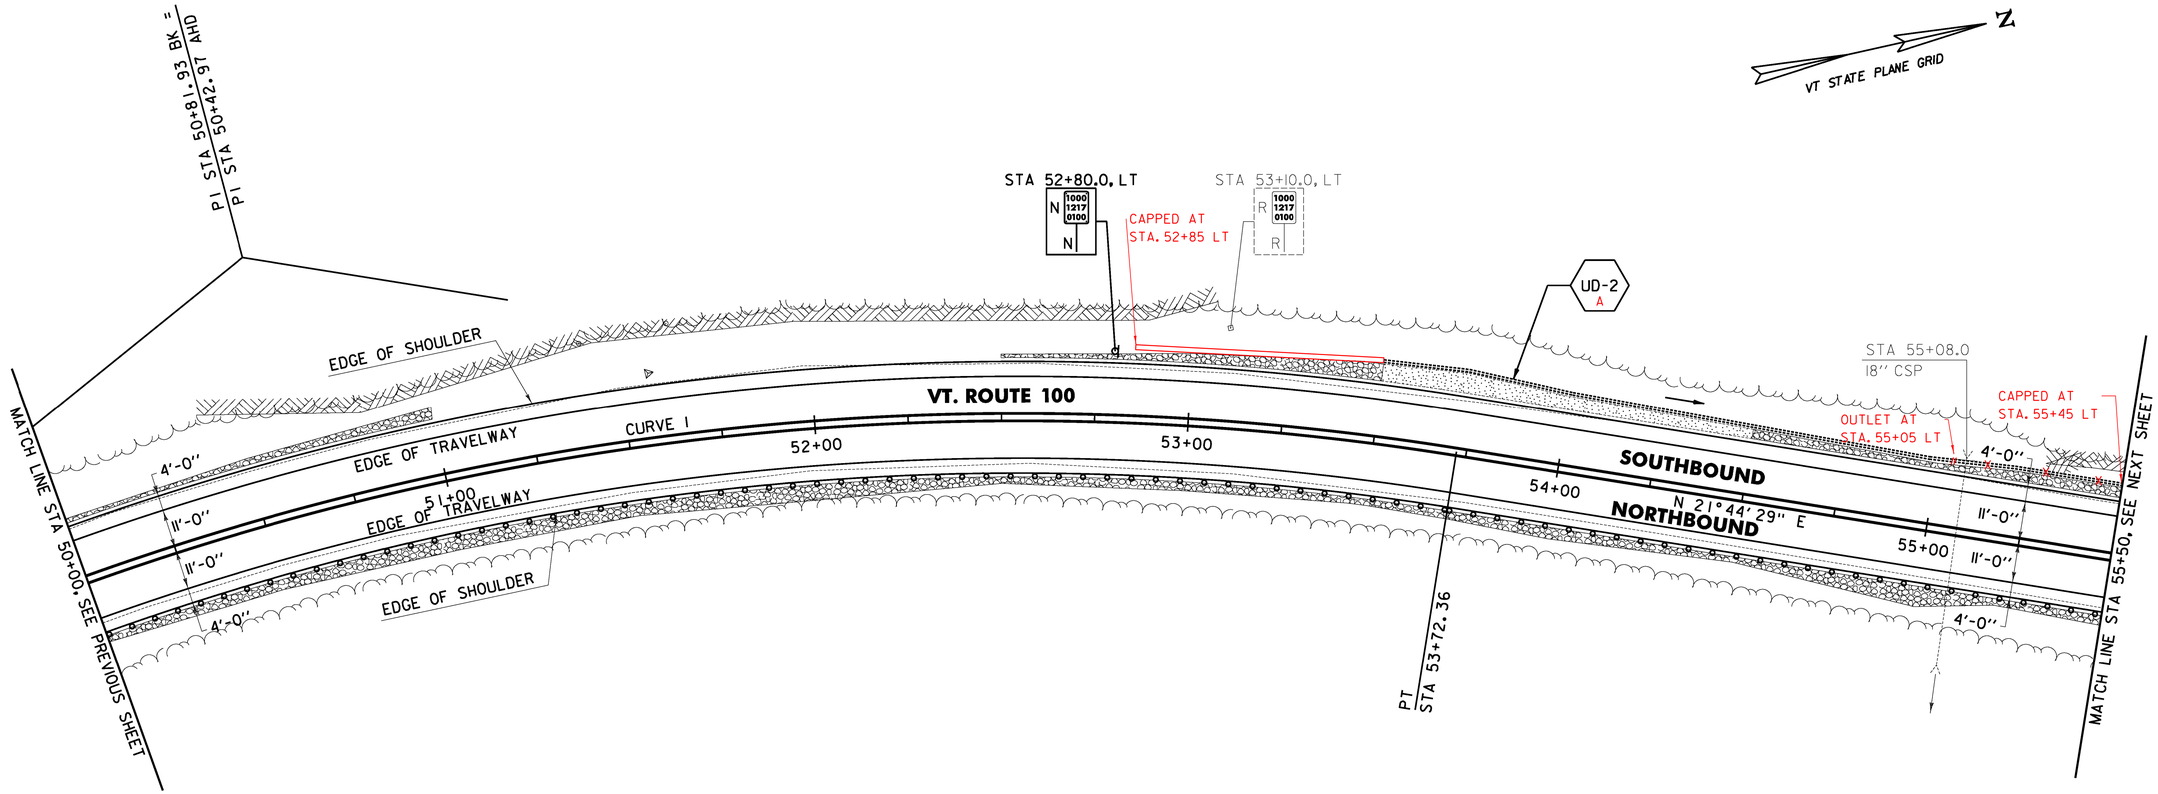

613.10 STONE FILL, TYPE I
WARREN:
STA 50+00.0 - STA 51+00.0 LT (9.6 CY)
STA 50+00.0 - STA 55+50.0 RT (78.5 CY)
STA 52+50.0 - STA 53+50.0 LT (12.2 CY)
STA 54+50.0 - STA 55+50.0 LT (10.1CY)

621.80 REMOVAL AND DISPOSAL OF GUARDRAIL
WARREN:
STA 50+00.0 - STA 55+50.0 RT (550.0 LF)

651.40 GRUBBING MATERIAL
WARREN:
STA 50+00.0 - STA 51+00.0 LT (27.4 SY)
STA 50+00.0 - STA 55+50.0 RT (227.6 SY)
STA 52+50.0 - STA 53+50.0 LT (35.1SY)
STA 53+50.0 - STA 54+50.0 LT (46.3 SY)
STA 54+50.0 - STA 55+50.0 LT (28.9 SY)

653.20 TEMPORARY EROSION MATTING
WARREN:
STA 50+00.0 - STA 51+00.0 LT (27.4 SY)
STA 50+00.0 - STA 55+50.0 RT (227.6 SY)
STA 52+50.0 - STA 53+50.0 LT (35.1SY)
STA 53+50.0 - STA 54+50.0 LT (46.3 SY)
STA 54+50.0 - STA 55+50.0 LT (28.9 SY)

649.31 GEOTEXTILE UNDER STONE FILL
WARREN:
STA 50+00.0 - STA 51+00.0 LT (49.6 SY)
STA 50+00.0 - STA 55+50.0 RT (349.8 SY)
STA 52+50.0 - STA 53+50.0 LT (57.3 SY)
STA 54+50.0 - STA 55+50.0 LT (51.1SY)

900.640 SPECIAL PROVISION (BOX BEAM GUARDRAIL W/7 FEET POSTS)
WARREN:
STA 50+00.0 - STA 55+50.0 RT (550.0 LF)

CURVE 1
△ = 47° 59' 25"
D = 7° 44' 34"
R = 740.00'
T = 329.39'
L = 619.82'
E = 70.00'
e = 0.080 FT/FT

SIGN LEGEND
R = REMOVE
S = SALVAGE
N = NEW
RET = RETAIN
B-B = BACK TO BACK
EXISTING = ----------
NEW = ————
① = RETURN TO THE TOWN OF WARREN

LEGEND
ITEM 613.10 STONE FILL, TYPE I
ITEM 653.20 TEMPORARY EROSION MATTING

0 20 40
SCALE IN FEET

PROJECT LAYOUT SHEET #2

PROJECT NAME: WARREN - WAITSFIELD
PROJECT NUMBER: STP 2506(1)
FILE NAME: p05b048.dgn
PROJECT LEADER: D.E.G.
DESIGNED BY: M.J.M.
IPARM FILE: p05b048102.i
PLOT DATE: 12/20/2012
DRAWN BY: W.G.P.
CHECKED BY: D.E.G.
SHEET 28 OF 310

FILE NAME = U:\1776\CADD\WS\STN\STP 2506\p05b048_Contract Plans.dgn
DATE/TIME = 12/20/2012
USER = 4068