646.402 DURABLE 4 INCH WHITE LINE, THERMOPLASTIC OR
646.403 DURABLE 4 INCH WHITE LINE, EPOXY PAINT OR
646.404 DURABLE 4 INCH WHITE LINE, POLYUREA
(ALL LINES WILL INCLUDE EDGE LINE BREAKS AND RADII FOR TOWN HIGHWAYS)
WARREN:
STA 99+50.00 - STA 105+00.00 LT & RT

646.412 DURABLE 4 INCH YELLOW LINE, THERMOPLASTIC OR
646.413 DURABLE 4 INCH YELLOW LINE, EPOXY PAINT OR
646.414 DURABLE 4 INCH YELLOW LINE, POLYUREA
(ALL LINES WILL INCLUDE C/L BREAKS FOR TOWN HIGHWAYS) S=SOLID, D=DASHED

WARREN:	LT	℄	RT
STA 99+50.00 - STA 105+00.00	S	-	S

646.602 TEMPORARY 4 INCH WHITE LINE, PAINT
(ALL LINES WILL INCLUDE EDGE LINE BREAKS AND RADII FOR TOWN HIGHWAYS)
WARREN:
STA 99+50.00 - STA 105+00.00 LT & RT

646.612 TEMPORARY 4 INCH YELLOW LINE, PAINT
(ALL LINES WILL INCLUDE C/L BREAKS FOR TOWN HIGHWAYS) S=SOLID, D=DASHED

WARREN:	LT	℄	RT
STA 99+50.00 - STA 105+00.00	S	-	S

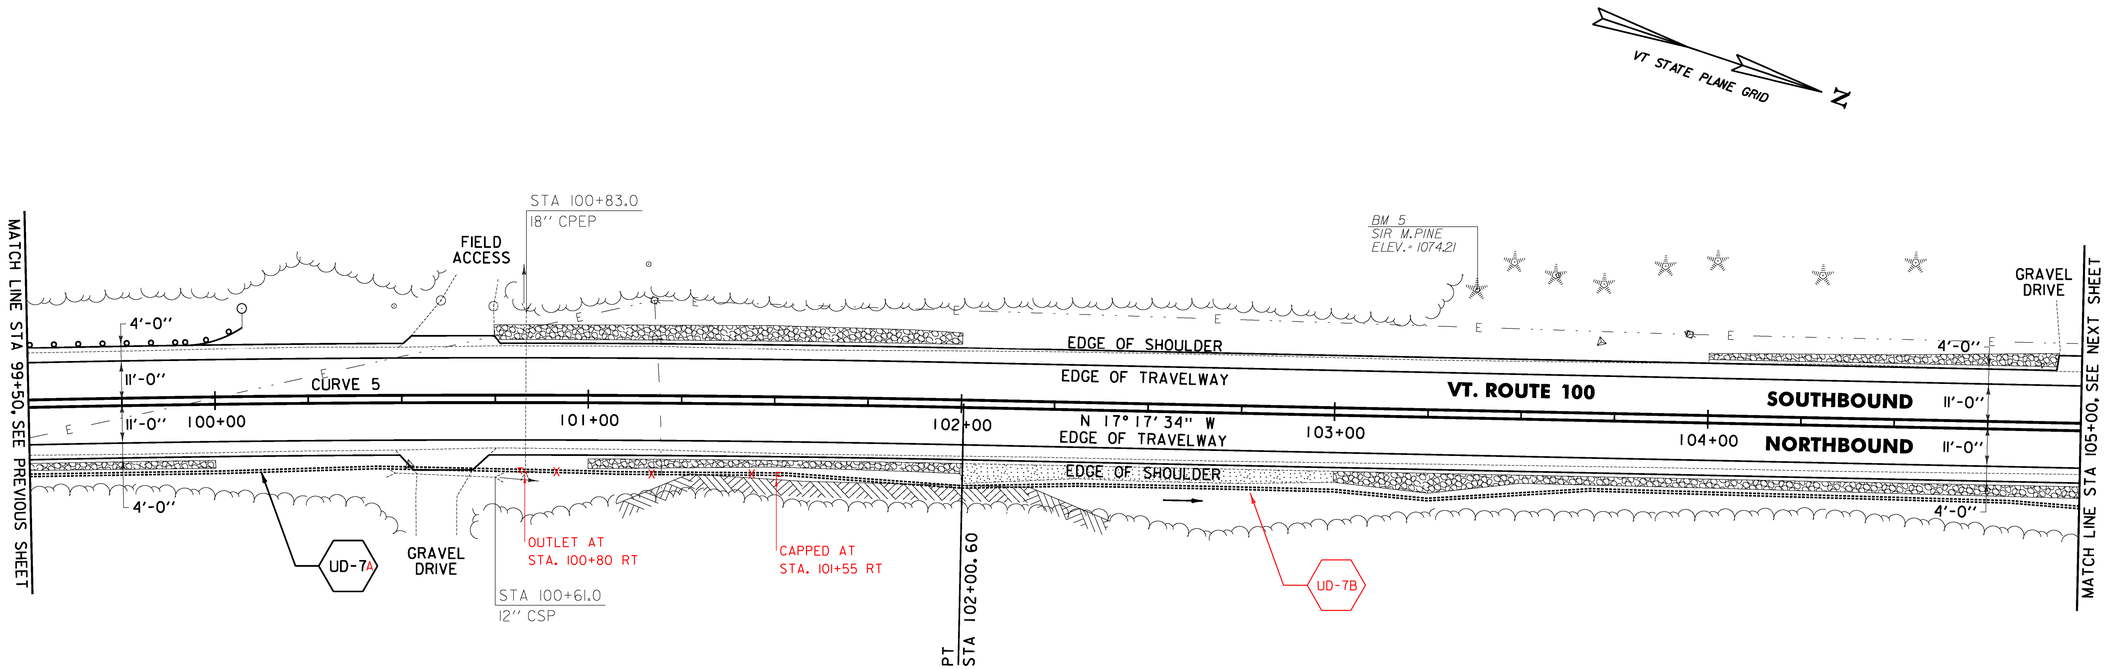

613.10 STONE FILL, TYPE I
WARREN:
STA 99+50.0 - STA 100+00.0 RT (5.1 CY)
STA 100+75.0 - STA 102+00.0 LT (26.7 CY)
STA 101+00.0 - STA 102+00.0 RT (10.8 CY)
STA 103+00.0 - STA 105+00.0 RT (27.6 CY)
STA 104+00.0 - STA 104+93.0 LT (5.4 CY)

621.80 REMOVAL AND DISPOSAL OF GUARDRAIL
WARREN:
STA 99+50.0 - STA 99+94.0 LT (44.0 LF)

651.40 GRUBBING MATERIAL
WARREN:
STA 99+50.0 - STA 100+00.0 RT (14.5 SY)
STA 100+75.0 - STA 102+00.0 LT (77.9 SY)
STA 101+00.0 - STA 102+00.0 RT (30.9 SY)
STA 102+00.0 - STA 103+00.0 RT (44.2 SY)
STA 103+00.0 - STA 105+00.0 RT (80.1 SY)
STA 104+00.0 - STA 104+93.0 LT (31.3 SY)

653.20 TEMPORARY EROSION MATTING
WARREN:
STA 99+50.0 - STA 100+00.0 RT (14.5 SY)
STA 100+75.0 - STA 102+00.0 LT (77.9 SY)
STA 101+00.0 - STA 102+00.0 RT (30.9 SY)
STA 102+00.0 - STA 103+00.0 RT (44.2 SY)
STA 103+00.0 - STA 105+00.0 RT (80.1 SY)
STA 104+00.0 - STA 104+93.0 LT (31.3 SY)

676.10 DELINEATOR WITH STEEL POST
WARREN:
STA 100+07.5 LT

649.31 GEOTEXTILE UNDER STONE FILL
WARREN:
STA 99+50.0 - STA 100+00.0 RT (25.6 SY)
STA 100+75.0 - STA 102+00.0 LT (111.3 SY)
STA 101+00.0 - STA 102+00.0 RT (53.1 SY)
STA 103+00.0 - STA 105+00.0 RT (124.6 SY)
STA 104+00.0 - STA 104+93.0 LT (53.6 SY)

900.640 SPECIAL PROVISION (BOX BEAM GUARDRAIL W/7 FEET POSTS)
WARREN:
STA 99+50.0 - STA 100+07.5 LT (57.5 LF)

CURVE 5
△ = 6° 27' 00"
D = 0° 57' 18"
R = 6000.00'
T = 338.09'
L = 675.46'
E = 9.52'
e = 0.020 FT/FT

SIGN LEGEND
R = REMOVE
S = SALVAGE
N = NEW
RET = RETAIN
B-B = BACK TO BACK
EXISTING = ----------
NEW = ————
Ⓣ = RETURN TO THE TOWN OF WARREN

LEGEND
ITEM 613.10 STONE FILL, TYPE I
ITEM 653.20 TEMPORARY EROSION MATTING

0 20 40
SCALE IN FEET

PROJECT LAYOUT SHEET #11

PROJECT NAME: WARREN - WAITSFIELD
PROJECT NUMBER: STP 2506(I)

FILE NAME: p05b048.dgn	PLOT DATE: 12/20/2012
PROJECT LEADER: D.E.G.	DRAWN BY: W.G.P.
DESIGNED BY: M.J.M.	CHECKED BY: D.E.G.
IPARM FILE: p05b048III.i	SHEET 37 OF 310

FILE NAME = U:\1762\CADD\MSTN\STP 2506\p05b048_Contract Plans.dgn
DATE/TIME = 12/20/2012
USER = 4065