646.402 DURABLE 4 INCH WHITE LINE, THERMOPLASTIC OR
646.403 DURABLE 4 INCH WHITE LINE, EPOXY PAINT OR
646.404 DURABLE 4 INCH WHITE LINE, POLYUREA
(ALL LINES WILL INCLUDE EDGE LINE BREAKS AND RADII FOR TOWN HIGHWAYS)
WARREN:
STA 116+00.00 - STA 121+50.00 LT & RT

646.412 DURABLE 4 INCH YELLOW LINE, THERMOPLASTIC OR
646.413 DURABLE 4 INCH YELLOW LINE, EPOXY PAINT OR
646.414 DURABLE 4 INCH YELLOW LINE, POLYUREA
(ALL LINES WILL INCLUDE C/L BREAKS FOR TOWN HIGHWAYS) S=SOLID, D=DASHED

WARREN:	LT	℄	RT
STA 116+00.00 - STA 121+50.00	S	-	S

646.602 TEMPORARY 4 INCH WHITE LINE, PAINT
(ALL LINES WILL INCLUDE EDGE LINE BREAKS AND RADII FOR TOWN HIGHWAYS)
WARREN:
STA 116+00.00 - STA 121+50.00 LT & RT

646.612 TEMPORARY 4 INCH YELLOW LINE, PAINT
(ALL LINES WILL INCLUDE C/L BREAKS FOR TOWN HIGHWAYS) S=SOLID, D=DASHED

WARREN:	LT	℄	RT
STA 116+00.00 - STA 121+50.00	S	-	S

675.50 REMOVING SIGNS
AS SHOWN - 2

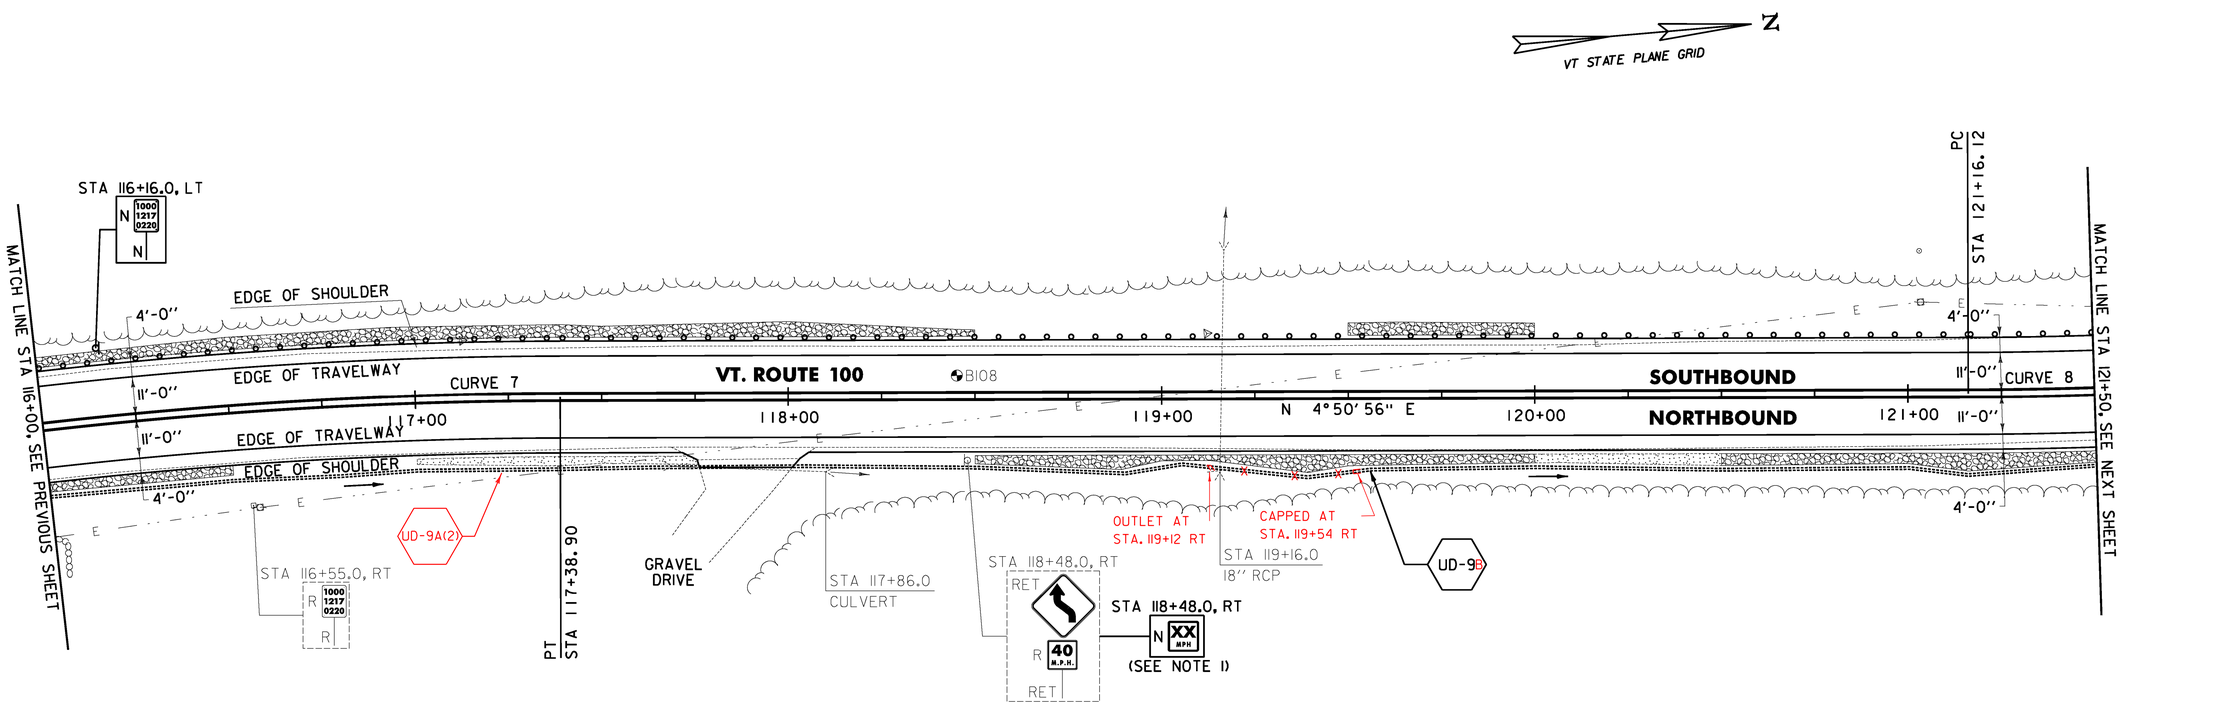

613.10 STONE FILL, TYPE I
WARREN:
STA 116+00.0 - STA 116+50.0 RT (1.8 CY)
STA 116+00.0 - STA 118+50.0 LT (41.7 CY)
STA 118+50.0 - STA 120+00.0 RT (14.2 CY)
STA 119+50.0 - STA 120+00.0 LT (7.5 CY)
STA 120+50.0 - STA 121+50.0 RT (10.9 CY)

621.80 REMOVAL AND DISPOSAL OF GUARDRAIL
WARREN:
STA 116+00.0 - 120+46.0 LT (446.0 LF)

651.40 GRUBBING MATERIAL
WARREN:
STA 116+00.0 - STA 116+50.0 RT (9.5 SY)
STA 116+00.0 - STA 118+50.0 LT (121.4 SY)
STA 117+00.0 - STA 117+72.0 RT (23.3 SY)
STA 118+50.0 - STA 120+00.0 RT (48.5 SY)
STA 119+50.0 - STA 120+00.0 LT (21.6 SY)
STA 120+00.0 - STA 120+50.0 RT (18.1 SY)
STA 120+50.0 - STA 121+50.0 RT (41.9 SY)

653.20 TEMPORARY EROSION MATTING
WARREN:
STA 116+00.0 - STA 116+50.0 RT (9.5 SY)
STA 116+00.0 - STA 118+50.0 LT (121.4 SY)
STA 117+00.0 - STA 117+72.0 RT (23.3 SY)
STA 118+50.0 - STA 120+00.0 RT (48.5 SY)
STA 119+50.0 - STA 120+00.0 LT (21.6 SY)
STA 120+00.0 - STA 120+50.0 RT (18.1 SY)
STA 120+50.0 - STA 121+50.0 RT (41.9 SY)

900.640 SPECIAL PROVISION (BOX BEAM GUARDRAIL W/7 FEET POSTS)
WARREN:
STA 116+00.0 - 121+50.0 LT (550.0 LF)

649.31 GEOTEXTILE UNDER STONE FILL
WARREN:
STA 116+00.0 - STA 116+50.0 RT (20.6 SY)
STA 116+00.0 - STA 118+50.0 LT (176.9 SY)
STA 118+50.0 - STA 120+00.0 RT (81.9 SY)
STA 119+50.0 - STA 120+00.0 LT (32.7 SY)
STA 120+50.0 - STA 121+50.0 RT (64.1 SY)

SOIL BORING DATA			
BORING #	DEPTH (FT.)	PCC	COMMENTS
B108	5.0	NO	

NOTE:
1. THE ADVISORY SPEED SHALL BE DETERMINED USING AN ESTABLISHED ENGINEERING PRACTICE AS LISTED IN SECTION 2C.08 OF THE MUTCD.

CURVE 7
△ = 15° 40' 28"
D = 4° 35' 01"
R = 1250.00'
T = 172.06'
L = 341.96'
E = 11.79'
e = 0.069 FT/FT

CURVE 8
△ = 28° 59' 59"
D = 4° 51' 20"
R = 1180.00'
T = 305.17'
L = 597.25'
E = 38.82'
e = 0.071 FT/FT

SIGN LEGEND
R = REMOVE
S = SALVAGE
N = NEW
RET = RETAIN
B-B = BACK TO BACK
EXISTING = ----------
NEW = ————
① = RETURN TO THE TOWN OF WARREN

LEGEND
ITEM 613.10 STONE FILL, TYPE I
ITEM 653.20 TEMPORARY EROSION MATTING

0 20 40
SCALE IN FEET

PROJECT LAYOUT SHEET #14

PROJECT NAME: WARREN - WAITSFIELD
PROJECT NUMBER: STP 2506(1)
FILE NAME: p05b048.dgn
PROJECT LEADER: D.E.G.
DESIGNED BY: M.J.M.
IPARM FILE: p05b048114.i
PLOT DATE: 12/20/2012
DRAWN BY: W.G.P.
CHECKED BY: D.E.G.
SHEET 40 OF 310

FILE NAME = U:\7762\CADD\MSTN\STP 2506\p05b048_Contract Plans.dgn
DATE/TIME = 12/20/2012
USER = mgs