646.402 DURABLE 4 INCH WHITE LINE, THERMOPLASTIC OR
646.403 DURABLE 4 INCH WHITE LINE, EPOXY PAINT OR
646.404 DURABLE 4 INCH WHITE LINE, POLYUREA
(ALL LINES WILL INCLUDE EDGE LINE BREAKS AND RADII FOR TOWN HIGHWAYS)
WARREN:
STA 127+00.00 - STA 132+00.00 LT & RT

646.412 DURABLE 4 INCH YELLOW LINE, THERMOPLASTIC OR
646.413 DURABLE 4 INCH YELLOW LINE, EPOXY PAINT OR
646.414 DURABLE 4 INCH YELLOW LINE, POLYUREA
(ALL LINES WILL INCLUDE C/L BREAKS FOR TOWN HIGHWAYS) S=SOLID, D=DASHED
WARREN:

	LT	℄	RT
STA 127+00.00 - STA 132+00.00	S	-	S

646.602 TEMPORARY 4 INCH WHITE LINE, PAINT
(ALL LINES WILL INCLUDE EDGE LINE BREAKS AND RADII FOR TOWN HIGHWAYS)
WARREN:
STA 127+00.00 - STA 132+00.00 LT & RT

646.612 TEMPORARY 4 INCH YELLOW LINE, PAINT
(ALL LINES WILL INCLUDE C/L BREAKS FOR TOWN HIGHWAYS) S=SOLID, D=DASHED
WARREN:

	LT	℄	RT
STA 127+00.00 - STA 132+00.00	S	-	S

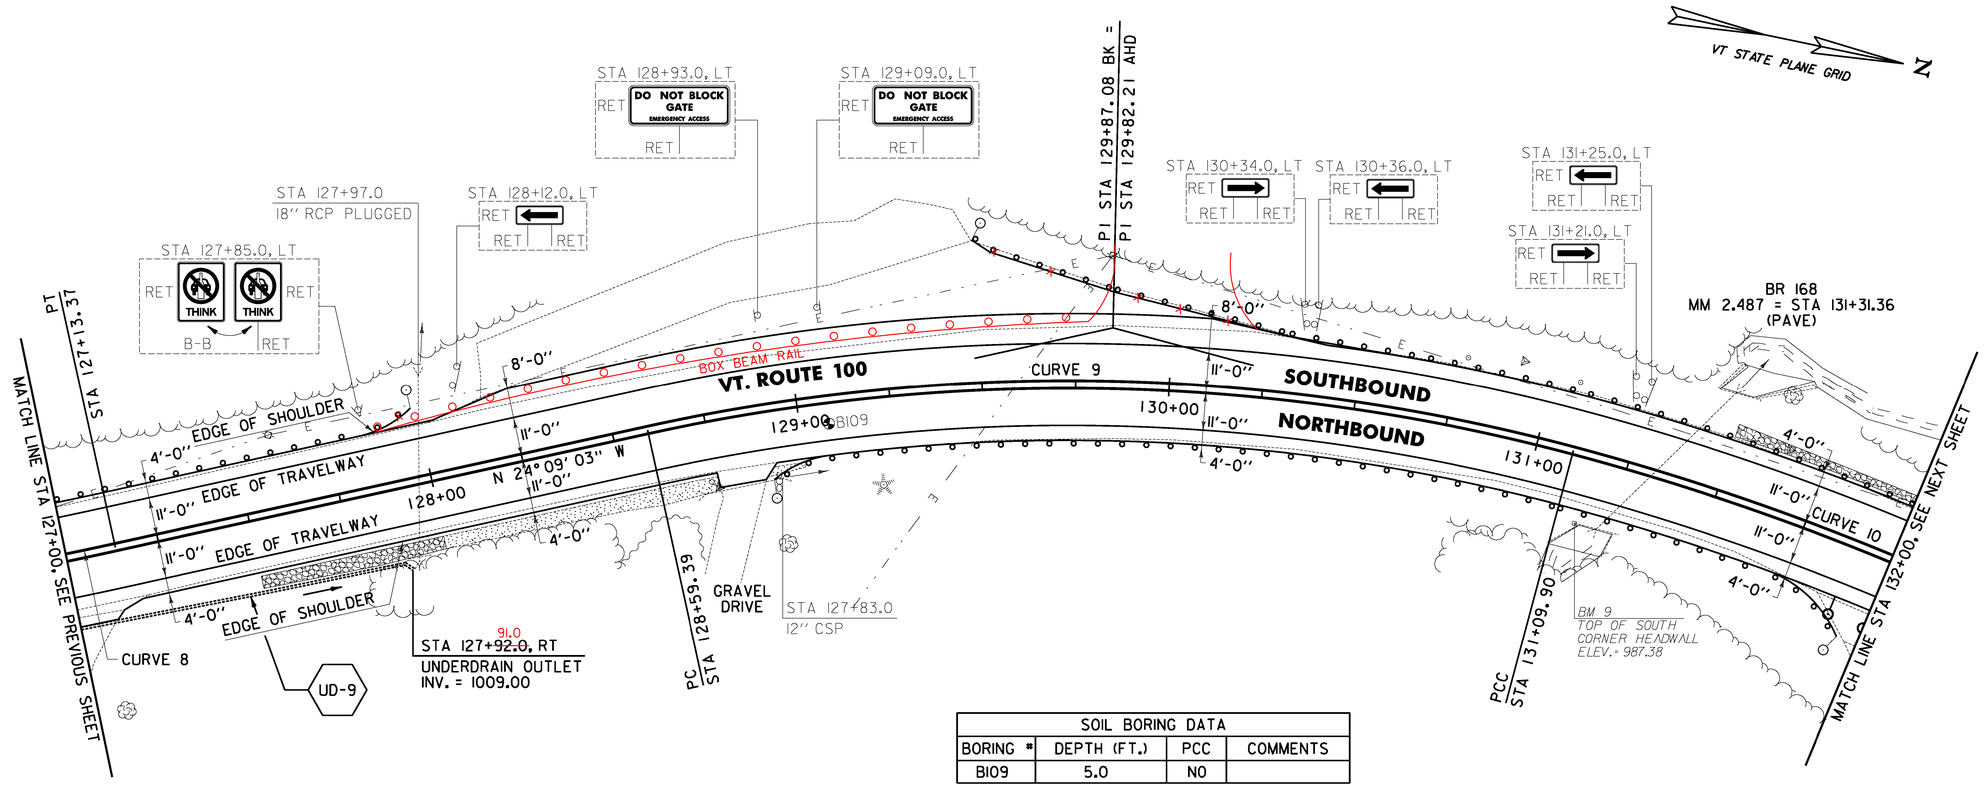

SOIL BORING DATA			
BORING #	DEPTH (FT.)	PCC	COMMENTS
B109	5.0	NO	

613.10 STONE FILL, TYPE I
WARREN:
STA 127+50.0 - STA 128+00.0 RT (7.9 CY)
STA 131+50.0 - STA 132+00.0 LT (2.6 CY)

621.80 REMOVAL AND DISPOSAL OF GUARDRAIL
WARREN:
STA 129+25.0 - STA 131+90.0 RT (265.0 LF)
STA 129+48.0 - STA 132+00.0 LT (267.0 LF)

651.40 GRUBBING MATERIAL
WARREN:
STA 127+50.0 - STA 128+00.0 RT (22.9 SY)
STA 128+00.0 - STA 128+75.0 RT (30.0 SY)
STA 128+91.0 - STA 129+00.0 RT (10.3 SY)
STA 131+50.0 - STA 132+00.0 LT (18.3 SY)

653.20 TEMPORARY EROSION MATTING
WARREN:
STA 127+50.0 - STA 128+00.0 RT (22.9 SY)
STA 128+00.0 - STA 128+75.0 RT (30.0 SY)
STA 128+91.0 - STA 129+00.0 RT (10.3 SY)
STA 131+50.0 - STA 132+00.0 LT (18.3 SY)

676.10 DELINEATOR WITH STEEL POST
WARREN:
STA 127+98.5 LT
STA 128+91.0 RT
STA 129+48.0 LT
STA 131+90.0 RT
STA 131+97.0 RT
STA 132+00.0 RT

649.31 GEOTEXTILE UNDER STONE FILL
WARREN:
STA 127+50.0 - STA 128+00.0 RT (34.0 SY)
STA 131+50.0 - STA 132+00.0 LT (29.4 SY)

900.640 SPECIAL PROVISION (BOX BEAM GUARDRAIL W/7 FEET POSTS)
WARREN:
STA 127+00.0 - STA 127+98.5 LT (98.5 LF)
STA 128+91.0 - STA 131+97.0 RT (306.0 LF)
STA 129+48.0 - STA 132+00.0 LT (267.0 LF)

CURVE 8
Δ = 28° 59' 59"
D = 4° 51' 20"
R = 1180.00'
T = 305.17'
L = 597.25'
E = 38.82'
e = 0.071 FT/FT

CURVE 9
Δ = 27° 20' 21"
D = 10° 54' 49"
R = 525.00'
T = 127.69'
L = 250.51'
E = 15.30'
e = 0.080 FT/FT

CURVE 10
Δ = 17° 03' 44"
D = 8° 29' 18"
R = 675.00'
T = 101.25'
L = 201.01'
E = 7.55'
e = 0.080 FT/FT

SIGN LEGEND
R = REMOVE
S = SALVAGE
N = NEW
RET = RETAIN
B-B = BACK TO BACK
EXISTING = ----------
NEW = ————
① = RETURN TO THE TOWN OF WARREN

LEGEND
ITEM 613.10 STONE FILL, TYPE I
ITEM 653.20 TEMPORARY EROSION MATTING

0 20 40
SCALE IN FEET

PROJECT LAYOUT SHEET #16

PROJECT NAME: WARREN - WAITSFIELD
PROJECT NUMBER: STP 2506(1)
FILE NAME: p05b048.dgn
PROJECT LEADER: D.E.G.
DESIGNED BY: M.J.M.
IPARM FILE: p05b048116.i
PLOT DATE: 12/20/2012
DRAWN BY: W.G.P.
CHECKED BY: D.E.G.
SHEET 42 OF 310

FILE NAME = U:\1762\CADD\MSTN\STP 2506\p05b048_Contract Plans.dgn
DATE/TIME = 12/20/2012
USER = 4965