646.402 DURABLE 4 INCH WHITE LINE, THERMOPLASTIC OR
646.403 DURABLE 4 INCH WHITE LINE, EPOXY PAINT OR
646.404 DURABLE 4 INCH WHITE LINE, POLYUREA
(ALL LINES WILL INCLUDE EDGE LINE BREAKS AND RADII FOR TOWN HIGHWAYS)
WARREN:
STA 132+00.00 - STA 137+50.00 LT & RT

646.412 DURABLE 4 INCH YELLOW LINE, THERMOPLASTIC OR
646.413 DURABLE 4 INCH YELLOW LINE, EPOXY PAINT OR
646.414 DURABLE 4 INCH YELLOW LINE, POLYUREA
(ALL LINES WILL INCLUDE C/L BREAKS FOR TOWN HIGHWAYS) S=SOLID, D=DASHED

WARREN:	LT	℄	RT
STA 132+00.00 - STA 137+50.00	S	-	S

646.602 TEMPORARY 4 INCH WHITE LINE, PAINT
(ALL LINES WILL INCLUDE EDGE LINE BREAKS AND RADII FOR TOWN HIGHWAYS)
WARREN:
STA 132+00.00 - STA 137+50.00 LT & RT

646.612 TEMPORARY 4 INCH YELLOW LINE, PAINT
(ALL LINES WILL INCLUDE C/L BREAKS FOR TOWN HIGHWAYS) S=SOLID, D=DASHED

WARREN:	LT	℄	RT
STA 132+00.00 - STA 137+50.00	S	-	S

675.50 REMOVING SIGNS
AS SHOWN - 3

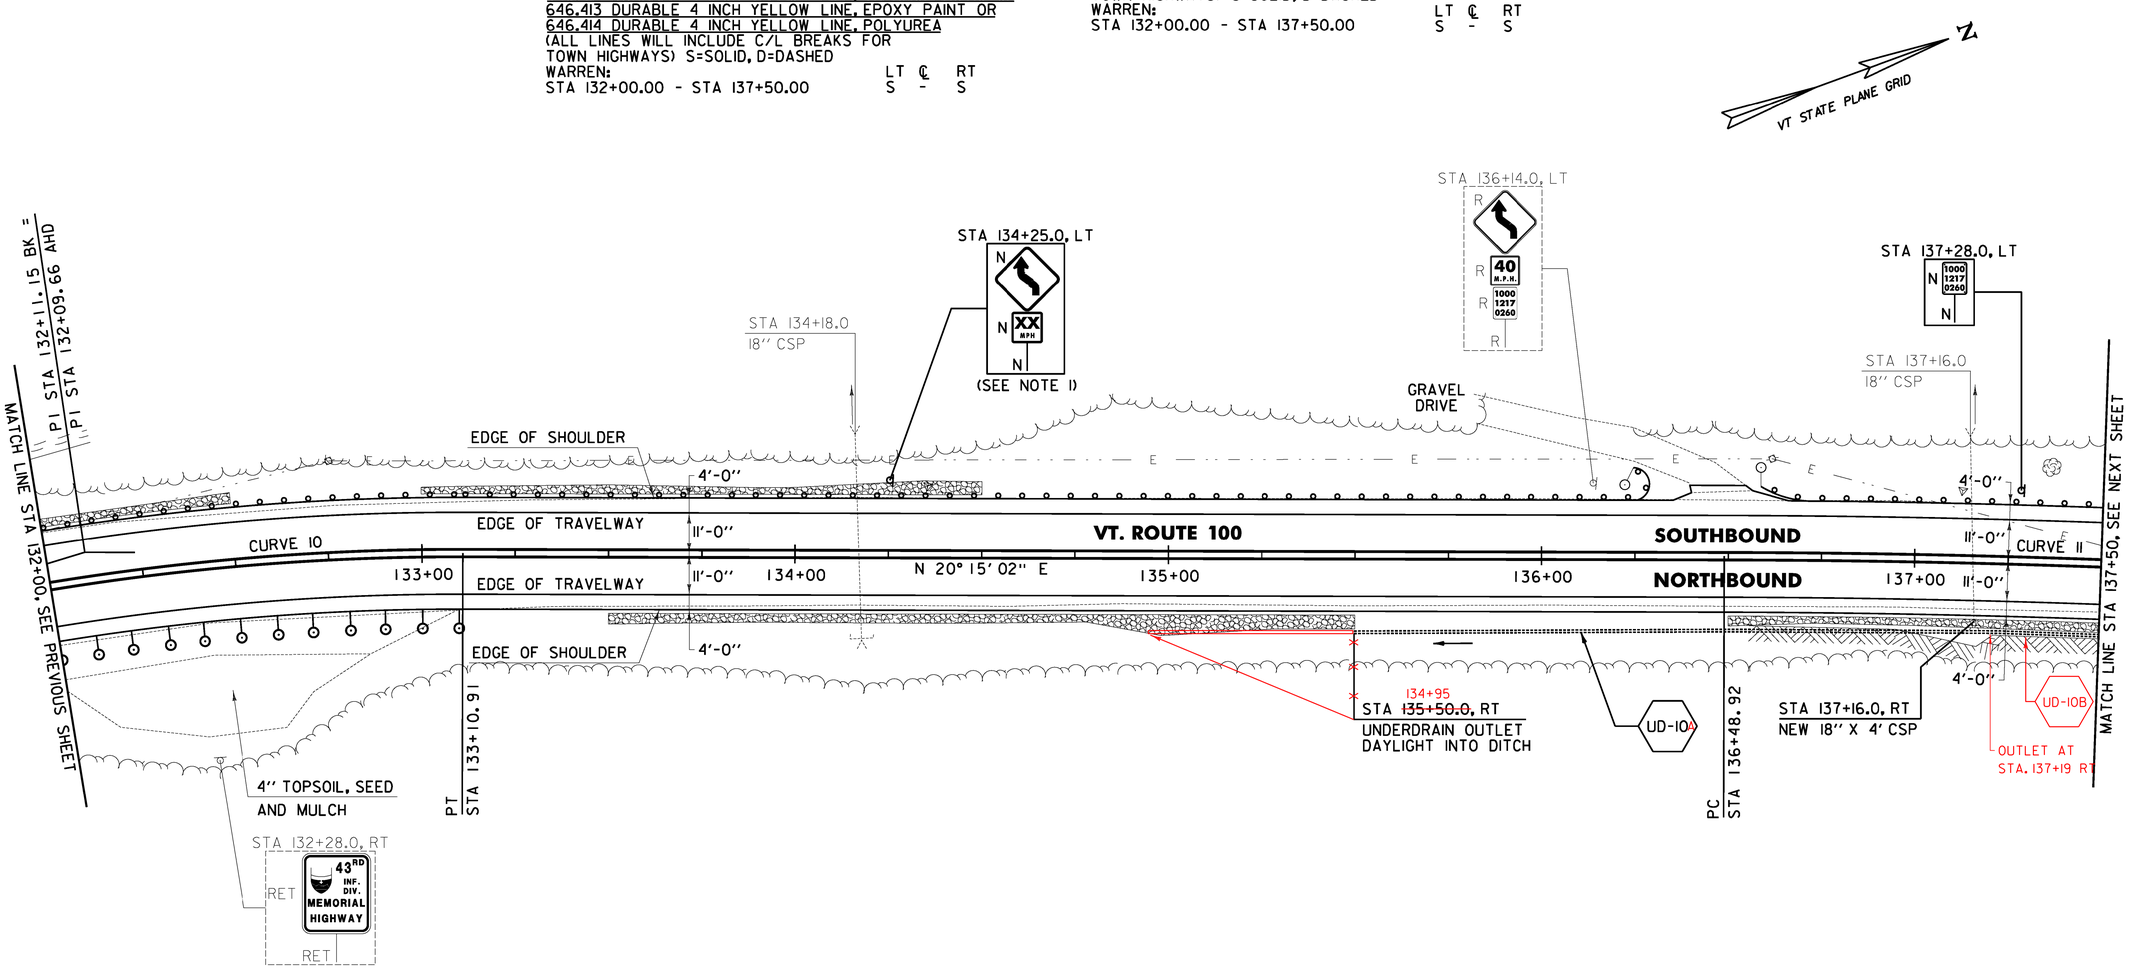

613.10 STONE FILL, TYPE I
WARREN:
STA 132+00.0 - STA 132+50.0 LT (2.6 CY)
STA 133+00.0 - STA 134+50.0 LT (17.1CY)
STA 133+50.0 - STA 135+50.0 RT (33.1CY)
STA 136+50.0 - STA 137+50.0 RT (12.1CY)

621.80 REMOVAL AND DISPOSAL OF GUARDRAIL
WARREN:
STA 132+00.0 - STA 136+26.0 LT (426.0 LF)
STA 136+59.0 - STA 137+50.0 LT (91.0 LF)

651.40 GRUBBING MATERIAL
WARREN:
STA 132+00.0 - STA 132+50.0 LT (16.6 SY)
STA 133+00.0 - STA 134+50.0 LT (49.2 SY)
STA 133+50.0 - STA 135+50.0 RT (96.5 SY)
STA 136+50.0 - STA 137+50.0 RT (35.0 SY)

653.20 TEMPORARY EROSION MATTING
WARREN:
STA 132+00.0 - STA 132+50.0 LT (16.6 SY)
STA 133+00.0 - STA 134+50.0 LT (49.2 SY)
STA 133+50.0 - STA 135+50.0 RT (96.5 SY)
STA 136+50.0 - STA 137+50.0 RT (35.0 SY)

676.10 DELINEATOR WITH STEEL POST
WARREN:
STA 132+10.0 RT
STA 132+20.0 RT
STA 132+30.0 RT
STA 132+40.0 RT
STA 132+50.0 RT
STA 132+60.0 RT
STA 132+70.0 RT
STA 132+80.0 RT
STA 132+90.0 RT
STA 133+00.0 RT
STA 133+10.0 RT
STA 136+27.0 LT
STA 136+59.0 LT

649.31 GEOTEXTILE UNDER STONE FILL
WARREN:
STA 132+00.0 - STA 132+50.0 LT (27.8 SY)
STA 133+00.0 - STA 134+50.0 LT (82.5 SY)
STA 133+50.0 - STA 135+50.0 RT (140.9 SY)
STA 136+50.0 - STA 137+50.0 RT (57.2 SY)

900.640 SPECIAL PROVISION (BOX BEAM GUARDRAIL W/7 FEET POSTS)
WARREN:
STA 132+00.0 - STA 136+27.0 LT (427.0 LF)
STA 136+59.0 - STA 137+50.0 LT (91.0 LF)

NOTE:

1. THE ADVISORY SPEED SHALL BE DETERMINED USING AN ESTABLISHED ENGINEERING PRACTICE AS LISTED IN SECTION 2C.08 OF THE MUTCD.

CURVE 10		CURVE 11	
Δ	= 17° 03' 44"	Δ	= 7° 30' 14"
D	= 8° 29' 18"	D	= 1° 52' 43"
R	= 675.00'	R	= 3050.00'
T	= 101.25'	T	= 200.01'
L	= 201.01'	L	= 399.45'
E	= 7.55'	E	= 6.55'
e	= 0.080 FT/FT	e	= 0.037 FT/FT

SIGN LEGEND
R = REMOVE
S = SALVAGE
N = NEW
RET = RETAIN
B-B = BACK TO BACK
EXISTING = ----------
NEW = ——————
Ⓣ = RETURN TO THE TOWN OF WARREN

LEGEND
ITEM 613.10 STONE FILL, TYPE I
ITEM 653.20 TEMPORARY EROSION MATTING

0 20 40
SCALE IN FEET

PROJECT LAYOUT SHEET #17

PROJECT NAME: WARREN - WAITSFIELD
PROJECT NUMBER: STP 2506(1)

FILE NAME: p05b048.dgn
PROJECT LEADER: D.E.G.
DESIGNED BY: M.J.M.
IPARM FILE: p05b048117.1
PLOT DATE: 12/20/2012
DRAWN BY: W.G.P.
CHECKED BY: D.E.G.
SHEET 43 OF 310

FILE NAME = U:\1776\CADD\MSTN\STP 2506\p05b048_Contract Plans.dgn
DATE/TIME = 12/20/2012
USER = 4065