646.402 DURABLE 4 INCH WHITE LINE, THERMOPLASTIC OR
646.403 DURABLE 4 INCH WHITE LINE, EPOXY PAINT OR
646.404 DURABLE 4 INCH WHITE LINE, POLYUREA
(ALL LINES WILL INCLUDE EDGE LINE BREAKS AND RADII FOR TOWN HIGHWAYS)
WARREN:
STA 143+00.00 - STA 148+50.00 LT & RT

646.412 DURABLE 4 INCH YELLOW LINE, THERMOPLASTIC OR
646.413 DURABLE 4 INCH YELLOW LINE, EPOXY PAINT OR
646.414 DURABLE 4 INCH YELLOW LINE, POLYUREA
(ALL LINES WILL INCLUDE C/L BREAKS FOR TOWN HIGHWAYS) S=SOLID, D=DASHED

| WARREN: | LT | ℄ | RT |
|---|---|---|---|
| STA 143+00.00 - STA 148+50.00 | S | - | S |

646.602 TEMPORARY 4 INCH WHITE LINE, PAINT
(ALL LINES WILL INCLUDE EDGE LINE BREAKS AND RADII FOR TOWN HIGHWAYS)
WARREN:
STA 143+00.00 - STA 148+50.00 LT & RT

646.612 TEMPORARY 4 INCH YELLOW LINE, PAINT
(ALL LINES WILL INCLUDE C/L BREAKS FOR TOWN HIGHWAYS) S=SOLID, D=DASHED

| WARREN: | LT | ℄ | RT |
|---|---|---|---|
| STA 143+00.00 - STA 148+50.00 | S | - | S |

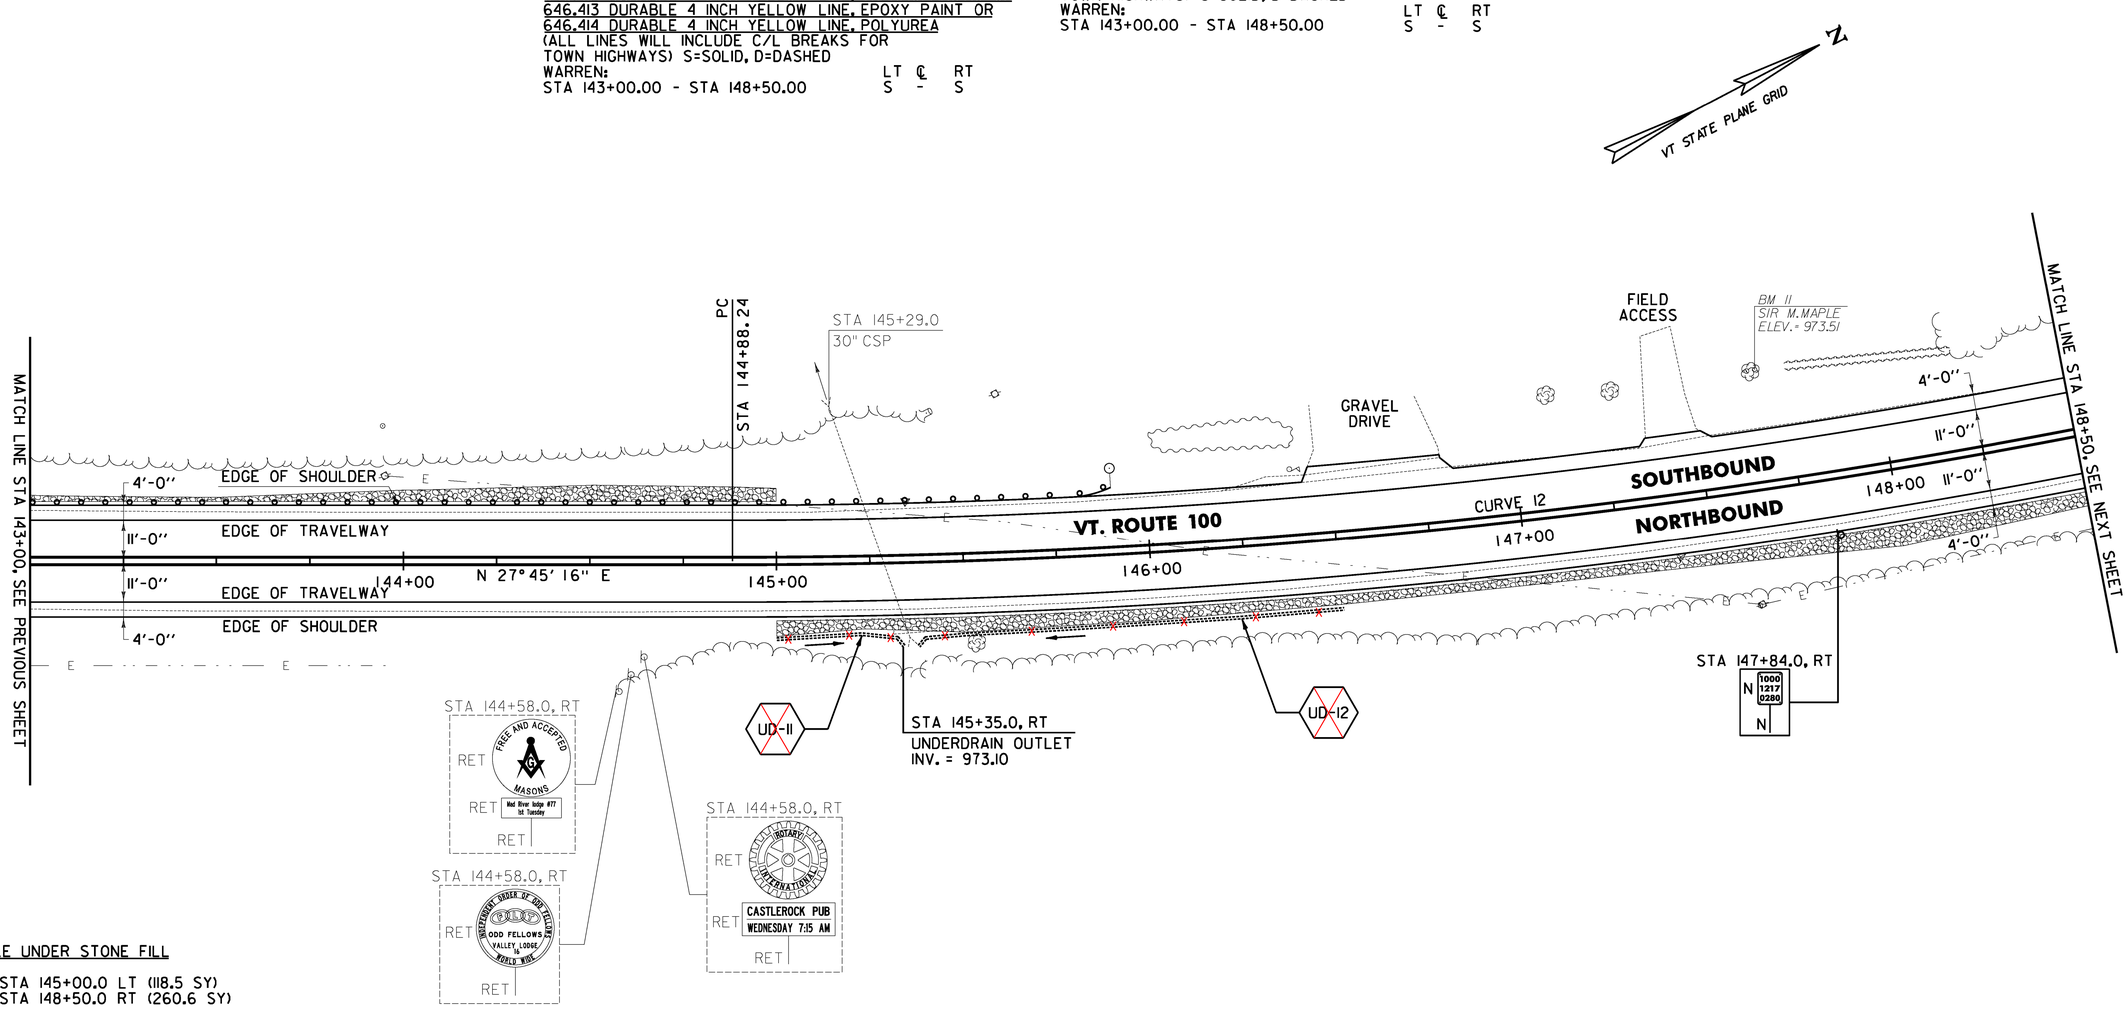


649.31 GEOTEXTILE UNDER STONE FILL
WARREN:
STA 143+00.0 - STA 145+00.0 LT (118.5 SY)
STA 145+00.0 - STA 148+50.0 RT (260.6 SY)

613.10 STONE FILL, TYPE I
WARREN:
STA 143+00.0 - STA 145+00.0 LT (25.6 CY)
STA 145+00.0 - STA 148+50.0 RT (62.6 CY)

621.80 REMOVAL AND DISPOSAL OF GUARDRAIL
WARREN:
STA 143+00.0 - STA 145+83.0 LT (283.0 LF)

651.40 GRUBBING MATERIAL
WARREN:
STA 143+00.0 - STA 145+00.0 LT (74.1 SY)
STA 145+00.0 - STA 148+50.0 RT (182.8 SY)

653.20 TEMPORARY EROSION MATTING
WARREN:
STA 143+00.0 - STA 145+00.0 LT (74.1 SY)
STA 145+00.0 - STA 148+50.0 RT (182.8 SY)

676.10 DELINEATOR WITH STEEL POST
WARREN:
STA 145+90.5 LT

900.640 SPECIAL PROVISION (BOX BEAM GUARDRAIL W/7 FEET POSTS)
WARREN:
STA 143+00.0 - STA 145+90.5 LT (290.5 LF)

CURVE 12
△ = 28° 43' 16"
D = 3° 00' 56"
R = 1900.00'
T = 486.44'
L = 952.43'
E = 61.28'
e = 0.053 FT/FT

SIGN LEGEND
R = REMOVE
S = SALVAGE
N = NEW
RET = RETAIN
B-B = BACK TO BACK
EXISTING = ----------
NEW = ——————
Ⓡ = RETURN TO THE TOWN OF WARREN

LEGEND
ITEM 613.10 STONE FILL, TYPE I
ITEM 653.20 TEMPORARY EROSION MATTING

0 20 40
SCALE IN FEET

**PROJECT LAYOUT SHEET #19**

PROJECT NAME: WARREN - WAITSFIELD
PROJECT NUMBER: STP 2506(1)

| | |
|---|---|
| FILE NAME: p05b048.dgn | PLOT DATE: 12/20/2012 |
| PROJECT LEADER: D.E.G. | DRAWN BY: W.G.P. |
| DESIGNED BY: M.J.M. | CHECKED BY: D.E.G. |
| IPARM FILE: p05b048119.i | SHEET 45 OF 310 |

FILE NAME = U:\1762\CADD\MSTN\STP 2506\p05b048_Contract Plans.dgn
DATE/TIME = 12/20/2012
USER = wgp