646.402 DURABLE 4 INCH WHITE LINE, THERMOPLASTIC OR
646.403 DURABLE 4 INCH WHITE LINE, EPOXY PAINT OR
646.404 DURABLE 4 INCH WHITE LINE, POLYUREA
(ALL LINES WILL INCLUDE EDGE LINE BREAKS AND RADII FOR TOWN HIGHWAYS)
WARREN:
STA 148+50.00 - STA 154+00.00 LT & RT

646.412 DURABLE 4 INCH YELLOW LINE, THERMOPLASTIC OR
646.413 DURABLE 4 INCH YELLOW LINE, EPOXY PAINT OR
646.414 DURABLE 4 INCH YELLOW LINE, POLYUREA
(ALL LINES WILL INCLUDE C/L BREAKS FOR TOWN HIGHWAYS) S=SOLID, D=DASHED

| WARREN: | LT | ℄ | RT |
|---|---|---|---|
| STA 148+50.00 - STA 154+00.00 | S | - | S |

646.602 TEMPORARY 4 INCH WHITE LINE, PAINT
(ALL LINES WILL INCLUDE EDGE LINE BREAKS AND RADII FOR TOWN HIGHWAYS)
WARREN:
STA 148+50.00 - STA 154+00.00 LT & RT

646.612 TEMPORARY 4 INCH YELLOW LINE, PAINT
(ALL LINES WILL INCLUDE C/L BREAKS FOR TOWN HIGHWAYS) S=SOLID, D=DASHED

| WARREN: | LT | ℄ | RT |
|---|---|---|---|
| STA 148+50.00 - STA 154+00.00 | S | - | S |

N
VT STATE PLANE GRID

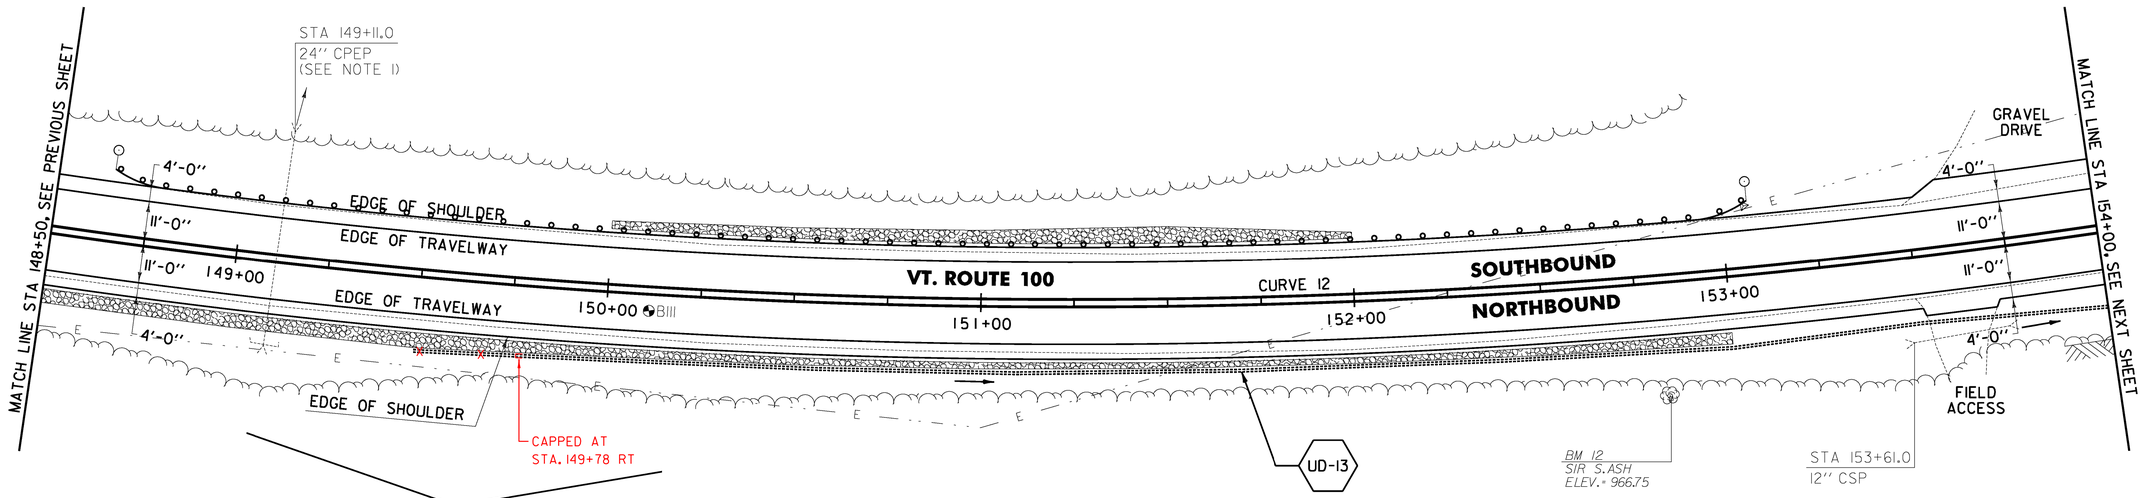


649.31 GEOTEXTILE UNDER STONE FILL
WARREN:
STA 148+50.0 - STA 153+00.0 RT (278.5 SY)
STA 150+00.0 - STA 152+00.0 LT (128.6 SY)

613.10 STONE FILL, TYPE I
WARREN:
STA 148+50.0 - STA 153+00.0 RT (61.5 CY)
STA 150+00.0 - STA 152+00.0 LT (29.0 CY)

621.80 REMOVAL AND DISPOSAL OF GUARDRAIL
WARREN:
STA 148+77.0 - STA 152+96.0 LT (419.0 LF)

651.40 GRUBBING MATERIAL
WARREN:
STA 148+50.0 - STA 153+00.0 RT (178.5 SY)
STA 150+00.0 - STA 152+00.0 LT (84.2 SY)

653.20 TEMPORARY EROSION MATTING
WARREN:
STA 148+50.0 - STA 153+00.0 RT (178.5 SY)
STA 150+00.0 - STA 152+00.0 LT (84.2 SY)

676.10 DELINEATOR WITH STEEL POST
WARREN:
STA 148+65.0 LT
STA 153+07.0 LT

900.640 SPECIAL PROVISION (BOX BEAM GUARDRAIL W/7 FEET POSTS)
WARREN:
STA 148+65.0 - STA 153+07.0 LT (442.0 LF)

| SOIL BORING DATA | | | |
|---|---|---|---|
| BORING # | DEPTH (FT.) | PCC | COMMENTS |
| BIII | 5.0 | NO | |

NOTE:

1. CONTRACTOR SHALL SPACE THE GUARDRAIL POST IN A MANNER THAT AVOIDS THE EXISTING CULVERT BELOW AS DIRECTED BY THE ENGINEER.

CURVE 12
△ = 28°43' 16"
D = 3°00' 56"
R = 1900.00'
T = 486.44'
L = 952.43'
E = 61.28'
e = 0.053 FT/FT

SIGN LEGEND
R = REMOVE
S = SALVAGE
N = NEW
RET = RETAIN
B-B = BACK TO BACK
EXISTING = ----------
NEW = ————
Ⓣ = RETURN TO THE TOWN OF WARREN

LEGEND
ITEM 613.10 STONE FILL, TYPE I
ITEM 653.20 TEMPORARY EROSION MATTING

0 20 40
SCALE IN FEET

**PROJECT LAYOUT SHEET #20**

PROJECT NAME: WARREN - WAITSFIELD
PROJECT NUMBER: STP 2506(1)
FILE NAME: p05b048.dgn
PROJECT LEADER: D.E.G.
DESIGNED BY: M.J.M.
IPARM FILE: p05b048120.i
PLOT DATE: 12/20/2012
DRAWN BY: W.G.P.
CHECKED BY: D.E.G.
SHEET 46 OF 310

FILE NAME = U:\1762\CADD\MSTN\STP 2506\p05b048_Contract Plans.dgn
DATE/TIME = 12/20/2012
USER = 1466