646.402 DURABLE 4 INCH WHITE LINE, THERMOPLASTIC OR
646.403 DURABLE 4 INCH WHITE LINE, EPOXY PAINT OR
646.404 DURABLE 4 INCH WHITE LINE, POLYUREA
(ALL LINES WILL INCLUDE EDGE LINE BREAKS AND RADII FOR TOWN HIGHWAYS)
WARREN:
STA 165+00.00 - STA 169+50.00 LT & RT

646.412 DURABLE 4 INCH YELLOW LINE, THERMOPLASTIC OR
646.413 DURABLE 4 INCH YELLOW LINE, EPOXY PAINT OR
646.414 DURABLE 4 INCH YELLOW LINE, POLYUREA
(ALL LINES WILL INCLUDE C/L BREAKS FOR TOWN HIGHWAYS) S=SOLID, D=DASHED
WARREN:
STA 165+00.00 - STA 169+50.00 LT ℄ RT S - S

646.602 TEMPORARY 4 INCH WHITE LINE, PAINT
(ALL LINES WILL INCLUDE EDGE LINE BREAKS AND RADII FOR TOWN HIGHWAYS)
WARREN:
STA 165+00.00 - STA 169+50.00 LT & RT

646.612 TEMPORARY 4 INCH YELLOW LINE, PAINT
(ALL LINES WILL INCLUDE C/L BREAKS FOR TOWN HIGHWAYS) S=SOLID, D=DASHED
WARREN:
STA 165+00.00 - STA 169+50.00 LT ℄ RT S - S

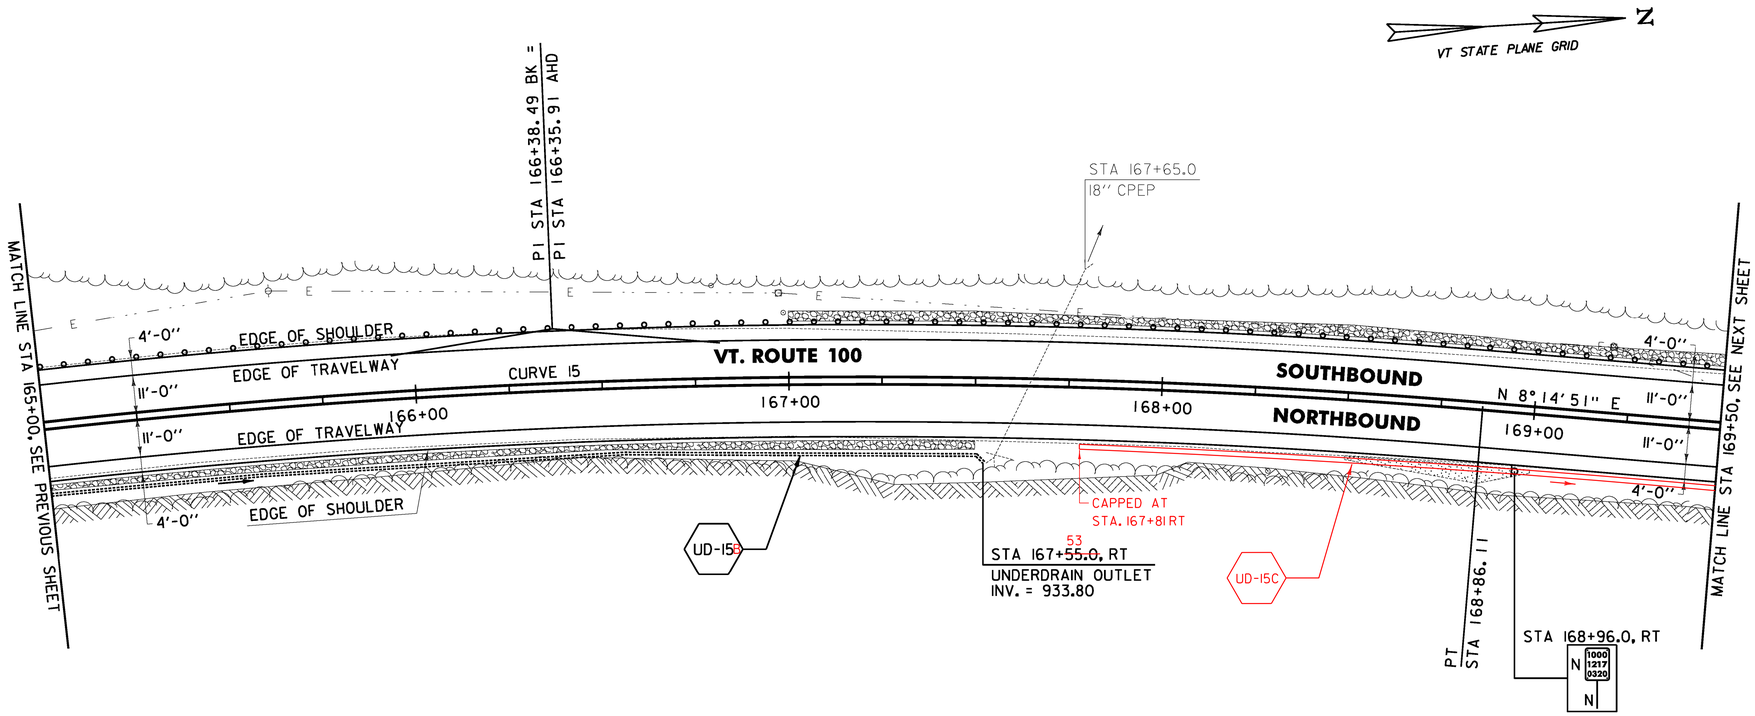

649.31 GEOTEXTILE UNDER STONE FILL
WARREN:
STA 165+00.0 - STA 167+50.0 RT (123.3 SY)
STA 167+00.0 - STA 169+50.0 LT (153.7 SY)

613.10 STONE FILL, TYPE I
WARREN:
STA 165+00.0 - STA 167+50.0 RT (23.7 CY)
STA 167+00.0 - STA 169+50.0 LT (33.9 CY)

621.80 REMOVAL AND DISPOSAL OF GUARDRAIL
WARREN:
STA 165+00.0 - STA 169+50.0 LT (450.0 LF)

651.40 GRUBBING MATERIAL
WARREN:
STA 165+00.0 - STA 167+50.0 RT (67.7 SY)
STA 167+00.0 - STA 169+50.0 LT (98.2 SY)
STA 168+50.0 - STA 169+00.0 RT (5.7 SY)

653.20 TEMPORARY EROSION MATTING
WARREN:
STA 165+00.0 - STA 167+50.0 RT (67.7 CY)
STA 167+00.0 - STA 169+50.0 LT (98.2 CY)
STA 168+50.0 - STA 169+00.0 RT (5.7 SY)

900.640 SPECIAL PROVISION (BOX BEAM GUARDRAIL W/7 FEET POSTS)
WARREN:
STA 165+00.0 - STA 169+50.0 LT (450.0 LF)

CURVE 15
Δ = 14°15'41"
D = 2°51'53"
R = 2000.00'
T = 250.20'
L = 497.82'
E = 15.59'
e = 0.051 FT/FT

SIGN LEGEND
R = REMOVE
S = SALVAGE
N = NEW
RET = RETAIN
B-B = BACK TO BACK
EXISTING = ----------
NEW = ————
① = RETURN TO THE TOWN OF WARREN

LEGEND
ITEM 613.10 STONE FILL, TYPE I
ITEM 653.20 TEMPORARY EROSION MATTING

0 20 40
SCALE IN FEET

PROJECT LAYOUT SHEET #23

PROJECT NAME: WARREN - WAITSFIELD
PROJECT NUMBER: STP 2506(1)
FILE NAME: p05b048.dgn
PROJECT LEADER: D.E.G.
DESIGNED BY: M.J.M.
IPARM FILE: p05b048123.i
PLOT DATE: 12/20/2012
DRAWN BY: W.G.P.
CHECKED BY: D.E.G.
SHEET 49 OF 310

FILE NAME = U:\17762\CADD\MSTN\STP 2506\p05b048_Contract Plans.dgn
DATE/TIME = 12/20/2012
USER = 4066