646.402 DURABLE 4 INCH WHITE LINE, THERMOPLASTIC OR
646.403 DURABLE 4 INCH WHITE LINE, EPOXY PAINT OR
646.404 DURABLE 4 INCH WHITE LINE, POLYUREA
(ALL LINES WILL INCLUDE EDGE LINE BREAKS AND RADII FOR TOWN HIGHWAYS)
WARREN:
STA 169+50.00 - STA 174+00.00 LT & RT

646.412 DURABLE 4 INCH YELLOW LINE, THERMOPLASTIC OR
646.413 DURABLE 4 INCH YELLOW LINE, EPOXY PAINT OR
646.414 DURABLE 4 INCH YELLOW LINE, POLYUREA
(ALL LINES WILL INCLUDE C/L BREAKS FOR TOWN HIGHWAYS) S=SOLID, D=DASHED

WARREN:	LT	℄	RT
STA 169+50.00 - STA 174+00.00	S	-	S

646.602 TEMPORARY 4 INCH WHITE LINE, PAINT
(ALL LINES WILL INCLUDE EDGE LINE BREAKS AND RADII FOR TOWN HIGHWAYS)
WARREN:
STA 169+50.00 - STA 174+00.00 LT & RT

646.612 TEMPORARY 4 INCH YELLOW LINE, PAINT
(ALL LINES WILL INCLUDE C/L BREAKS FOR TOWN HIGHWAYS) S=SOLID, D=DASHED

WARREN:	LT	℄	RT
STA 169+50.00 - STA 174+00.00	S	-	S

N
VT STATE PLANE GRID

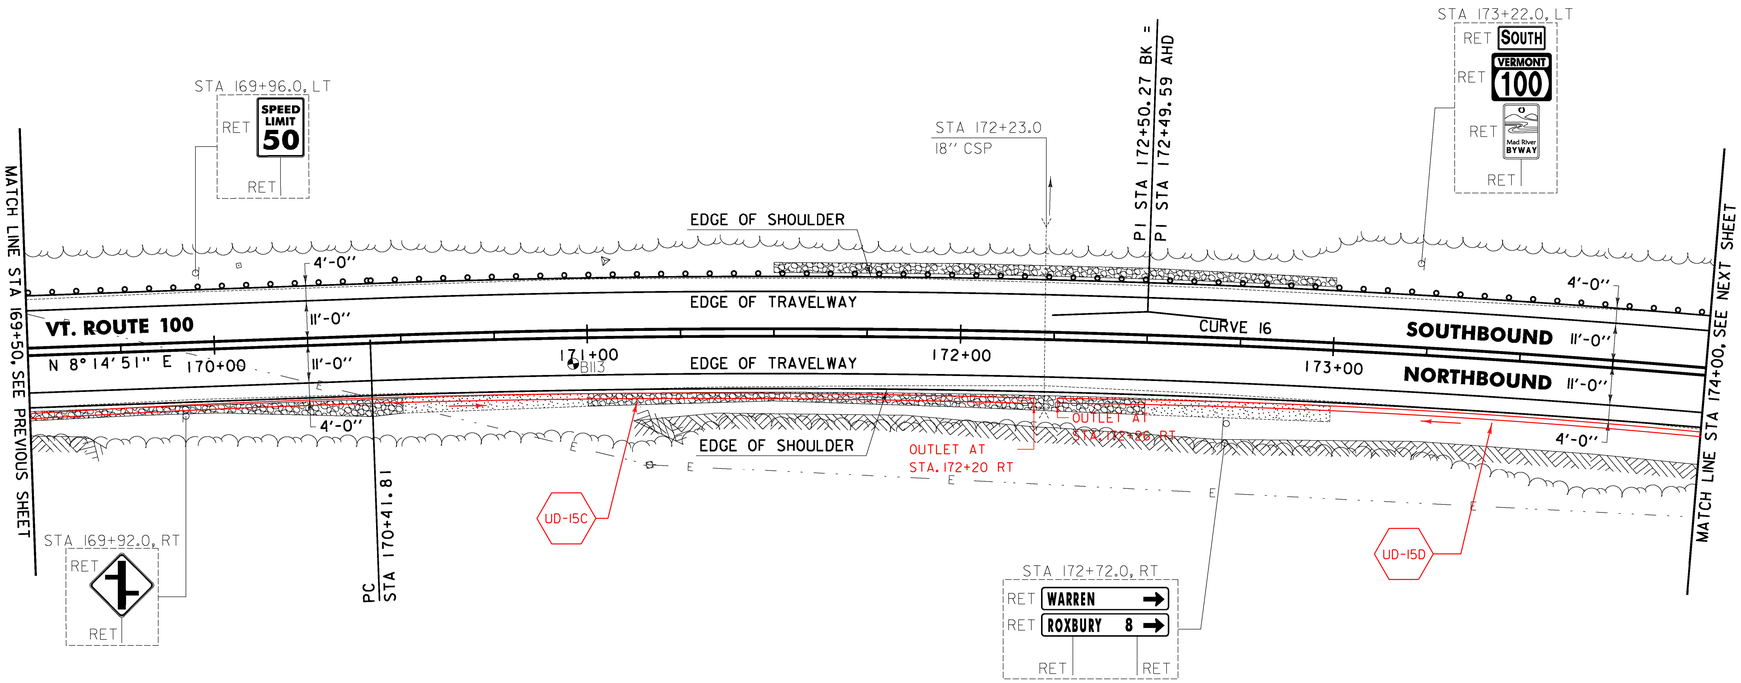

613.10 STONE FILL, TYPE I
WARREN:
STA 169+50.0 - STA 170+50.0 RT (5.3 CY)
STA 171+00.0 - STA 172+50.0 RT (14.1 CY)
STA 171+50.0 - STA 173+00.0 LT (19.4 CY)

621.80 REMOVAL AND DISPOSAL OF GUARDRAIL
WARREN:
STA 169+50.0 - STA 174+00.0 LT (450.0 LF)

651.40 GRUBBING MATERIAL
WARREN:
STA 169+50.0 - STA 170+50.0 RT (35.6 SY)
STA 170+50.0 - STA 171+00.0 RT (23.8 SY)
STA 171+00.0 - STA 172+50.0 RT (65.8 SY)
STA 171+50.0 - STA 173+00.0 LT (55.9 SY)
STA 172+50.0 - STA 173+00.0 RT (26.9 SY)

653.20 TEMPORARY EROSION MATTING
WARREN:
STA 169+50.0 - STA 170+50.0 RT (35.6 SY)
STA 170+50.0 - STA 171+00.0 RT (23.8 SY)
STA 171+00.0 - STA 172+50.0 RT (65.8 SY)
STA 171+50.0 - STA 173+00.0 LT (55.9 SY)
STA 172+50.0 - STA 173+00.0 RT (26.9 SY)

649.31 GEOTEXTILE UNDER STONE FILL
WARREN:
STA 169+50.0 - STA 170+50.0 RT (57.8 SY)
STA 171+00.0 - STA 172+50.0 RT (99.1 SY)
STA 171+50.0 - STA 173+00.0 LT (89.3 SY)

900.640 SPECIAL PROVISION (BOX BEAM GUARDRAIL W/7 FEET POSTS)
WARREN:
STA 169+50.0 - STA 174+00.0 LT (450.0 LF)

SOIL BORING DATA			
BORING #	DEPTH (FT.)	PCC	COMMENTS
BII3	5.0	NO	

CURVE 16
△ = 7°56' 59"
D = 1°54' 35"
R = 3000.00'
T = 208.46'
L = 416.24'
E = 7.23'
e = 0.037 FT/FT

SIGN LEGEND
R = REMOVE
S = SALVAGE
N = NEW
RET = RETAIN
B-B = BACK TO BACK
EXISTING = ----------
NEW = ——————
① = RETURN TO THE TOWN OF WARREN

0 20 40
SCALE IN FEET

LEGEND
ITEM 613.10 STONE FILL, TYPE I
ITEM 653.20 TEMPORARY EROSION MATTING

PROJECT LAYOUT SHEET #24

PROJECT NAME: WARREN - WAITSFIELD
PROJECT NUMBER: STP 2506(1)
FILE NAME: p05b048.dgn
PROJECT LEADER: D.E.G.
DESIGNED BY: M.J.M.
IPARM FILE: p05b048124.i
PLOT DATE: 12/20/2012
DRAWN BY: W.G.P.
CHECKED BY: D.E.G.
SHEET 50 OF 310

FILE NAME = U:\1782\CADD\MSTN\STP 2506\p05b048_Contract Plans.dgn
DATE/TIME = 12/20/2012
USER = 4665