646.402 DURABLE 4 INCH WHITE LINE, THERMOPLASTIC OR
646.403 DURABLE 4 INCH WHITE LINE, EPOXY PAINT OR
646.404 DURABLE 4 INCH WHITE LINE, POLYUREA
(ALL LINES WILL INCLUDE EDGE LINE BREAKS AND RADII FOR TOWN HIGHWAYS)
WARREN:
STA 197+50.00 - STA 203+50.00 LT & RT

646.412 DURABLE 4 INCH YELLOW LINE, THERMOPLASTIC OR
646.413 DURABLE 4 INCH YELLOW LINE, EPOXY PAINT OR
646.414 DURABLE 4 INCH YELLOW LINE, POLYUREA
(ALL LINES WILL INCLUDE C/L BREAKS FOR TOWN HIGHWAYS) S=SOLID, D=DASHED
WARREN:

	LT	℄	RT
STA 197+50.00 - STA 203+50.00	S	-	S

646.602 TEMPORARY 4 INCH WHITE LINE, PAINT
(ALL LINES WILL INCLUDE EDGE LINE BREAKS AND RADII FOR TOWN HIGHWAYS)
WARREN:
STA 197+50.00 - STA 203+50.00 LT & RT

646.612 TEMPORARY 4 INCH YELLOW LINE, PAINT
(ALL LINES WILL INCLUDE C/L BREAKS FOR TOWN HIGHWAYS) S=SOLID, D=DASHED
WARREN:

	LT	℄	RT
STA 197+50.00 - STA 203+50.00	S	-	S

675.50 REMOVING SIGNS
AS SHOWN - 1

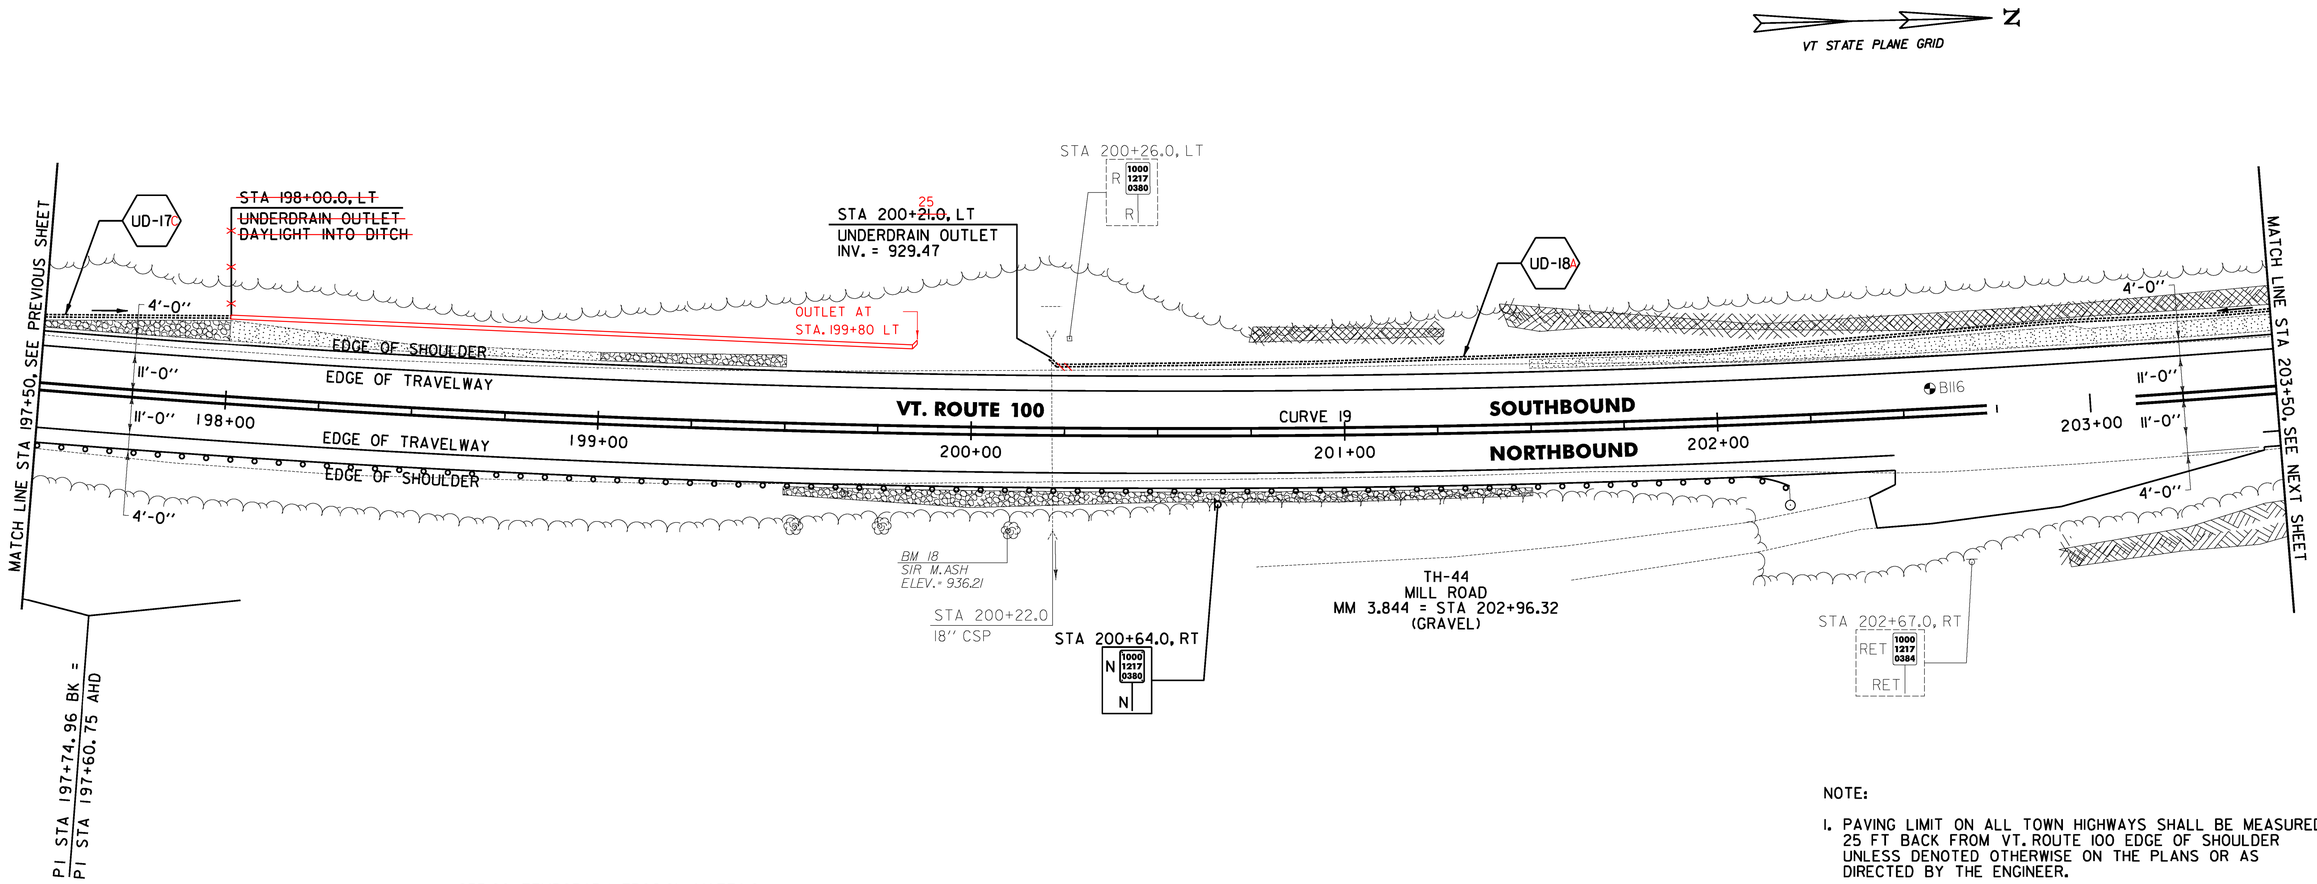

NOTE:

1. PAVING LIMIT ON ALL TOWN HIGHWAYS SHALL BE MEASURED 25 FT BACK FROM VT. ROUTE 100 EDGE OF SHOULDER UNLESS DENOTED OTHERWISE ON THE PLANS OR AS DIRECTED BY THE ENGINEER.

613.10 STONE FILL, TYPE I
WARREN:
STA 197+50.0 - STA 198+00.0 LT (2.2 CY)
STA 199+00.0 - STA 199+50.0 LT (2.6 CY)
STA 199+50.0 - STA 201+50.0 RT (31.2 CY)

621.80 REMOVAL AND DISPOSAL OF GUARDRAIL
WARREN:
STA 197+50.0 - STA 202+10.0 RT (460.0 LF)

651.40 GRUBBING MATERIAL
WARREN:
STA 197+50.0 - STA 198+00.0 LT (23.2 SY)
STA 198+00.0 - STA 199+00.0 LT (36.7 SY)
STA 199+00.0 - STA 199+50.0 LT (17.3 SY)
STA 199+50.0 - STA 201+50.0 RT (90.9 SY)
STA 201+50.0 - STA 203+50.0 LT (85.0 SY)

653.20 TEMPORARY EROSION MATTING
WARREN:
STA 197+50.0 - STA 198+00.0 LT (23.2 SY)
STA 198+00.0 - STA 199+00.0 LT (36.7 SY)
STA 199+00.0 - STA 199+50.0 LT (17.3 SY)
STA 199+50.0 - STA 201+50.0 RT (90.9 SY)
STA 201+50.0 - STA 203+50.0 LT (85.0 SY)

676.10 DELINEATOR WITH STEEL POST
WARREN:
STA 202+18.5 RT

900.640 SPECIAL PROVISION (BOX BEAM GUARDRAIL W/7 FEET POSTS)
WARREN:
STA 197+50.0 - STA 202+18.5 RT (468.5 LF)

649.31 GEOTEXTILE UNDER STONE FILL
WARREN:
STA 197+50.0 - STA 198+00.0 LT (34.3 SY)
STA 199+00.0 - STA 199+50.0 LT (28.4 SY)
STA 199+50.0 - STA 201+50.0 RT (135.4 SY)

CURVE 19
△ = 20° 16' 44"
D = 1° 30' 28"
R = 3800.00'
T = 679.58'
L = 1344.95'
E = 60.29'
e = 0.031 FT/FT

SOIL BORING DATA			
BORING #	DEPTH (FT.)	PCC	COMMENTS
B116	4.0	NO	REFUSAL AT 4.0 FT

SIGN LEGEND
R = REMOVE
S = SALVAGE
N = NEW
RET = RETAIN
B-B = BACK TO BACK
EXISTING = ----------
NEW = ——————
① = RETURN TO THE TOWN OF WARREN

0 20 40
SCALE IN FEET

LEGEND
ITEM 613.10 STONE FILL, TYPE I
ITEM 653.20 TEMPORARY EROSION MATTING

PROJECT LAYOUT SHEET #29

PROJECT NAME: WARREN - WAITSFIELD
PROJECT NUMBER: STP 2506(1)

FILE NAME: p05b048.dgn
PROJECT LEADER: D.E.G.
DESIGNED BY: M.J.M.
IPARM FILE: p05b048129.i
PLOT DATE: 12/20/2012
DRAWN BY: W.G.P.
CHECKED BY: D.E.G.
SHEET 55 OF 310

FILE NAME = U:\1776\CADD\MSTN\STP 2506\p05b048_Contract Plans.dgn
TIME = 12:20:
DATE/TIME = 12/20/2012
USER = 4068