646.402 DURABLE 4 INCH WHITE LINE, THERMOPLASTIC OR
646.403 DURABLE 4 INCH WHITE LINE, EPOXY PAINT OR
646.404 DURABLE 4 INCH WHITE LINE, POLYUREA
(ALL LINES WILL INCLUDE EDGE LINE BREAKS AND RADII FOR TOWN HIGHWAYS)
WARREN:
STA 203+50.00 - STA 209+00.00 LT & RT

646.412 DURABLE 4 INCH YELLOW LINE, THERMOPLASTIC OR
646.413 DURABLE 4 INCH YELLOW LINE, EPOXY PAINT OR
646.414 DURABLE 4 INCH YELLOW LINE, POLYUREA
(ALL LINES WILL INCLUDE C/L BREAKS FOR TOWN HIGHWAYS) S=SOLID, D=DASHED

WARREN:	LT	℄	RT
STA 203+50.00 - STA 209+00.00	S	-	S

646.602 TEMPORARY 4 INCH WHITE LINE, PAINT
(ALL LINES WILL INCLUDE EDGE LINE BREAKS AND RADII FOR TOWN HIGHWAYS)
WARREN:
STA 203+50.00 - STA 209+00.00 LT & RT

646.612 TEMPORARY 4 INCH YELLOW LINE, PAINT
(ALL LINES WILL INCLUDE C/L BREAKS FOR TOWN HIGHWAYS) S=SOLID, D=DASHED

WARREN:	LT	℄	RT
STA 203+50.00 - STA 209+00.00	S	-	S

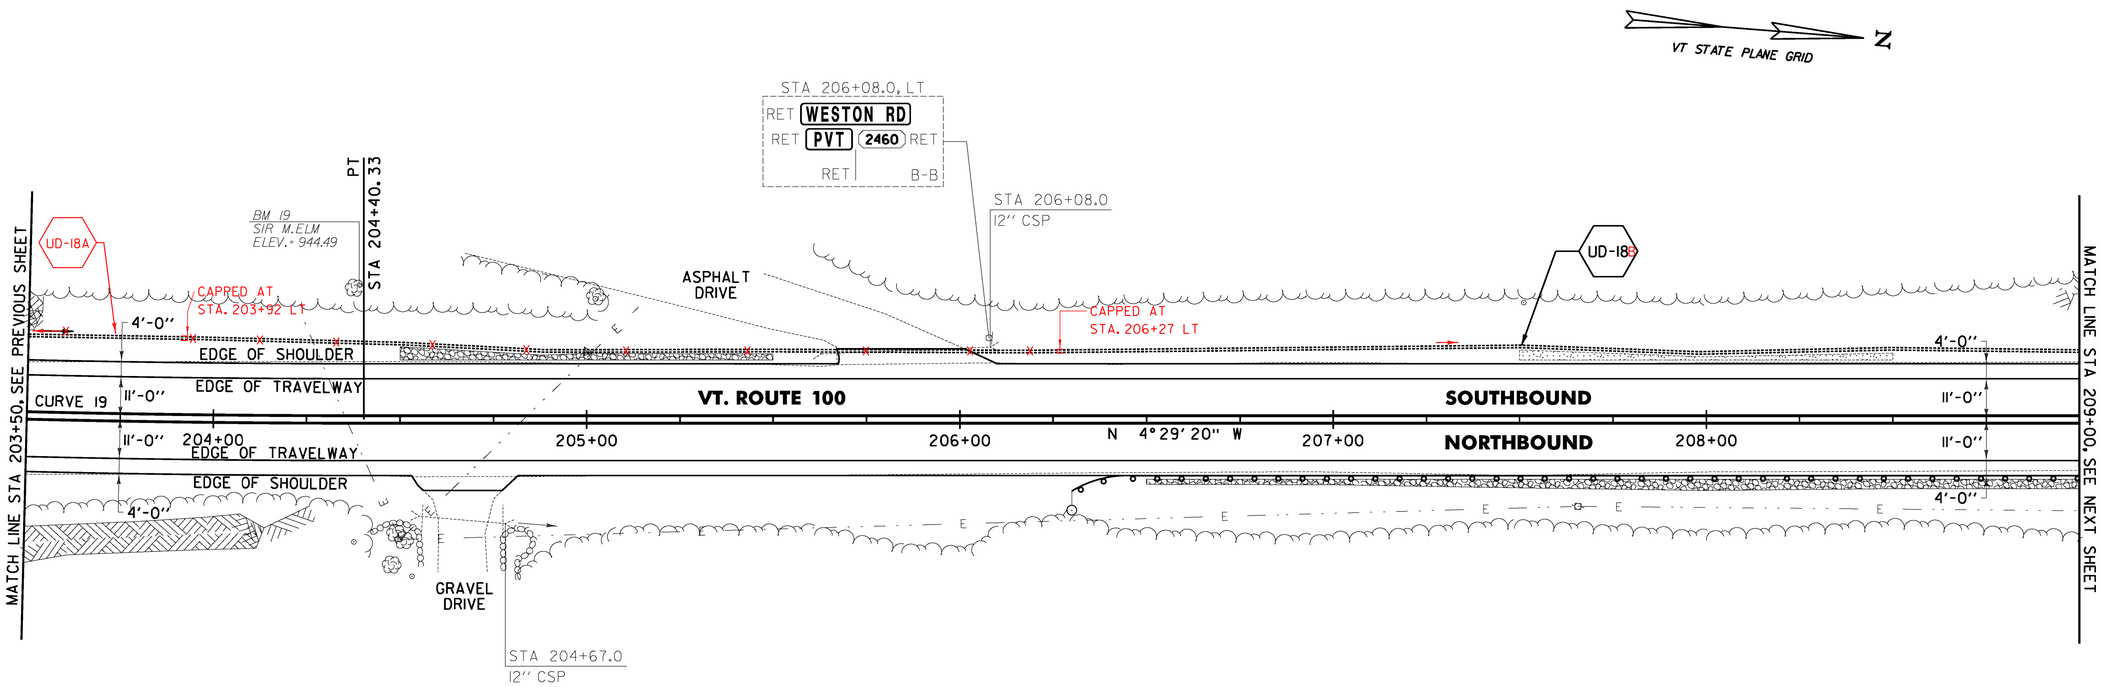

649.31 GEOTEXTILE UNDER STONE FILL
WARREN:
STA 204+50.0 - STA 205+50.0 LT (52.1 SY)
STA 206+50.0 - STA 209+00.0 RT (128.0 SY)

613.10 STONE FILL, TYPE I
WARREN:
STA 204+50.0 - STA 205+50.0 LT (10.4 CY)
STA 206+50.0 - STA 209+00.0 RT (13.3 CY)

621.80 REMOVAL AND DISPOSAL OF GUARDRAIL
WARREN:
STA 206+41.0 - STA 209+00.0 RT (259.0 LF)

651.40 GRUBBING MATERIAL
WARREN:
STA 204+50.0 - STA 205+50.0 LT (29.9 SY)
STA 206+50.0 - STA 209+00.0 RT (72.4 SY)
STA 207+50.0 - STA 208+50.0 LT (19.5 SY)

653.20 TEMPORARY EROSION MATTING
WARREN:
STA 204+50.0 - STA 205+50.0 LT (29.9 SY)
STA 206+50.0 - STA 209+00.0 RT (72.4 SY)
STA 207+50.0 - STA 208+50.0 LT (19.5 SY)

676.10 DELINEATOR WITH STEEL POST
WARREN:
STA 206+30.0 RT

900.640 SPECIAL PROVISION (BOX BEAM GUARDRAIL W/7 FEET POSTS)
WARREN:
STA 206+30.0 - STA 209+00.0 RT (270.0 LF)

CURVE 19
△ = 20° 16' 44"
D = 1° 30' 28"
R = 3800.00'
T = 679.58'
L = 1344.95'
E = 60.29'
e = 0.031 FT/FT

SIGN LEGEND
R = REMOVE
S = SALVAGE
N = NEW
RET = RETAIN
B-B = BACK TO BACK
EXISTING = ----------
NEW = ————————
Ⓘ = RETURN TO THE TOWN OF WARREN

LEGEND
ITEM 613.10 STONE FILL, TYPE I
ITEM 653.20 TEMPORARY EROSION MATTING

0 20 40
SCALE IN FEET

PROJECT LAYOUT SHEET #30

PROJECT NAME: WARREN - WAITSFIELD
PROJECT NUMBER: STP 2506(1)

FILE NAME: p05b048.dgn
PROJECT LEADER: D.E.G.
DESIGNED BY: M.J.M.
IPARM FILE: p05b048130.i
PLOT DATE: 12/20/2012
DRAWN BY: W.G.P.
CHECKED BY: D.E.G.
SHEET 56 OF 310

FILE NAME = U:\1772\CADD\MSTN\STP 2506\p05b048_Contract Plans.dgn
DATE/TIME = 12/20/2012
USER = 4065