646.402 DURABLE 4 INCH WHITE LINE, THERMOPLASTIC OR
646.403 DURABLE 4 INCH WHITE LINE, EPOXY PAINT OR
646.404 DURABLE 4 INCH WHITE LINE, POLYUREA
(ALL LINES WILL INCLUDE EDGE LINE BREAKS AND RADII FOR TOWN HIGHWAYS)
WARREN:
STA 302+50.00 - STA 307+16.00 LT & RT

646.412 DURABLE 4 INCH YELLOW LINE, THERMOPLASTIC OR
646.413 DURABLE 4 INCH YELLOW LINE, EPOXY PAINT OR
646.414 DURABLE 4 INCH YELLOW LINE, POLYUREA
(ALL LINES WILL INCLUDE C/L BREAKS FOR TOWN HIGHWAYS) S=SOLID, D=DASHED
WARREN:

	LT	℄	RT
STA 302+50.00 - STA 307+16.00	S	-	S

646.602 TEMPORARY 4 INCH WHITE LINE, PAINT
(ALL LINES WILL INCLUDE EDGE LINE BREAKS AND RADII FOR TOWN HIGHWAYS)
WARREN:
STA 302+50.00 - STA 307+16.00 LT & RT

646.612 TEMPORARY 4 INCH YELLOW LINE, PAINT
(ALL LINES WILL INCLUDE C/L BREAKS FOR TOWN HIGHWAYS) S=SOLID, D=DASHED
WARREN:

	LT	℄	RT
STA 302+50.00 - STA 307+16.00	S	-	S

675.50 REMOVING SIGNS
AS SHOWN - 2

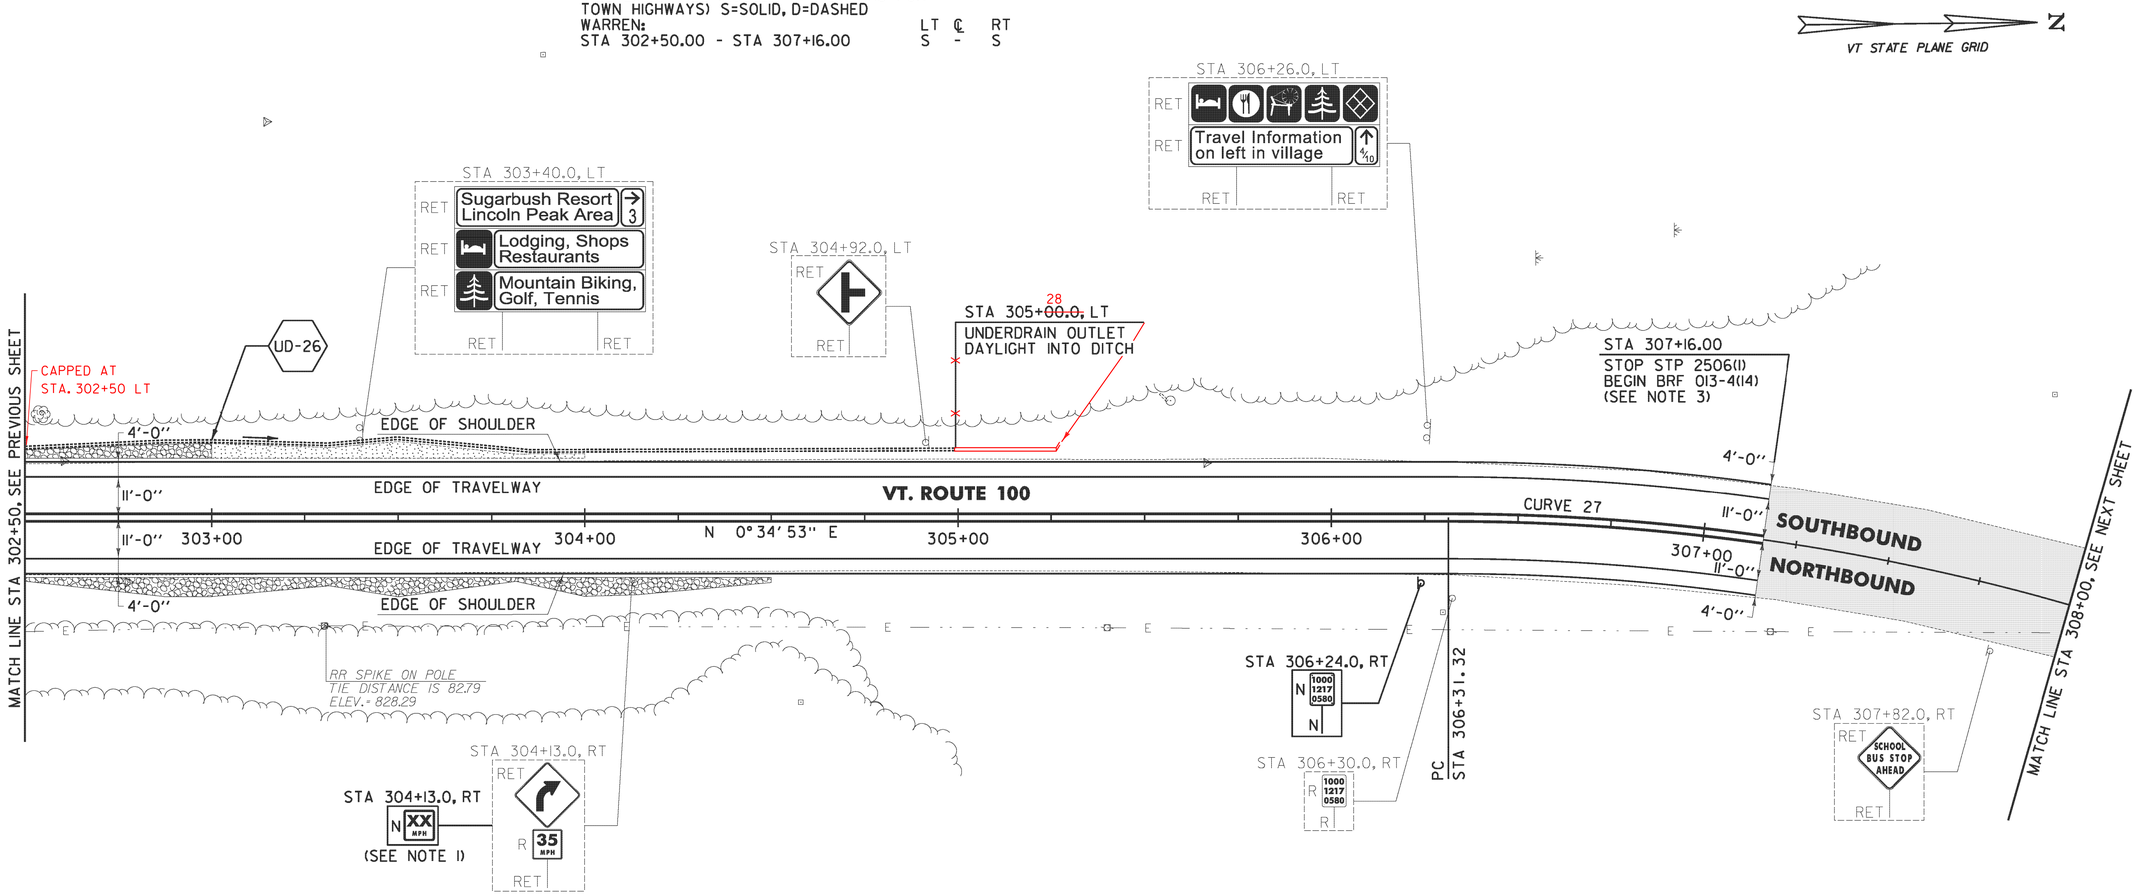

613.10 STONE FILL, TYPE I
WARREN:
STA 302+50.0 - STA 303+00.0 LT (7.2 CY)
STA 302+50.0 - STA 304+50.0 RT (38.3 CY)

651.40 GRUBBING MATERIAL
WARREN:
STA 302+50.0 - STA 303+00.0 LT (20.8 SY)
STA 302+50.0 - STA 304+50.0 RT (112.1 SY)
STA 303+00.0 - STA 304+00.0 LT (45.7 SY)

653.20 TEMPORARY EROSION MATTING
WARREN:
STA 302+50.0 - STA 303+00.0 LT (20.8 SY)
STA 302+50.0 - STA 304+50.0 RT (112.1 SY)
STA 303+00.0 - STA 304+00.0 LT (45.7 SY)

649.31 GEOTEXTILE UNDER STONE FILL
WARREN:
STA 302+50.0 - STA 303+00.0 LT (31.9 SY)
STA 302+50.0 - STA 304+50.0 RT (156.5 SY)

CURVE 27
△ = 50° 48' 11"
D = 9° 28' 13"
R = 605.00'
T = 287.29'
L = 536.44'
E = 64.75'
e = 0.080 FT/FT

NOTES:

1. THE ADVISORY SPEED SHALL BE DETERMINED USING AN ESTABLISHED ENGINEERING PRACTICE AS LISTED IN SECTION 2C.08 OF THE MUTCD.
2. APPROXIMATE WETLAND LOCATION FROM STA 306+00 TO STA 308+00 LT.
3. ADJUSTMENTS TO THE HORIZONTAL AND VERTICAL ALIGNMENTS ALONG WITH SUPERELEVATION MAY BE NECESSARY TO TIE INTO PROJECT BRF 013-4(14) AS DIRECTED BY THE ENGINEER.

SIGN LEGEND
R = REMOVE
S = SALVAGE
N = NEW
RET = RETAIN
B-B = BACK TO BACK
EXISTING = ----------
NEW = ————
① = RETURN TO THE TOWN OF WARREN

0 20 40
SCALE IN FEET

LEGEND
ITEM 613.10 STONE FILL, TYPE I
ITEM 653.20 TEMPORARY EROSION MATTING
NO PAVING WORK TO BE PERFORMED IN THIS AREA UNDER STP 2506(I)

PROJECT LAYOUT SHEET #48

PROJECT NAME: WARREN - WAITSFIELD
PROJECT NUMBER: STP 2506(I)
FILE NAME: p05b048.dgn
PROJECT LEADER: D.E.G.
DESIGNED BY: M.J.M.
IPARM FILE: p05b048148.i
PLOT DATE: 12/20/2012
DRAWN BY: W.G.P.
CHECKED BY: D.E.G.
SHEET 74 OF 310

FILE NAME = U:\1776Z\CADD\MSTN\STP 2506\p05b048_Contract Plans.dgn
DATE/TIME = 12/20/2012
USER = 14026