646.402 DURABLE 4 INCH WHITE LINE, THERMOPLASTIC OR
646.403 DURABLE 4 INCH WHITE LINE, EPOXY PAINT OR
646.404 DURABLE 4 INCH WHITE LINE, POLYUREA
(ALL LINES WILL INCLUDE EDGE LINE BREAKS AND RADII FOR TOWN HIGHWAYS)
WARREN:
STA 319+00.00 - STA 324+50.00 LT & RT

646.412 DURABLE 4 INCH YELLOW LINE, THERMOPLASTIC OR
646.413 DURABLE 4 INCH YELLOW LINE, EPOXY PAINT OR
646.414 DURABLE 4 INCH YELLOW LINE, POLYUREA
(ALL LINES WILL INCLUDE C/L BREAKS FOR TOWN HIGHWAYS) S=SOLID, D=DASHED
WARREN:

	LT	℄	RT
STA 319+00.00 - STA 324+50.00	S	-	S

646.602 TEMPORARY 4 INCH WHITE LINE, PAINT
(ALL LINES WILL INCLUDE EDGE LINE BREAKS AND RADII FOR TOWN HIGHWAYS)
WARREN:
STA 319+00.00 - STA 324+50.00 LT & RT

646.612 TEMPORARY 4 INCH YELLOW LINE, PAINT
(ALL LINES WILL INCLUDE C/L BREAKS FOR TOWN HIGHWAYS) S=SOLID, D=DASHED
WARREN:

	LT	℄	RT
STA 319+00.00 - STA 324+50.00	S	-	S

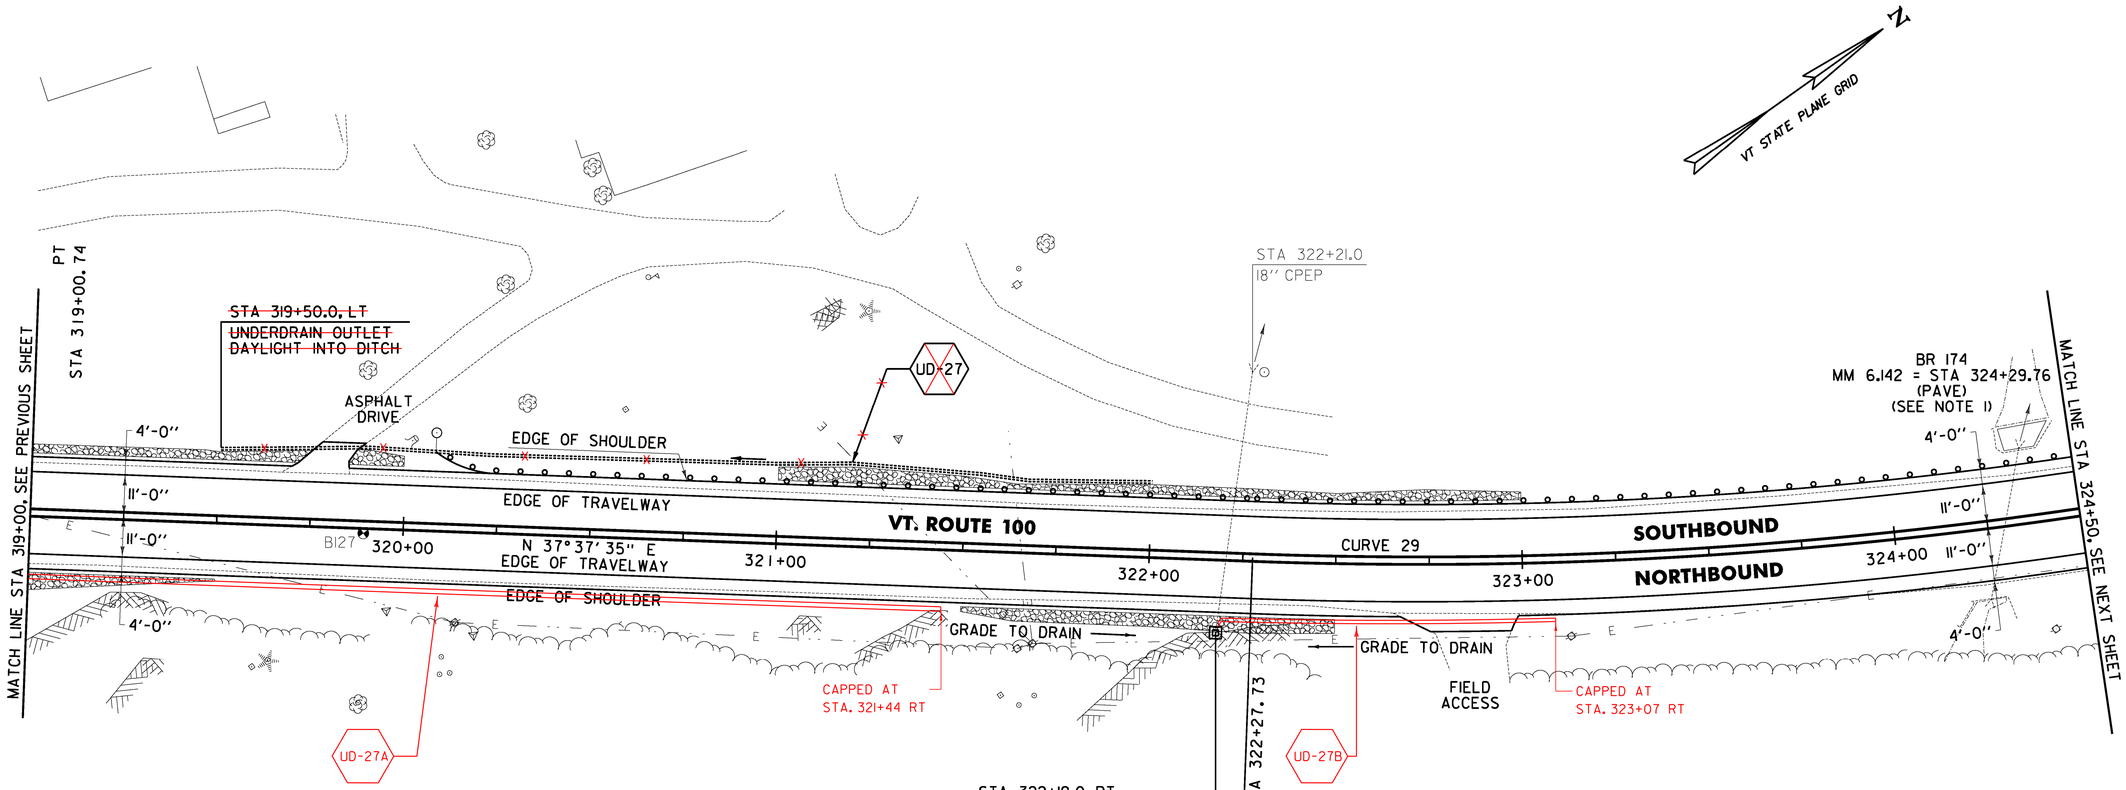

613.10 STONE FILL, TYPE I
WARREN:
STA 319+00.0 - STA 319+50.0 RT (6.1 CY)
STA 319+00.0 - STA 319+71.0 LT (9.6 CY)
STA 319+85.0 - STA 320+00.0 LT (3.3 CY)
STA 321+00.0 - STA 323+00.0 LT (24.8 CY)
STA 321+50.0 - STA 322+50.0 RT (8.2 CY)

621.205 STEEL BEAM GUARDRAIL, GALVANIZED W/8 FEET POSTS
WARREN:
STA 320+08.0 - STA 324+22.5 LT (414.5 LF)
STA 324+47.5 - STA 324.50.0 LT (2.5 LF)

621.217 HD STEEL BEAM GUARDRAIL, GALVANIZED/NESTED W/8 FEET POSTS
WARREN:
STA 324+22.5 - STA 324+47.5 LT (25.0 LF)

621.60 ANCHOR FOR STEEL BEAM RAIL
WARREN:
STA 320+14.5 LT

621.80 REMOVAL AND DISPOSAL OF GUARDRAIL
WARREN:
STA 321+66.0 - STA 324+50.0 LT (284.0 LF)

651.40 GRUBBING MATERIAL
WARREN:
STA 319+00.0 - STA 319+50.0 RT (17.7 SY)
STA 319+00.0 - STA 319+71.0 LT (30.0 SY)
STA 319+85.0 - STA 320+00.0 LT (7.2 SY)
STA 321+00.0 - STA 323+00.0 LT (71.7 SY)
STA 321+50.0 - STA 322+50.0 RT (38.2 SY)

649.31 GEOTEXTILE UNDER STONE FILL
WARREN:
STA 319+00.0 - STA 319+50.0 RT (28.8 SY)
STA 319+00.0 - STA 319+71.0 LT (44.3 SY)
STA 319+85.0 - STA 320+00.0 LT (15.1 SY)
STA 321+00.0 - STA 323+00.0 LT (116.1 SY)
STA 321+50.0 - STA 322+50.0 RT (60.4 SY)

653.20 TEMPORARY EROSION MATTING
WARREN:
STA 319+00.0 - STA 319+50.0 RT (17.7 SY)
STA 319+00.0 - STA 319+71.0 LT (30.0 SY)
STA 319+85.0 - STA 320+00.0 LT (7.2 SY)
STA 321+00.0 - STA 323+00.0 LT (71.7 SY)
STA 321+50.0 - STA 322+50.0 RT (38.2 SY)

676.10 DELINEATOR WITH STEEL POST
WARREN:
STA 320+08.0 LT

SOIL BORING DATA

BORING #	DEPTH (FT.)	PCC	COMMENTS
B127	5.0	NO	

CURVE 29
△ = 24° 19' 46"
D = 4° 42' 57"
R = 1215.00'
T = 261.91'
L = 515.92'
E = 27.91'
e = 0.070 FT/FT

SIGN LEGEND
R = REMOVE
S = SALVAGE
N = NEW
RET = RETAIN
B-B = BACK TO BACK
EXISTING = ----------
NEW = ——————
Ⓣ = RETURN TO THE TOWN OF WARREN

NOTE:
1. SEE SHEET 301 FOR STEEL BEAM GUARDRAIL AT SMALL CULVERT DETAIL.

LEGEND
ITEM 613.10 STONE FILL, TYPE I
ITEM 653.20 TEMPORARY EROSION MATTING

0 20 40
SCALE IN FEET

PROJECT LAYOUT SHEET #51

PROJECT NAME: WARREN - WAITSFIELD
PROJECT NUMBER: STP 2506(1)
FILE NAME: p05b048.dgn
PROJECT LEADER: D.E.G.
DESIGNED BY: M.J.M.
IPARM FILE: p05b048151.i
PLOT DATE: 12/20/2012
DRAWN BY: W.G.P.
CHECKED BY: D.E.G.
SHEET 77 OF 310

FILE NAME = U:\1776Z\CADD\MSTN\STP 2506\p05b048_Contract Plans.dgn
DATE/TIME = 12/20/2012
USER = 4628