646.402 DURABLE 4 INCH WHITE LINE, THERMOPLASTIC OR
646.403 DURABLE 4 INCH WHITE LINE, EPOXY PAINT OR
646.404 DURABLE 4 INCH WHITE LINE, POLYUREA
(ALL LINES WILL INCLUDE EDGE LINE BREAKS AND RADII FOR TOWN HIGHWAYS)
WAITSFIELD:
STA 99+50.00 - STA 105+75.00 LT & RT

646.412 DURABLE 4 INCH YELLOW LINE, THERMOPLASTIC OR
646.413 DURABLE 4 INCH YELLOW LINE, EPOXY PAINT OR
646.414 DURABLE 4 INCH YELLOW LINE, POLYUREA
(ALL LINES WILL INCLUDE C/L BREAKS FOR TOWN HIGHWAYS) S=SOLID, D=DASHED
WAITSFIELD:

	LT	℄	RT
STA 99+50.00 - STA 105+75.00	S	-	S

STA 105+23.04 DOUBLE SOLID LT, TH-39

646.482 DURABLE 24 INCH STOP BAR, THERMOPLASTIC OR
646.483 DURABLE 24 INCH STOP BAR, EPOXY PAINT OR
646.484 DURABLE 24 INCH STOP BAR, POLYUREA
WAITSFIELD:
STA 105+23.04 LT, TH-39

646.492 DURABLE LETTER OR SYMBOL, THERMOPLASTIC OR
646.493 DURABLE LETTER OR SYMBOL, EPOXY PAINT
WAITSFIELD:
STA 105+23.04 LT, TH-39, "S,T,O,P" (4 EA)

646.602 TEMPORARY 4 INCH WHITE LINE, PAINT
(ALL LINES WILL INCLUDE EDGE LINE BREAKS AND RADII FOR TOWN HIGHWAYS)
WAITSFIELD:
STA 99+50.00 - STA 105+75.00 LT & RT

646.612 TEMPORARY 4 INCH YELLOW LINE, PAINT
(ALL LINES WILL INCLUDE C/L BREAKS FOR TOWN HIGHWAYS) S=SOLID, D=DASHED
WAITSFIELD:

	LT	℄	RT
STA 99+50.00 - STA 105+75.00	S	-	S

STA 105+23.04 DOUBLE SOLID LT, TH-39

646.682 TEMPORARY 24 INCH STOP BAR, PAINT
WAITSFIELD:
STA 105+23.04 LT, TH-39

646.692 TEMPORARY LETTER OR SYMBOL, PAINT
WAITSFIELD:
STA 105+23.04 LT, TH-39, "S,T,O,P" (8 EA)

675.50 REMOVING SIGNS
AS SHOWN - 3

675.60 ERECTING SALVAGED SIGNS
AS SHOWN - 1

VT STATE PLANE GRID N

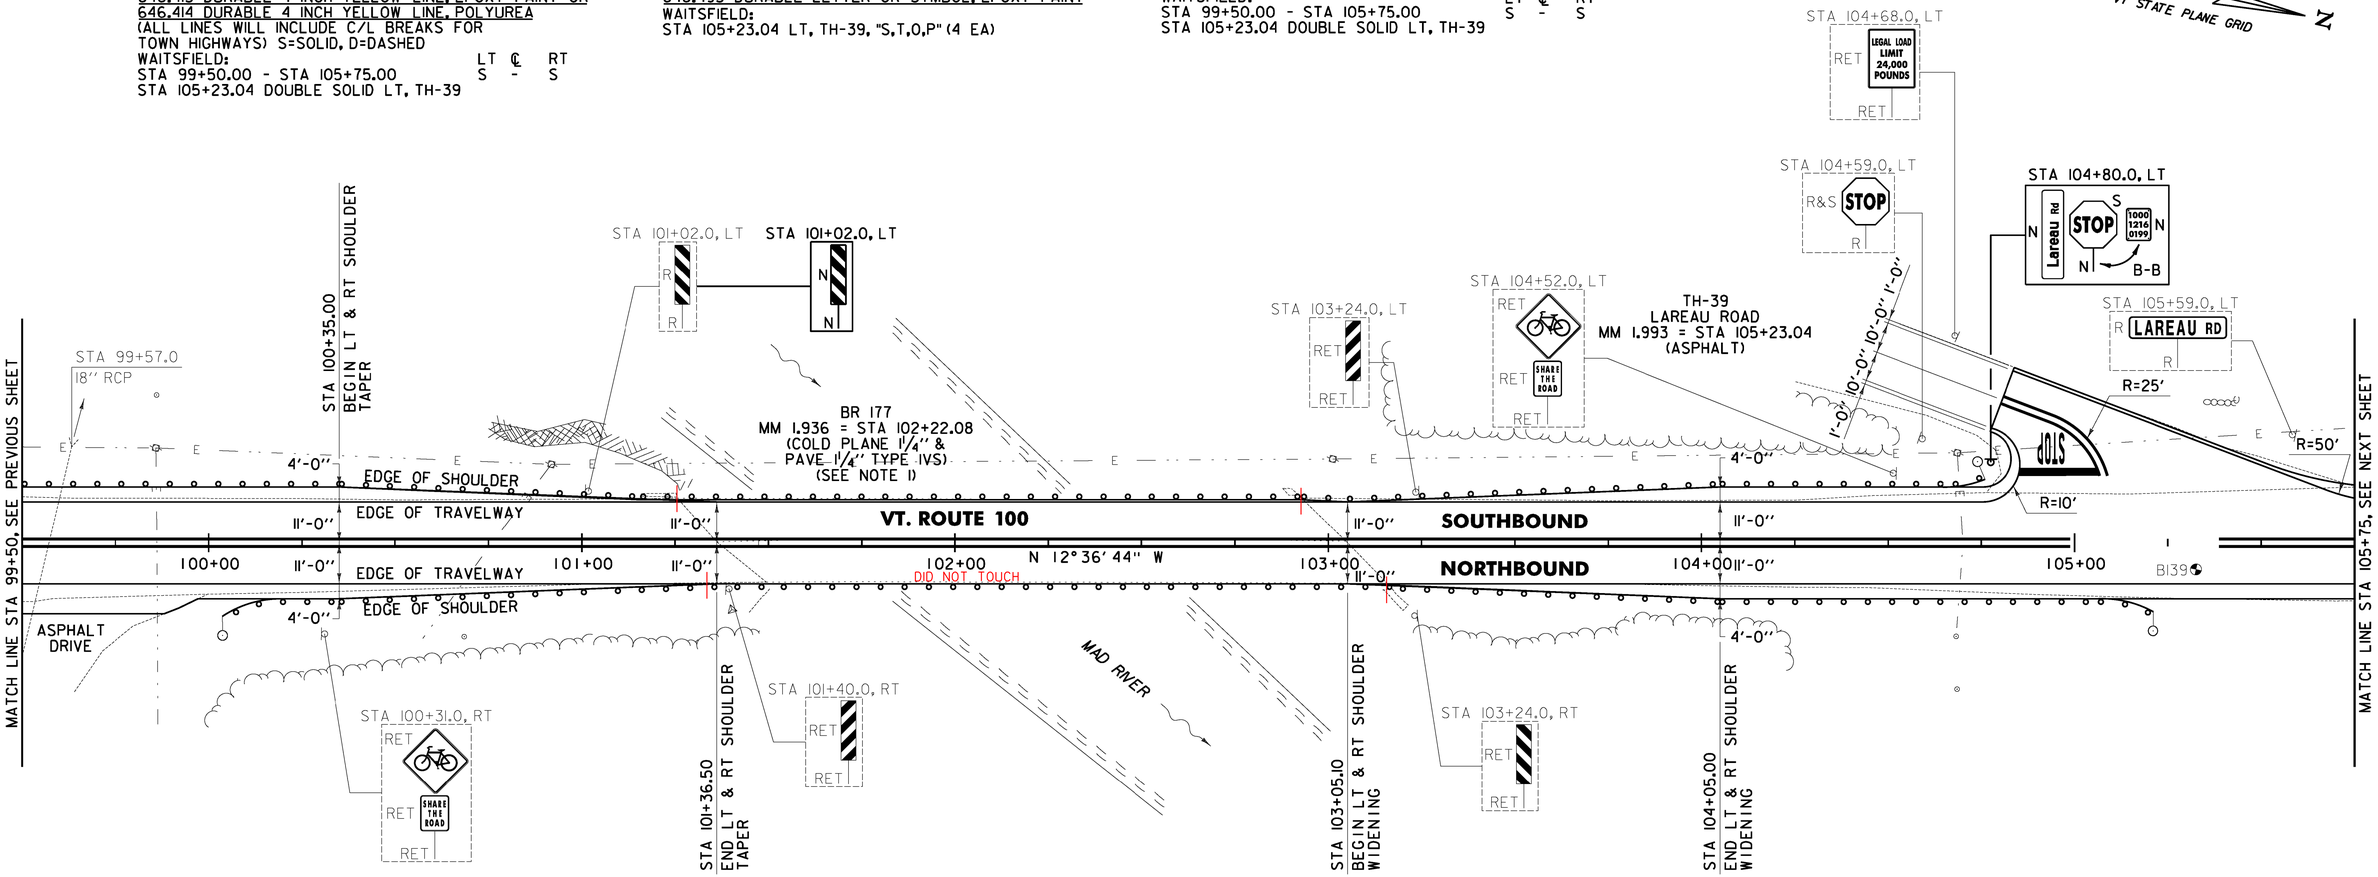

~~900.620 SPECIAL PROVISION (GUARDRAIL APPROACH SECTION, GALVANIZED 2 RAIL BOX BEAM)~~
WAITSFIELD:
STA 100+83.7 - STA 101+16.0 LT ~~(1 EA)~~ STEEL BEAM RAIL 621.205
STA 101+16.7 - STA 101+49.0 RT ~~(1 EA)~~ " "
STA 102+91.0 - STA 103+23.3 LT ~~(1 EA)~~ " "
STA 103+17.8 - STA 103+51.1 RT ~~(1 EA)~~ " "

621.80 REMOVAL AND DISPOSAL OF GUARDRAIL
WAITSFIELD:
STA 99+50.0 - STA 101+16.0 LT (166.0 LF)
STA 101+02.0 - STA 101+49.0 RT (47.0 LF)
STA 102+91.0 - STA 104+57.0 LT (166.0 LF)
STA 103+17.8 - STA 104+89.8 RT (172.0 LF)

676.10 DELINEATOR WITH STEEL POST
WAITSFIELD:
STA 100+03.7 RT
STA 104+72.3 LT
STA 105+18.1 RT

~~900.640 SPECIAL PROVISION (BOX BEAM GUARDRAIL W/7 FEET POSTS)~~
~~WAITSFIELD:~~
~~STA 99+50.0 - STA 100+83.7 LT (133.7 LF)~~
~~STA 100+03.7 - STA 101+16.7 RT (113.0 LF)~~
~~STA 103+23.3 - STA 104+72.3 LT (149.0 LF)~~
~~STA 103+51.1 - STA 105+18.1 RT (167.0 LF)~~

SOIL BORING DATA			
BORING #	DEPTH (FT.)	PCC	COMMENTS
B139	5.0	NO	

NOTES:
1. SEE SHEET 309 FOR BR 177 DETAILS.
2. PAVING LIMIT ON ALL TOWN HIGHWAYS SHALL BE MEASURED 25 FT BACK FROM VT. ROUTE 100 EDGE OF SHOULDER UNLESS DENOTED OTHERWISE ON THE PLANS OR AS DIRECTED BY THE ENGINEER.

SIGN LEGEND
R = REMOVE
S = SALVAGE
N = NEW
RET = RETAIN
B-B = BACK TO BACK
EXISTING = ----------
NEW = ——————
Ⓘ = RETURN TO THE TOWN OF WAITSFIELD

0 20 40
SCALE IN FEET

PROJECT LAYOUT SHEET #72

PROJECT NAME: WARREN - WAITSFIELD
PROJECT NUMBER: STP 2506(1)
FILE NAME: p05b048.dgn
PROJECT LEADER: D.E.G.
DESIGNED BY: M.J.M.
IPARM FILE: p05b048172.i
PLOT DATE: 12/20/2012
DRAWN BY: W.G.P.
CHECKED BY: D.E.G.
SHEET 98 OF 310

FILE NAME = U:\1762\CADD\MSTN\STP 2506\p05b048.Contract Plans.dgn
TIME = 12:28:20
DATE = 12/20/2012
USER = MGS