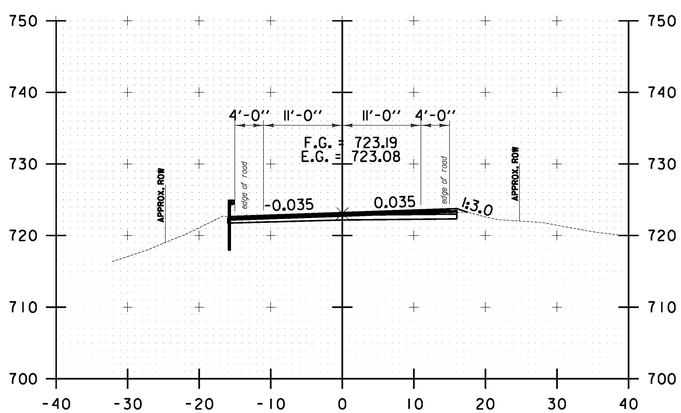

125+50.00

10 0 10
SCALE IN FEET

WAITSFIELD CROSS SECTION SHEET #40

PROJECT NAME: WARREN-WAITSFIELD

PROJECT NUMBER: STP 2506(1)

FILE NAME: p05b048.dgn
PROJECT LEADER: D.E.G.
DESIGNED BY: M.J.M.
IPARM FILE: p05b048xsl33.i

PLOT DATE: 12/20/2012
DRAWN BY: W.G.P.
CHECKED BY: D.E.G.
SHEET 296 OF 310

FILE NAME = U:\17762\CADD\MSTN\STP 2506\p05b048_Contract Plans.dgn
DATE/TIME = 12/20/2012
USER = 4065