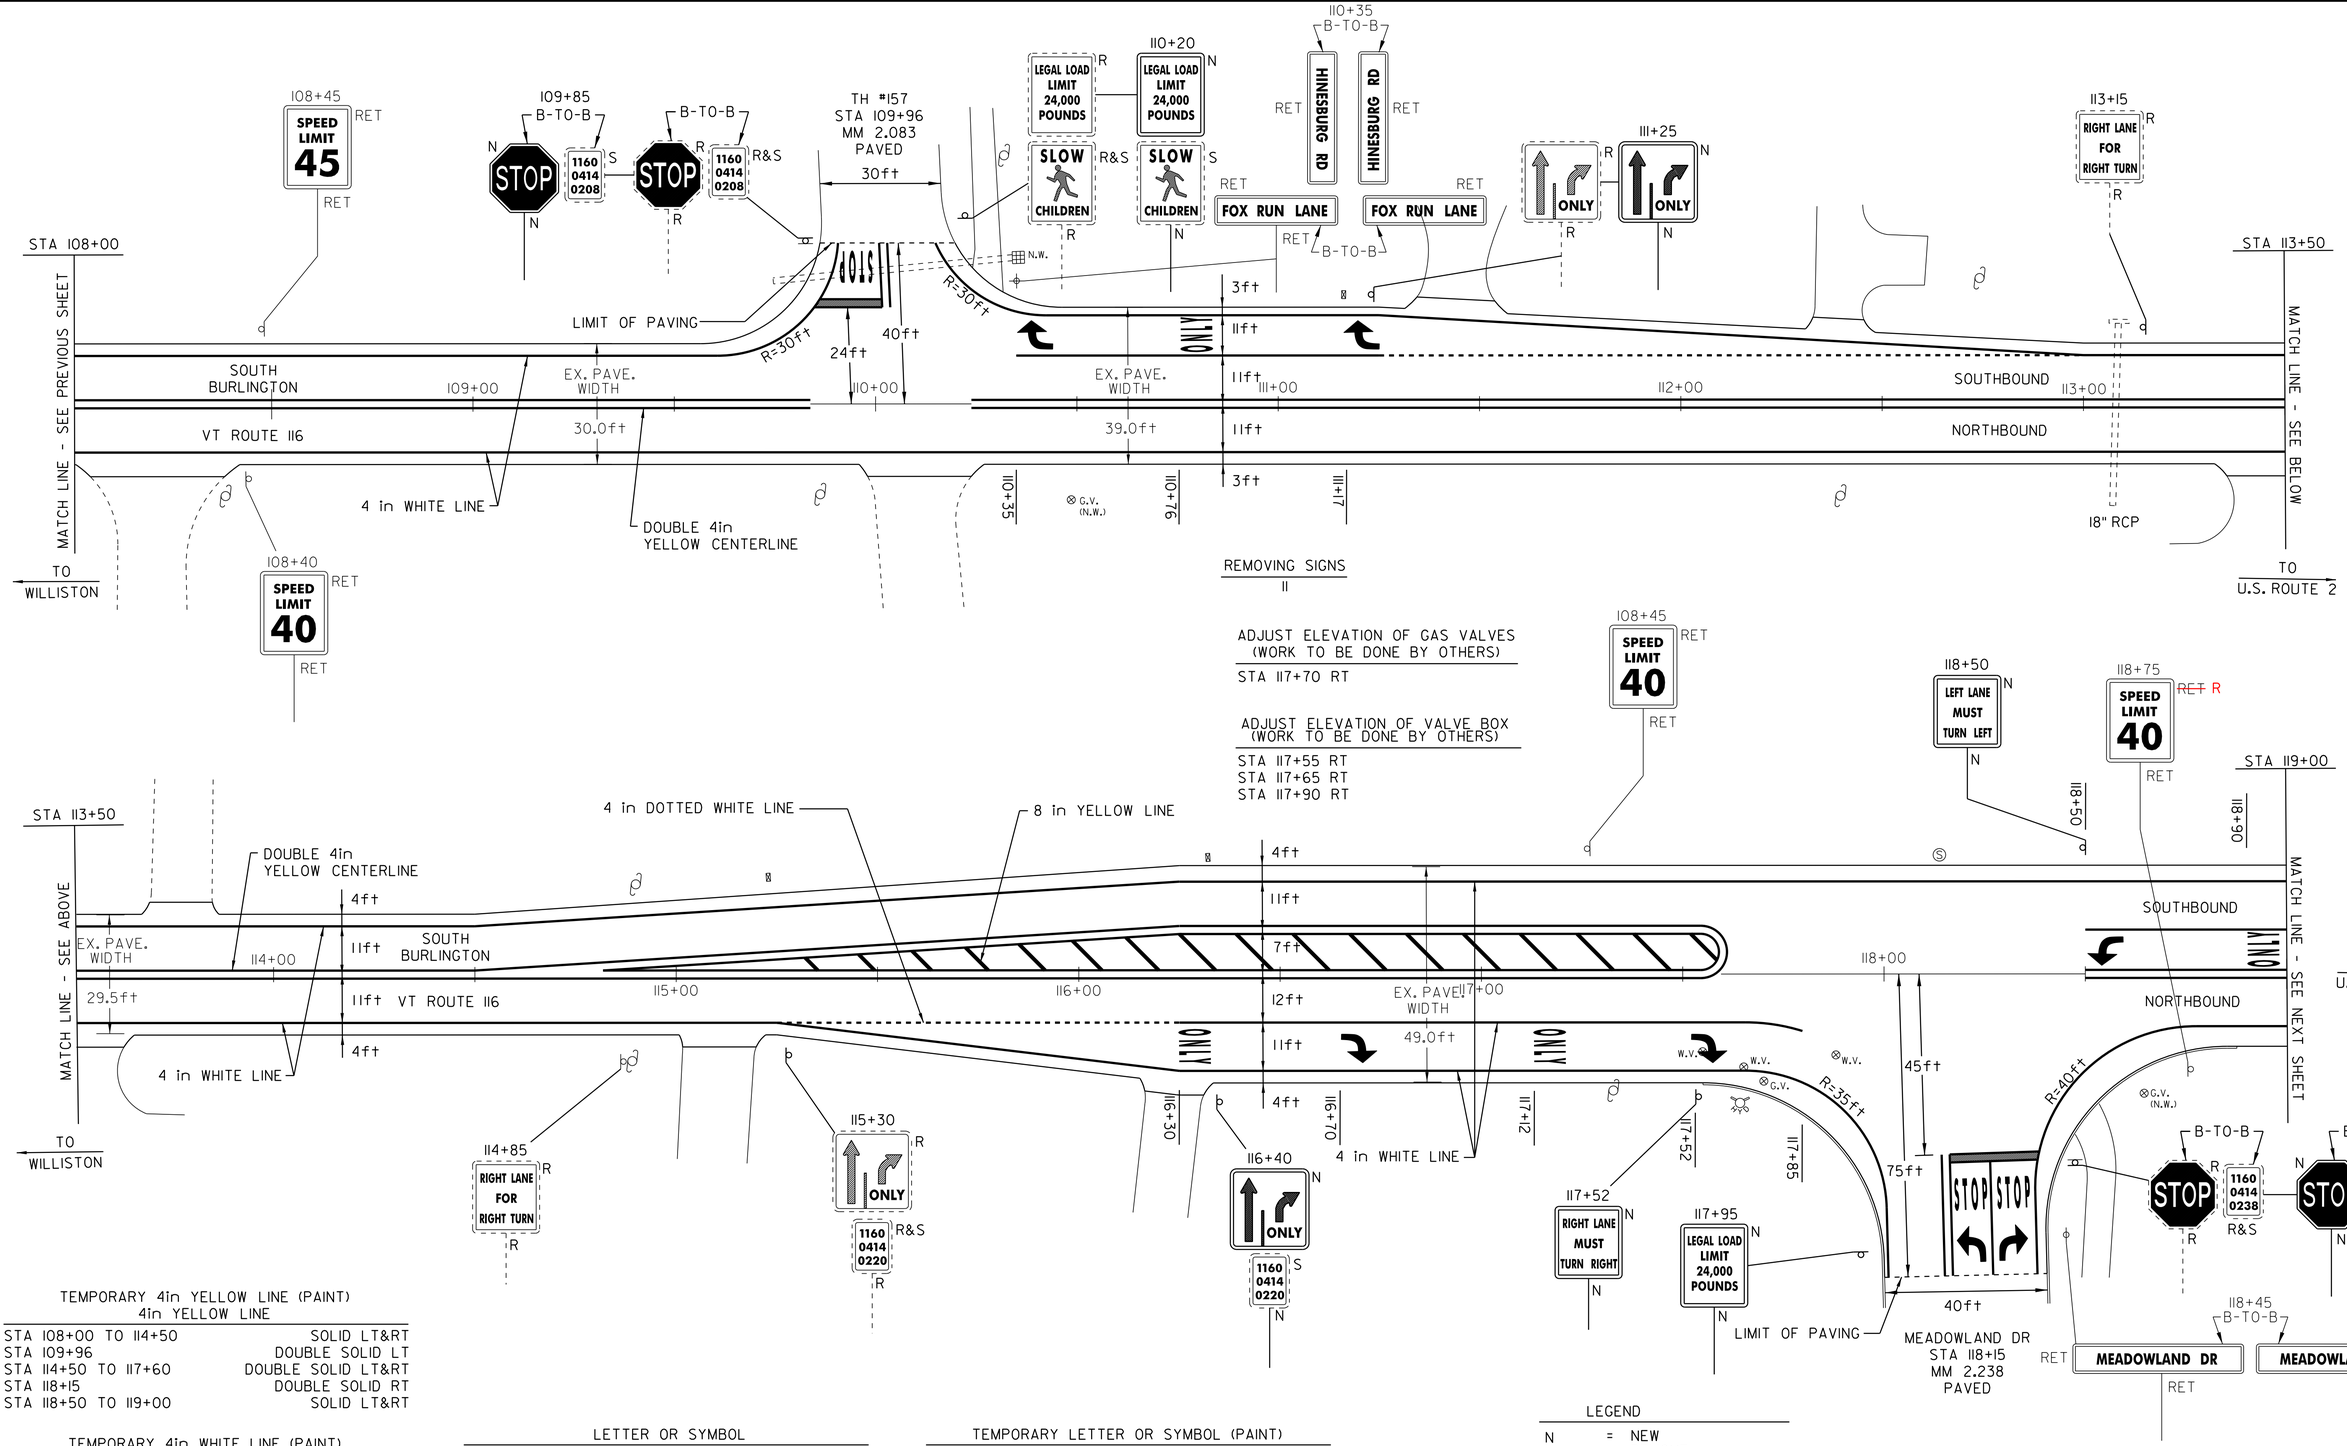

TEMPORARY 4in YELLOW LINE (PAINT)
4in YELLOW LINE

STA 108+00 TO 114+50	SOLID LT&RT
STA 109+96	DOUBLE SOLID LT
STA 114+50 TO 117+60	DOUBLE SOLID LT&RT
STA 118+15	DOUBLE SOLID RT
STA 118+50 TO 119+00	SOLID LT&RT

TEMPORARY 4in WHITE LINE (PAINT)
4in WHITE LINE

STA 108+00 TO 119+00	SOLID LT&RT
STA 110+35 TO 111+25	SOLID LT
STA 111+25 TO 113+00	DOTTED LT
STA 115+30 TO 116+30	DOTTED RT
STA 116+30 TO 117+85	SOLID RT

TEMPORARY 24in STOP BAR (PAINT)
24in STOP BAR

STA 109+96 RT	TH #157
STA 118+50 LT	MEADOWLAND DR

LETTER OR SYMBOL

STA 109+96 LT	"STOP"
STA 110+35 LT	"ONLY"
STA 110+76 LT	"ONLY"
STA 111+17 LT	"ONLY"
STA 116+30 RT	"ONLY"
STA 116+70 RT	"ONLY"
STA 117+12 RT	"ONLY"
STA 117+52 RT	2 - "STOP"
STA 118+15 RT	"ONLY"
STA 118+50 LT	"ONLY"
STA 118+90 LT	

TEMPORARY LETTER OR SYMBOL (PAINT)

STA 109+96 LT	"STOP"
STA 110+35 LT	
STA 111+17 LT	
STA 116+70 RT	
STA 117+52 RT	
STA 118+15 RT	2 - "STOP"
STA 118+50 LT	

8in YELLOW LINE

STA 114+50 TO 117+60	PAINTED ISLAND

LEGEND

N	= NEW
R	= REMOVE
R&S	= REMOVE & SALVAGE
S	= SALVAGE
RET	= RETAIN
B-TO-B	= BACK TO BACK
⊞ ⊞ □	CATCH BASIN/DI
(N.W.)	= NO WORK REQUIRED (TYP. FOR D.I.'S, & C.B.'S WHERE NOTED)
I	YIELDING MARKER POST
	UTILITY POLE
	DRIVE

PAVING PROJECT LAYOUT SHEET #10

DESIGNED BY	BCE/PJM DATE 10-06
DRAWN BY	C.E.A., INC. DATE 10-06
DESIGN FILE NO.	p05b052.dgn
PRF FILE	p05b0521a10 DATE PLOTTED 03-MAY-2012 17
PROJ. NAME	ST. GEORGE-SO. BURLINGTON
PROJ. NO.	ST-STP 2508(1)S
SHEET	19 OF 42 SHEETS