646.402 DURABLE 4 INCH WHITE LINE, THERMOPLASTIC
(ALL LINES WILL INCLUDE EDGE LINE BREAKS AND RADIUS FOR TOWN HIGHWAYS)

ROCHESTER:
STA. 80+00.00 - STA. 96+00.00 LT & RT

646.412 DURABLE 4 INCH YELLOW LINE, THERMOPLASTIC
(ALL LINES WILL INCLUDE C/L BREAKS FOR TOWN HIGHWAYS) S=SOLID, D=DASHED

ROCHESTER:	LT	℄	RT
STA. 80+00.00 - STA. 94+25.00	S	-	S
STA. 94+25.00 - STA. 96+00.00	S	-	D

646.602 TEMPORARY 4 INCH WHITE LINE, PAINT
(ALL LINES WILL INCLUDE EDGE LINE BREAKS AND RADIUS FOR TOWN HIGHWAYS)

ROCHESTER:
STA. 80+00.00 - STA. 96+00.00 LT & RT

646.612 TEMPORARY 4 INCH YELLOW LINE, PAINT
(ALL LINES WILL INCLUDE C/L BREAKS FOR TOWN HIGHWAYS) S=SOLID, D=DASHED

ROCHESTER:	LT	℄	RT
STA. 80+00.00 - STA. 94+25.00	S	-	S
STA. 94+25.00 - STA. 96+00.00	S	-	D

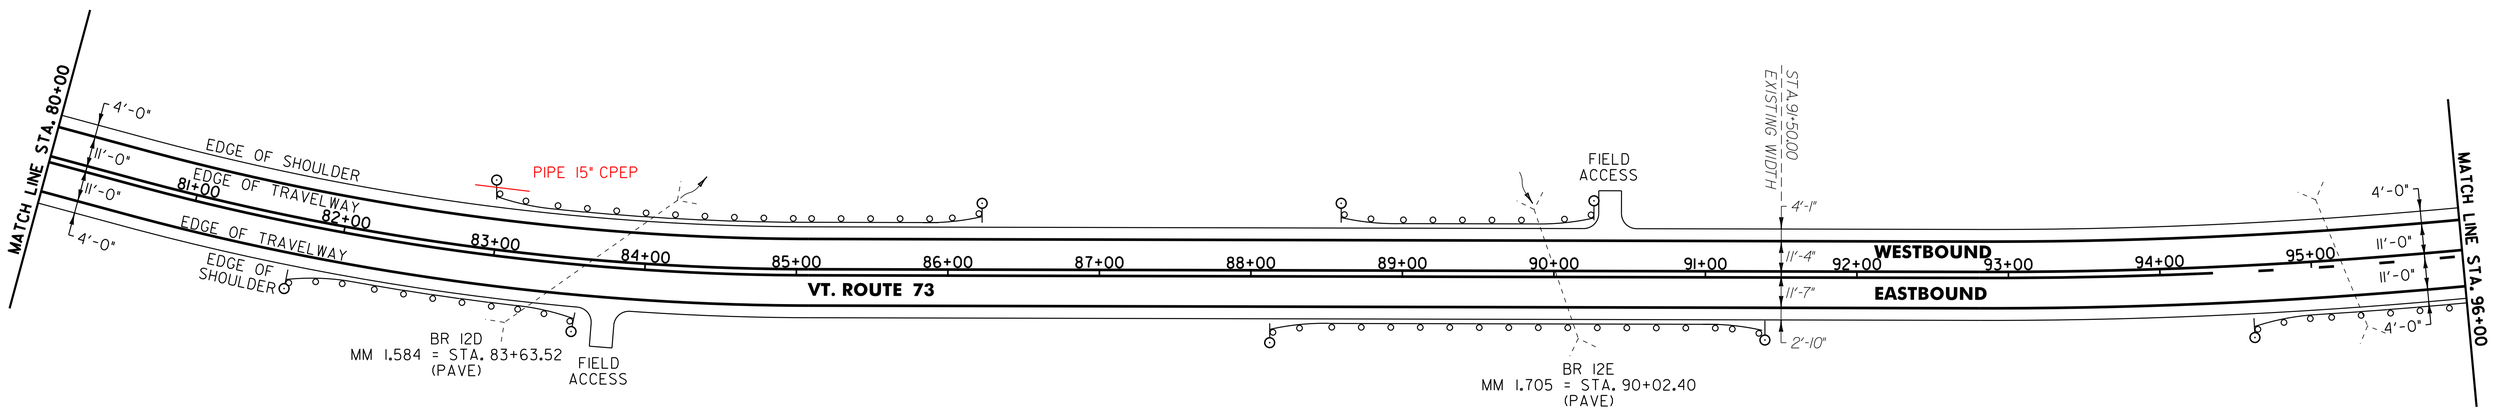

621.80 REMOVAL AND DISPOSAL OF GUARDRAIL

ROCHESTER:
STA. 82+43.0 - STA. 83+56.0 RT (113.0 LF)
STA. 83+12.0 - STA. 84+67.0 LT (155.0 LF)
STA. 89+03.0 - STA. 90+92.0 RT (189.0 LF)
STA. 89+06.0 - STA. 90+22.0 LT (116.0 LF)
STA. 95+07.5 - STA. 96+00.0 RT (93.0 LF)

676.10 DELINEATOR WITH STEEL POST

TYPE I WHITE

ROCHESTER:
STA. 81+68.5 RT
STA. 82+97.5 LT
STA. 83+56.0 RT
STA. 86+22.5 LT
STA. 88+12.5 RT
STA. 88+59.5 LT
STA. 90+22.0 LT
STA. 91+37.5 RT
STA. 94+60.0 RT

900.620 SPECIAL PROVISION (MANUFACTURED TERMINAL SECTION, FLARED/WEATHERING)

ROCHESTER:
STA. 81+68.5 - STA. 82+06.0 RT
STA. 82+97.5 - STA. 83+35.0 LT
STA. 83+18.5 - STA. 83+56.0 RT
STA. 85+85.0 - STA. 86+22.5 LT
STA. 88+12.5 - STA. 88+50.0 RT
STA. 88+59.5 - STA. 88+97.0 LT
STA. 89+84.5 - STA. 90+22.0 LT
STA. 91+00.0 - STA. 91+37.5 RT
STA. 94+60.0 - STA. 94+97.5 RT

900.640 SPECIAL PROVISION (STEEL BEAM GUARDRAIL, WEATHERING)

ROCHESTER:
STA. 82+06.0 - STA. 83+18.5 RT (112.5 LF)
STA. 83+35.0 - STA. 85+85.0 LT (250.0 LF)
STA. 88+50.0 - STA. 91+00.0 RT (250.0 LF)
STA. 88+97.0 - STA. 89+84.5 LT (87.5 LF)

900.640 SPECIAL PROVISION (STEEL BEAM GUARDRAIL, WEATHERING W/8 FEET POSTS)

ROCHESTER:
STA. 94+97.5 - STA. 96+00.0 RT (102.5 LF)

NOT TO SCALE

PROJECT LAYOUT SHEET #6

PROJECT NAME: ROCHESTER-CHITTENDEN-ROCHESTER
PROJECT NUMBER: STP 2505(1)S

FILE NAME: p05c046.dgn	PLOT DATE: $DATE$
PROJECT LEADER: D.E.G.	DRAWN BY: C.A.K.
DESIGNED BY: J.S.P.	CHECKED BY: D.E.G.
IPARM FILE: p05c046106.i	SHEET 18 OF 56