646.402 DURABLE 4 INCH WHITE LINE, THERMOPLASTIC
(ALL LINES WILL INCLUDE EDGE LINE BREAKS AND RADIUS FOR TOWN HIGHWAYS)

ROCHESTER:
STA. 240+00.00 - STA. 251+85.60 LT & RT

CHITTENDEN:
STA. 0+00.00 - STA. 4+00.00 LT & RT

646.412 DURABLE 4 INCH YELLOW LINE, THERMOPLASTIC
(ALL LINES WILL INCLUDE C/L BREAKS FOR TOWN HIGHWAYS) S=SOLID, D=DASHED

	LT	℄	RT
ROCHESTER:			
STA. 240+00.00 - STA. 251+85.60	S	-	S
CHITTENDEN:			
STA. 0+00.00 - STA. 4+00.00	S	-	S

646.602 TEMPORARY 4 INCH WHITE LINE, PAINT
(ALL LINES WILL INCLUDE EDGE LINE BREAKS AND RADIUS FOR TOWN HIGHWAYS)

ROCHESTER:
STA. 240+00.00 - STA. 251+85.60 LT & RT

CHITTENDEN:
STA. 0+00.00 - STA. 4+00.00 LT & RT

646.612 TEMPORARY 4 INCH YELLOW LINE, PAINT
(ALL LINES WILL INCLUDE C/L BREAKS FOR TOWN HIGHWAYS) S=SOLID, D=DASHED

	LT	℄	RT
ROCHESTER:			
STA. 240+00.00 - STA. 251+85.60	S	-	S
CHITTENDEN:			
STA. 0+00.00 - STA. 4+00.00	S	-	S

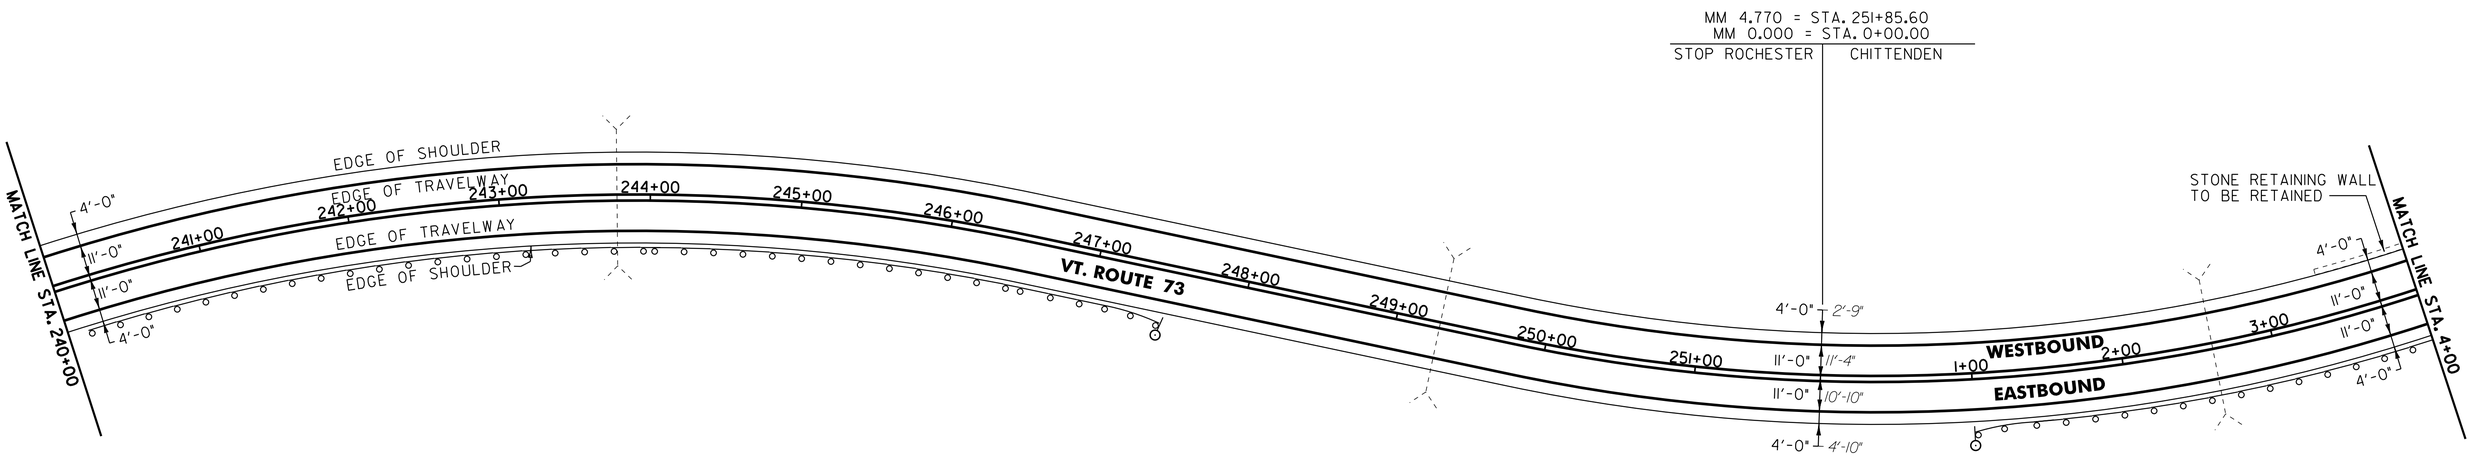

621.80 REMOVAL AND DISPOSAL OF GUARDRAIL

ROCHESTER:
STA. 240+00.0 - STA. 247+45.0 RT (745.0 LF)

CHITTENDEN:
STA. 1+48.0 - STA. 4+00.0 RT (252.0 LF)

676.10 DELINEATOR WITH STEEL POST

TYPE 1 WHITE
ROCHESTER:
STA. 247+47.5 RT
CHITTENDEN:
STA. 1+00.0 RT

900.620 SPECIAL PROVISION (MANUFACTURED TERMINAL SECTION, FLARED/WEATHERING)

ROCHESTER:
STA. 247+10.0 - STA. 247+47.5 RT

CHITTENDEN:
STA. 1+00.0 - STA. 1+37.5 RT

900.640 SPECIAL PROVISION (STEEL BEAM GUARDRAIL, WEATHERING)

ROCHESTER:
STA. 240+00.0 - STA. 247+10.0 RT (710.0 LF)

CHITTENDEN:
STA. 1+37.5 - STA. 4+00.0 RT (262.5 LF)

NOT TO SCALE

PROJECT LAYOUT SHEET #16

PROJECT NAME: ROCHESTER-CHITTENDEN-ROCHESTER
PROJECT NUMBER: STP 2505(1)S

FILE NAME: p05c046.dgn	PLOT DATE: $DATE$
PROJECT LEADER: D.E.G.	DRAWN BY: C.A.K.
DESIGNED BY: J.S.P.	CHECKED BY: D.E.G.
IPARM FILE: p05c046116.i	SHEET 28 OF 56