646.402 DURABLE 4 INCH WHITE LINE, THERMOPLASTIC
(ALL LINES WILL INCLUDE EDGE LINE BREAKS AND RADIUS FOR TOWN HIGHWAYS)
ROCHESTER:
STA. 440+00.00 - STA. 456+00.00 LT & RT

646.412 DURABLE 4 INCH YELLOW LINE, THERMOPLASTIC
(ALL LINES WILL INCLUDE C/L BREAKS FOR TOWN HIGHWAYS) S=SOLID, D=DASHED

| ROCHESTER: | LT | ℄ | RT |
|---|---|---|---|
| STA. 440+00.00 - STA. 456+00.00 | S | - | S |

646.492 DURABLE LETTER OR SYMBOL, THERMOPLASTIC
ROCHESTER:
STA. 455+08.8 RT, "S,T,O,P" (4 EA)
STA. 455+49.2 RT, "A,H,E,A,D" (5 EA)

646.692 TEMPORARY LETTER OR SYMBOL, PAINT
ROCHESTER:
STA. 455+08.8 RT, "S,T,O,P" (4 EA)
STA. 455+49.2 RT, "A,H,E,A,D" (5 EA)

646.602 TEMPORARY 4 INCH WHITE LINE, PAINT
(ALL LINES WILL INCLUDE EDGE LINE BREAKS AND RADIUS FOR TOWN HIGHWAYS)
ROCHESTER:
STA. 440+00.00 - STA. 456+00.00 LT & RT

646.612 TEMPORARY 4 INCH YELLOW LINE, PAINT
(ALL LINES WILL INCLUDE C/L BREAKS FOR TOWN HIGHWAYS) S=SOLID, D=DASHED

| ROCHESTER: | LT | ℄ | RT |
|---|---|---|---|
| STA. 440+00.00 - STA. 456+00.00 | S | - | S |

675.50 REMOVING SIGNS
AS SHOWN - 1

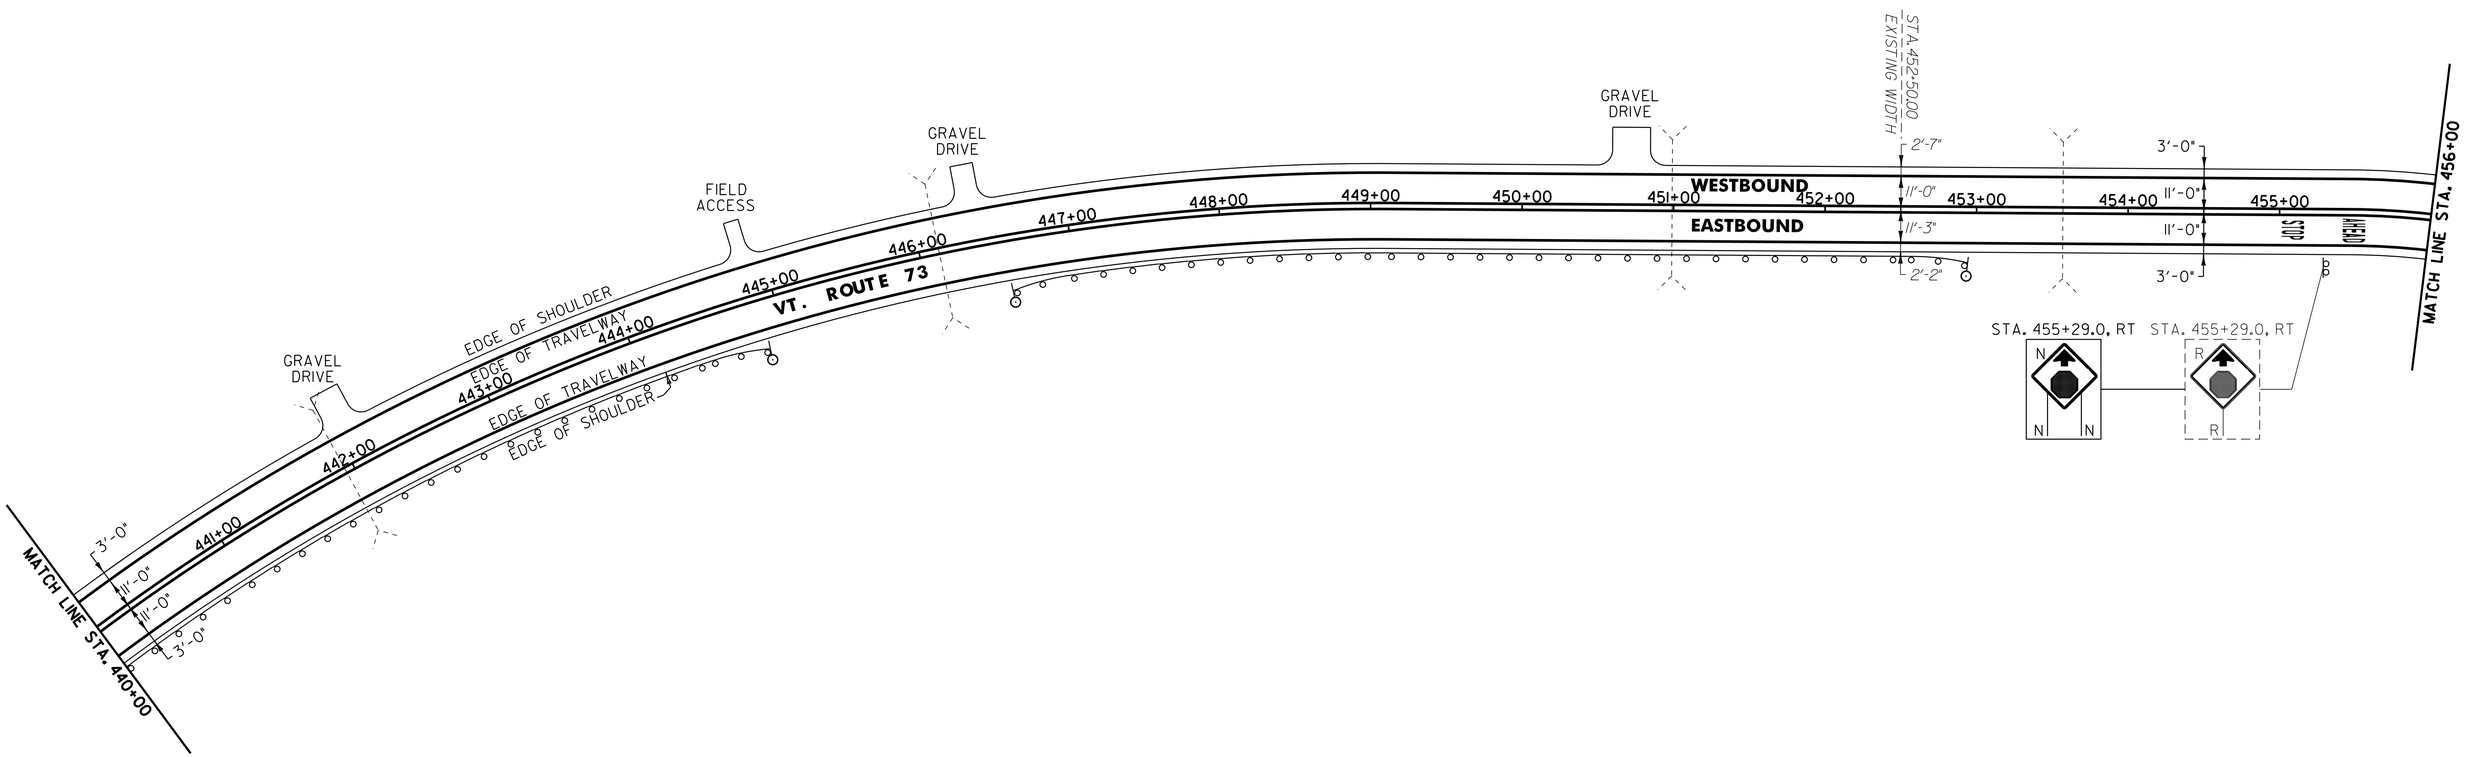


621.20 STEEL BEAM GUARDRAIL, GALVANIZED
ROCHESTER:
STA. 440+00.0 - STA. 444+50.0 RT (450.0 LF)
STA. 446+94.5 - STA. 452+57.0 RT (562.5 LF)

621.50 MANUFACTURED TERMINAL SECTION, FLARED
ROCHESTER:
STA. 444+50.0 - STA. 444+87.5 RT
STA. 446+57.0 - STA. 446+94.5 RT
STA. 452+57.0 - STA. 452+94.5 RT

621.80 REMOVAL AND DISPOSAL OF GUARDRAIL
ROCHESTER:
STA. 440+00.0 - STA. 444+06.0 RT (406.0 LF)
STA. 448+83.0 - STA. 451+68.0 RT (285.0 LF)

676.10 DELINEATOR WITH STEEL POST
TYPE 1 WHITE
ROCHESTER:
STA. 444+87.5 RT
STA. 446+57.0 RT
STA. 452+94.5 RT

SIGN LEGEND
R = REMOVE
S = SALVAGE
N = NEW
RET = RETAIN
B-B = BACK TO BACK
EXISTING = - - - - - - -
NEW = ————

NOT TO SCALE

**PROJECT LAYOUT SHEET #29**

PROJECT NAME: ROCHESTER-CHITTENDEN-ROCHESTER
PROJECT NUMBER: STP 2505(1)S

FILE NAME: p05c046.dgn
PROJECT LEADER: D.E.G.
DESIGNED BY: J.S.P.
IPARM FILE: p05c046129.i
PLOT DATE: $DATE$
DRAWN BY: C.A.K.
CHECKED BY: D.E.G.
SHEET 41 OF 56