STATE OF VERMONT
AGENCY OF TRANSPORTATION

TRAFFIC SIGN SUMMARY SHEET

MILEMARKER, STATION, OR SIGN NUMBER	SIGN LEGEND	SIGN DIMENSIONS EA	WIDTH (in)	HEIGHT (in)	NEW & SALVAGED SIGNS "A"	"B"	SALV SIGN	SALV TIS	EXIST POST RETAIN	SALVAGE	NEW SIGN POSTS NO. OF POSTS	FLANGED CHANNEL lb/ft 1.12	2.0	3.0	SQUARE STEEL (in) 1.75 lb/ft 1.88	2.0 lb/ft 2.16	2.5 lb/ft 3.35	ANCHOR	SLEEVE	TUBULAR ALUMINUM Ø (in) 3.0 lb/ft 1.3	4.0 lb/ft 1.7	4.0 MOD 1.7	TUBULAR STEEL Ø (in) FOUNDATION	3.0 lb/ft 7.6	3.5 lb/ft 9.0	4.0 lb/ft 10.8	5.0 lb/ft 14.6	W-SHAPE STEEL FTG. SIZE 24"	30"	WEIGHT	POST SIZE	REQUIRED SIGNS	REMARKS	SIGN DETAIL DETAIL ON SHEET NUMBER	STD. SHEET NUMBER
												OPTION ITEMS																								
~~2+75.00~~ LT 2+45.00	1000 1321 0380	1	6	10	0.42						1	~~6.75'~~ 0																					MOUNTED ON ADDED STOP SIGN POST. SEE BELOW.		E-138
3+15.00 LT	NO PARKING ON THIS SIDE OF LANE	1	24	30	5.00						1			~~12.00'~~ 14'																						E-146
20+30.00 LT	BRIDGE 29 VT 100	1	6	8			1				1		~~9.50'~~ 8'																							E-134
20+45.00 LT	BRICKHOUSE RD	1	24	30			1				1			~~12.00'~~ 10'																			MOUNTED ON ITS OWN POST		E-146
20+45.00 LT	STOP	1	30	30			1				1			12'																			MOUNTED ON ITS OWN POST WITH MILE MARKER		E-143
20+45.00 LT	1000 1321 0382	1	6	10			1																													E-138
4+20.00 RT	BRIDGE 29 VT 100	1	6	8	0.33						1		~~7.50'~~ 8'																							E-134
2+45.00 RT	STOP	1	30	30	6.25						1			12'																			NO STOP SIGN ORIGINALLY - MISSING		E-143

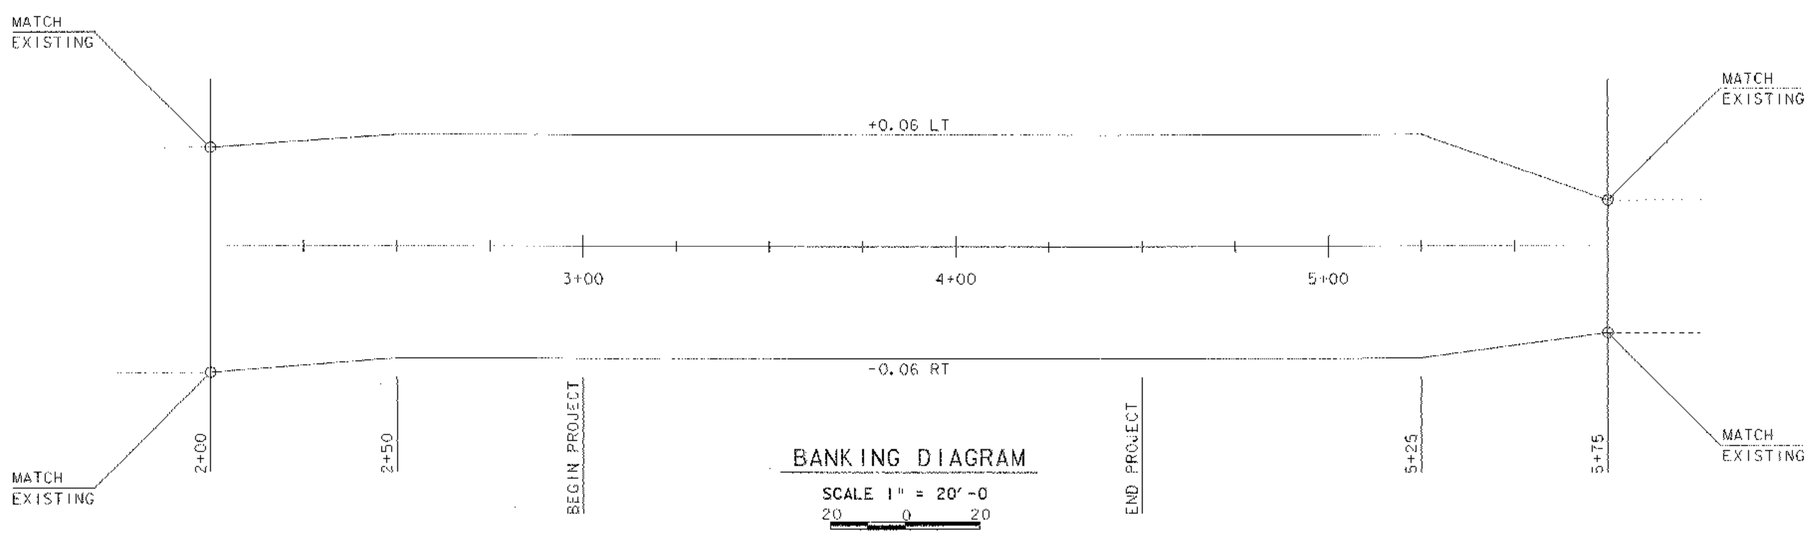

FINAL POST LENGTHS ARE TO BE DETERMINED IN THE FIELD. POST SIZES ARE COMPUTED BASED ON INFORMATION FURNISHED ON THE STANDARD SHEETS AND THE TRAFFIC & SAFETY DIVISION'S "SIGN POST DESIGN GUIDELINE."

TOTALS	SF	SF	EA.	SF		FT	FT	FT		EA	LB	LB	LB		LB	LB	LB	LB			
	~~5.75~~ 12		4			~~6.75~~ 0	~~17.0~~ 16	~~24.0~~ 48													
						FT	FT	FT			LB			EA.	LB				EA.	EA.	LB
						~~47.75~~ 64															

PROJECT NAME: WHITINGHAM
PROJECT NUMBER: ST CULV(6)

FILE NAME: structures/s05c128tss.dgn
PROJECT LEADER: C.P.WILLIAMS
DESIGNED BY: E.L.RUSTAY
TRAFFIC SIGN SUMMARY

PLOT DATE: 08-MAR-2006
DRAWN BY: E.L.RUSTAY
CHECKED BY: M.GAGULIC
SHEET 11 OF 34