NOTES

1. INSTALL SILT FENCE TO CONTROL SEDIMENT FROM DISTURBED SOILS. INSTALL WHEN NEEDED.
2. SEED AND MULCH DISTURBED AREAS AS REQUIRED. SEE EROSION CONTROL NARRATIVE ON SHEET #26.
3. INSTALL EROSION CONTROL MATTING ON DISTURBED SLOPES GREATER THAN 1:3.

EROSION AND SEDIMENT CONTROL INDEX	
NO.	DESCRIPTION
1	INSTALL SILT FENCE TO CONTAIN SEDIMENT AS REQUIRED
2	PROJECT LIMITS DEMARCATION FENCE (SNOW FENCE (MOD.-PDF))
3	TURBIDITY CURTAIN
4	SEED AND MULCH. Apply to disturbed areas as needed.
5	EROSION CONTROL MATTING

NOTE: ALL DISTURBED AREAS WITH SLOPES GREATER THAN 1:3 WILL REQUIRE TEMPORARY EROSION MATTING. SEE EROSION CONTROL DETAIL SHEETS AND CROSS SECTIONS.

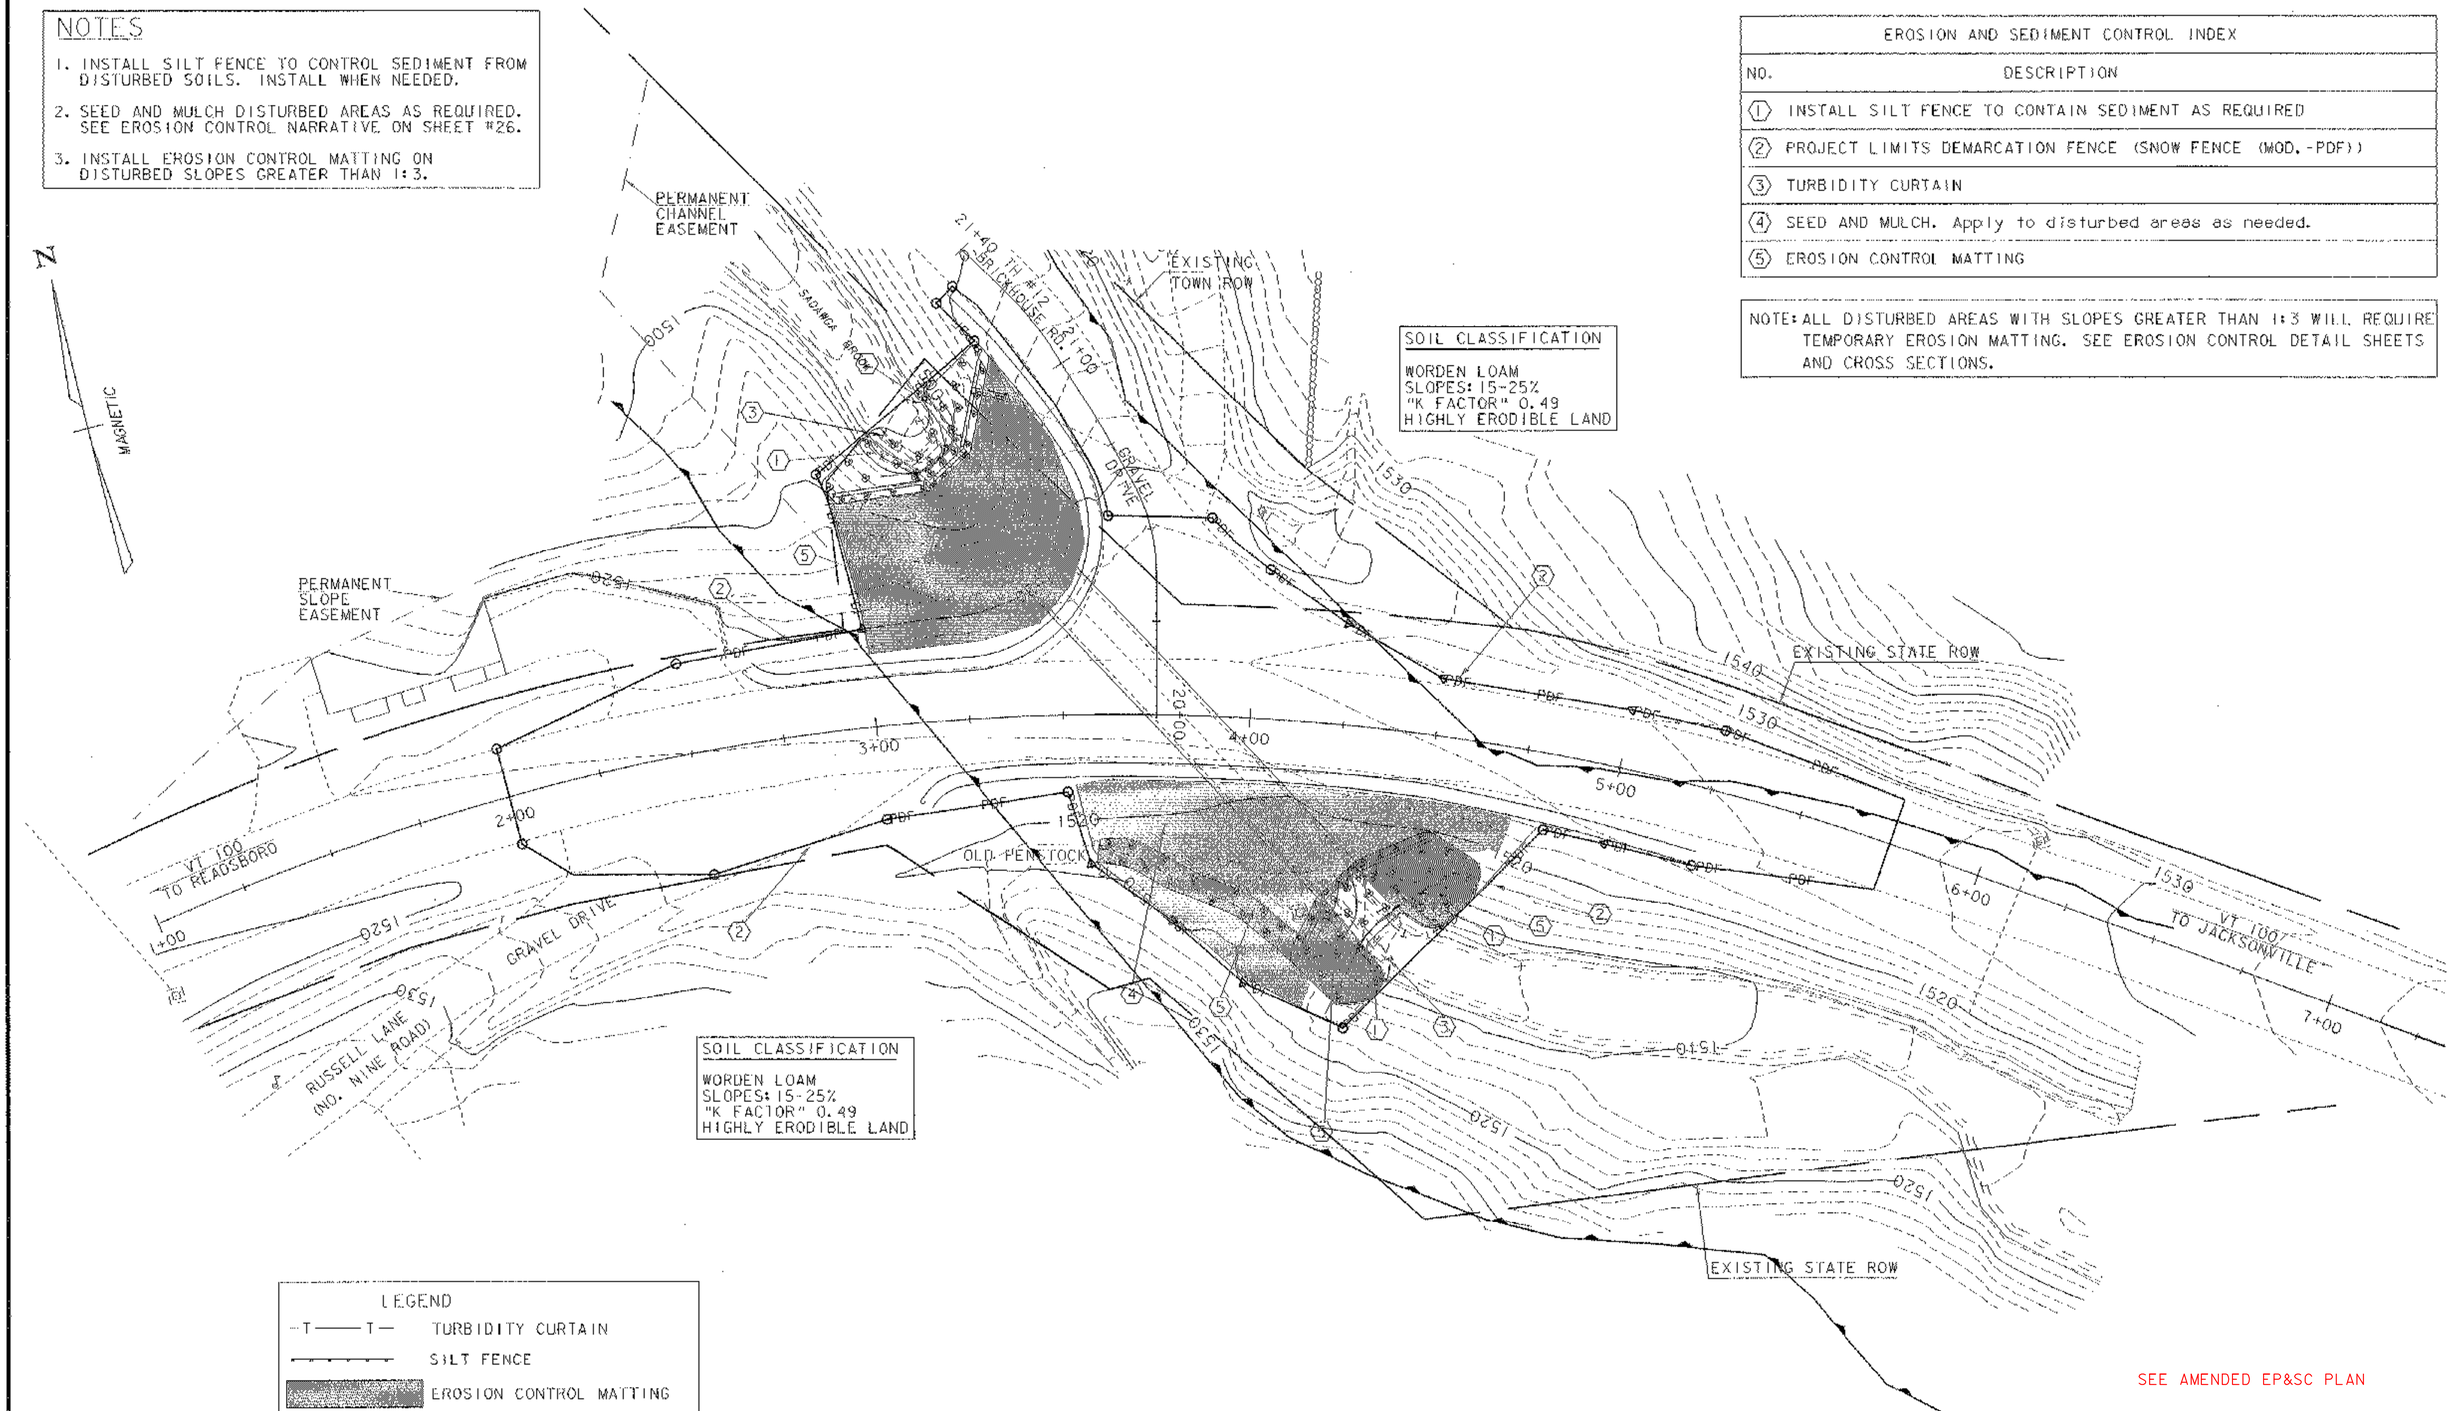

SOIL CLASSIFICATION
WORDEN LOAM
SLOPES: 15-25%
"K FACTOR" 0.49
HIGHLY ERODIBLE LAND

SOIL CLASSIFICATION
WORDEN LOAM
SLOPES: 15-25%
"K FACTOR" 0.49
HIGHLY ERODIBLE LAND

SEE AMENDED EP&SC PLAN

LEGEND

—T——T—	TURBIDITY CURTAIN
	SILT FENCE
	EROSION CONTROL MATTING
	SEED AND MULCH
PDF——PDF	PROJECT DEMARCATION FENCE
	RIPARIAN BUFFER ZONE

DATUM
VERTICAL ASSUMED
HORIZONTAL ASSUMED

EROSION PREVENTION AND SEDIMENT CONTROL PLAN

SCALE 1" = 20'-0
20 0 20

PROJECT: WHITINGHAM	PROJECT NO.: ST CULV (6)
DESIGN FILE NAME: 05c128/Structures/s05c128bdr.dgn	
IPARM FILE NAME: s05c128aro.i	PLOT DATE: 08-MAR-2006
SURVEYED BY: L. ORVIS	SURVEY DATE: 06/2005
SQUAD LEADER: C.P. WILLIAMS	DRAWN BY: M. FESSEL
EROSION & SEDIMENT CONTROL PLAN	SHEET: 28 OF 34