TEMPORARY 4in YELLOW LINE (PAINT)
DURABLE 4in YELLOW LINE (THERMOPLASTIC)

| | |
|---|---|
| STA 257+00 TO 273+25 | SOLID LT&RT |
| STA 266+34 | DOUBLE SOLID RT |
| STA 273+00 | DOUBLE SOLID LT |

(WITH CENTERLINE BREAKS FOR TOWN HIGHWAYS)

TEMPORARY 4in WHITE LINE (PAINT)
DURABLE 4in WHITE LINE (THERMOPLASTIC)

| | |
|---|---|
| STA 257+00 TO 273+25 | SOLID LT&RT |

(WITH EDGELINE BREAKS FOR TOWN HIGHWAYS)

TEMPORARY LETTER OR SYMBOL (PAINT)
DURABLE LETTER OR SYMBOL (THERMOPLASTIC)

| | |
|---|---|
| STA 266+34 | "STOP" |
| STA 273+00 | "STOP" |

TEMPORARY 24in STOP BAR (PAINT)
DURABLE 24in STOP BAR (THERMOPLASTIC)

| | |
|---|---|
| STA 266+34 | TH #2 |
| STA 273+00 | TH #73 |

TEMPORARY CROSSWALK (PAINT)

| | |
|---|---|
| STA 265+65 LT&RT | US ROUTE 7 |
| STA 265+90 TO 266+55 RT | MAIN STREET INT. |

DURABLE CROSSWALK (TYPE I TAPE)
(REFER TO DETAIL ON SHEET 43)

| | |
|---|---|
| STA 265+90 TO 266+55 RT | MAIN STREET INT. |

DURABLE CROSSWALK MARKINGS, IMPRINTED/COLORIZED
(REFER TO DETAIL ON SHEET 43)

| | |
|---|---|
| STA 265+65 LT&RT | US ROUTE 7 |

REMOVING SIGNS
6

ADJUST ELEVATION OF VALVE BOX

STA 257+50 LT
STA 258+82 LT
STA 263+00 RT
STA 265+15 LT
STA 266+40 LT - 3
STA 266+78 LT

CHANGE ELEVATION OF SEWER MANHOLE

STA 258+80 RT
STA 263+00 RT
STA 266+15 RT
STA 266+78 RT
STA 267+40 RT

ADJUST ELEVATION OF GAS VALVES
(TO BE DONE BY OTHERS)

STA 264+08 RT

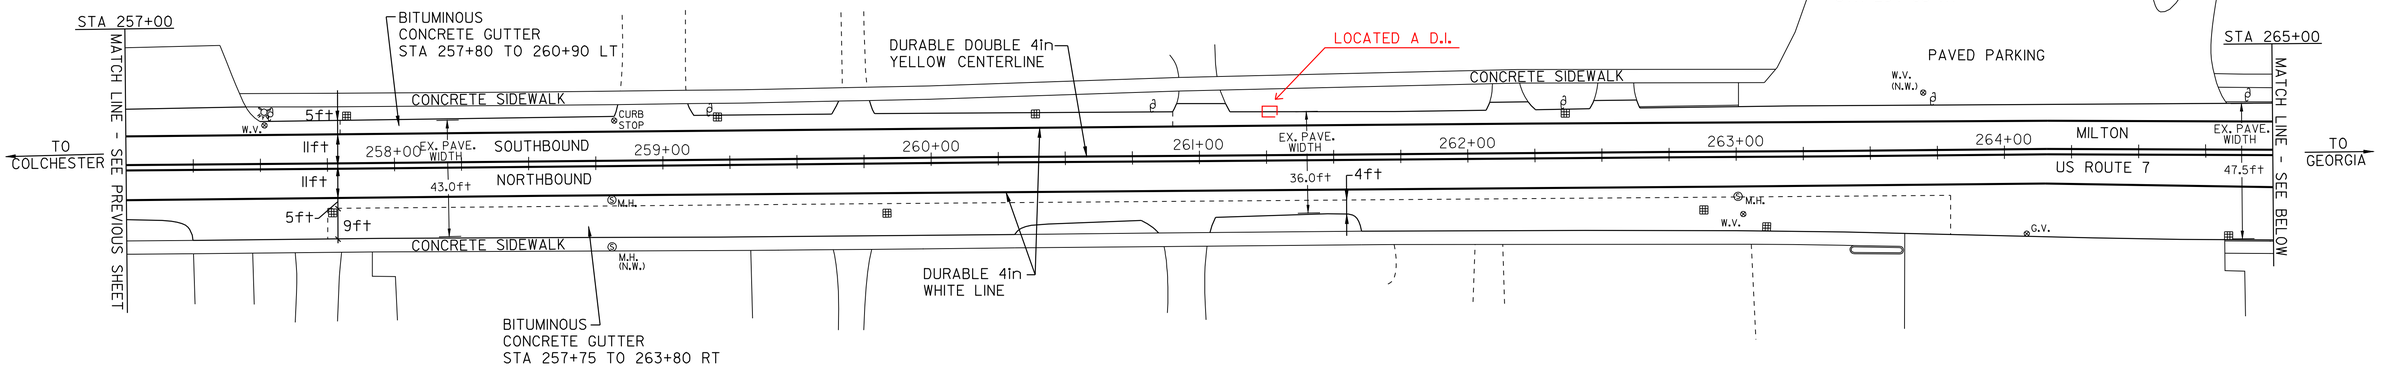


BITUMINOUS CONCRETE GUTTER
(SEE DETAIL, SHEET 3)

| | |
|---|---|
| STA 257+75 TO 263+80 RT | |
| STA 257+80 TO 260+90 LT | |

CHANGE ELEVATION OF D.I.'S, C.B.'S, OR M.H.'S

STA 257+75 RT
STA 259+83 RT
STA 263+10 RT
STA 264+85 RT
STA 266+00 RT
STA 266+42 RT
STA 267+10 LT
STA 271+57 LT
STA 271+85 RT

REHABILITATION OF D.I.'S, C.B.'S, OR M.H.'S

STA 257+80 LT
STA 259+20 LT
STA 260+40 LT
STA 262+35 LT
STA 262+90 RT

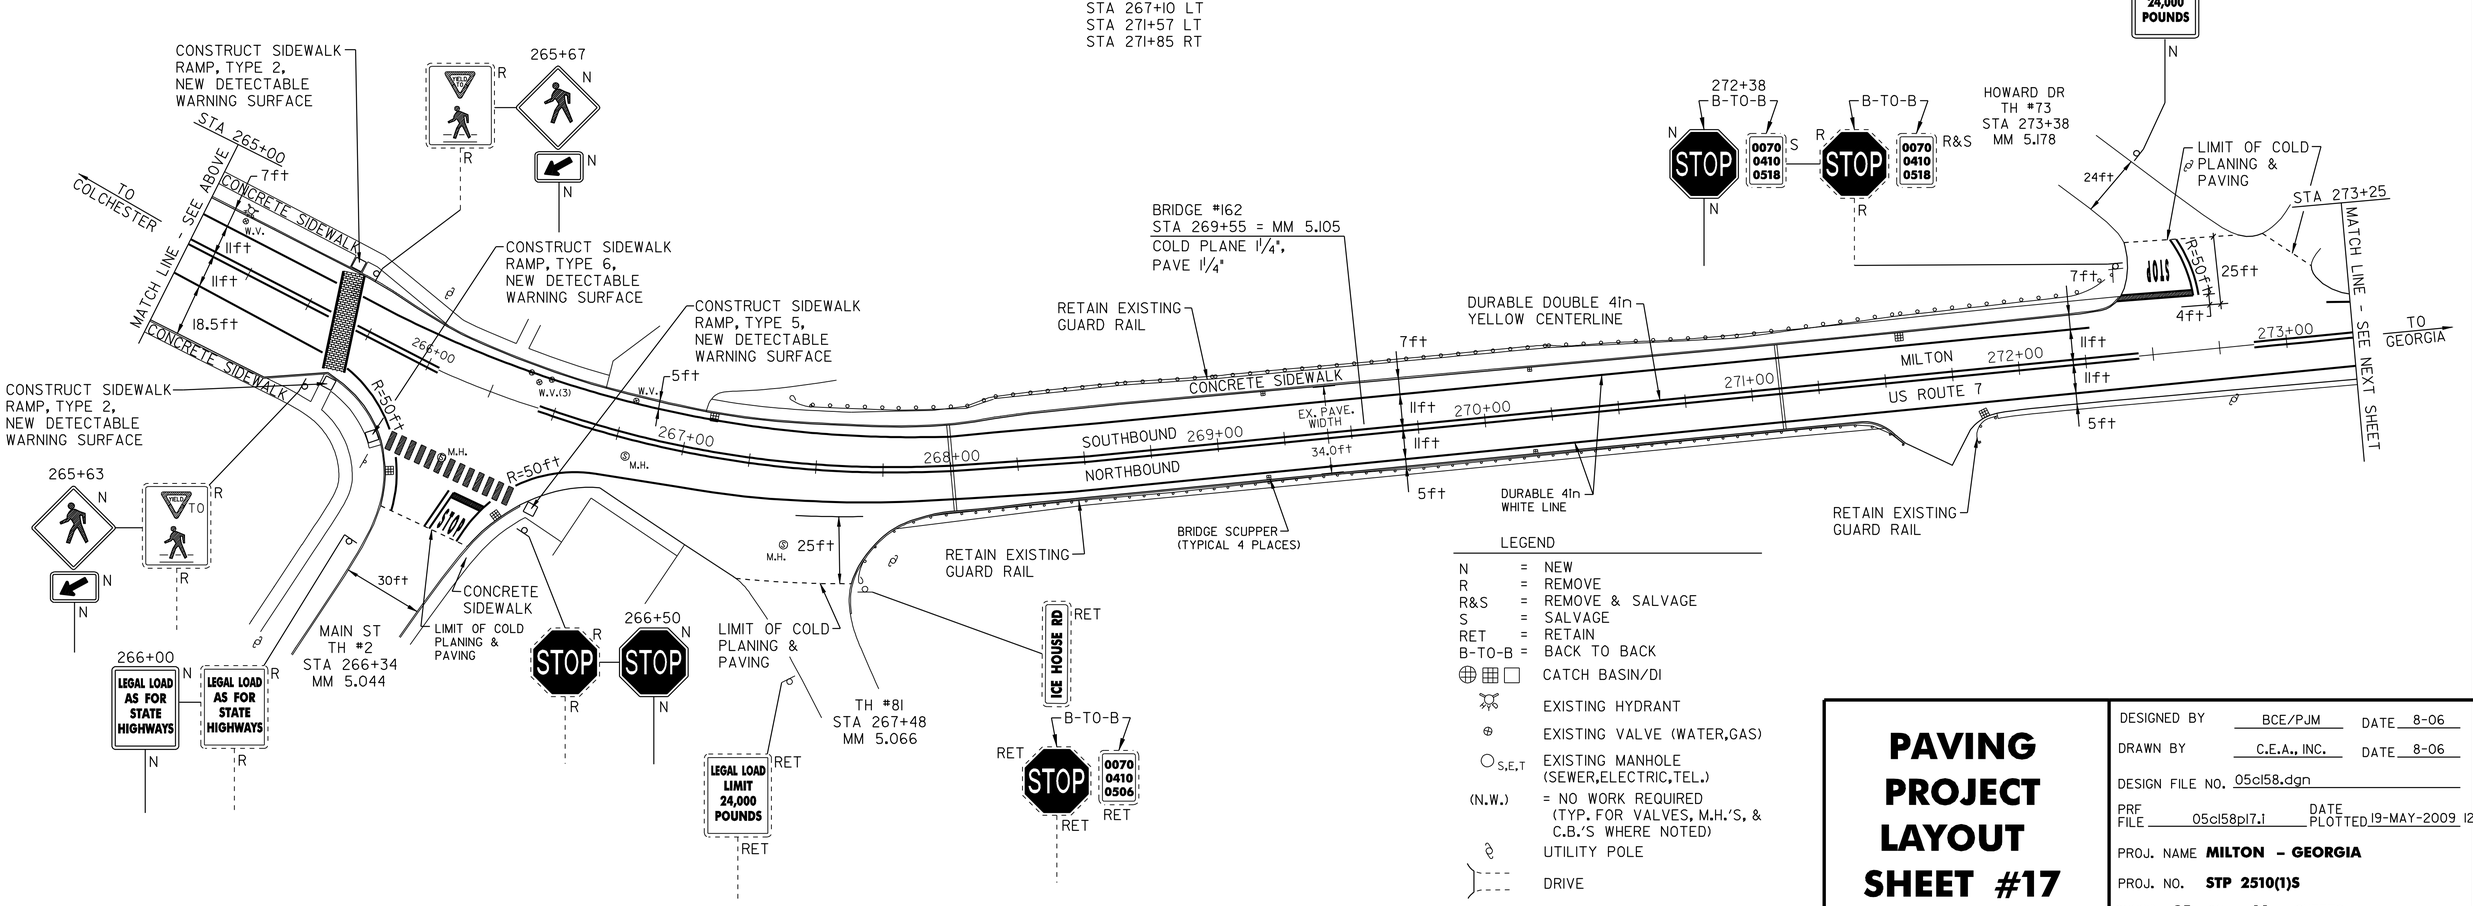


LEGEND

| | | |
|---|---|---|
| N | = | NEW |
| R | = | REMOVE |
| R&S | = | REMOVE & SALVAGE |
| S | = | SALVAGE |
| RET | = | RETAIN |
| B-TO-B | = | BACK TO BACK |
| | | CATCH BASIN/DI |
| | | EXISTING HYDRANT |
| | | EXISTING VALVE (WATER,GAS) |
| S,E,T | | EXISTING MANHOLE (SEWER,ELECTRIC,TEL.) |
| (N.W.) | = | NO WORK REQUIRED (TYP. FOR VALVES, M.H.'S, & C.B.'S WHERE NOTED) |
| | | UTILITY POLE |
| | | DRIVE |

# PAVING PROJECT LAYOUT SHEET #17

DESIGNED BY BCE/PJM DATE 8-06
DRAWN BY C.E.A., INC. DATE 8-06
DESIGN FILE NO. 05c158.dgn
PRF FILE 05c158pl7.1 DATE PLOTTED 19-MAY-2009 12
PROJ. NAME **MILTON - GEORGIA**
PROJ. NO. **STP 2510(1)S**
SHEET **25** OF **44** SHEETS