TEMPORARY 4in YELLOW LINE (PAINT)
DURABLE 4in YELLOW LINE (THERMOPLASTIC)

STA 297+00 TO 297+15	SOLID LT & DASHED RT
STA 297+15 TO 302+47	DASHED
STA 302+47 TO 308+25	DASHED LT & SOLID RT
STA 308+25 TO 313+50	SOLID LT&RT
STA 310+30	SOLID LT&RT
STA 311+20	SOLID LT&RT

(WITH CENTERLINE BREAKS FOR TOWN HIGHWAYS)

TEMPORARY 4in WHITE LINE (PAINT)
DURABLE 4in WHITE LINE (THERMOPLASTIC)

STA 297+00 TO 313+50 SOLID LT&RT
(WITH EDGELINE BREAKS FOR TOWN HIGHWAYS)

TEMPORARY LETTER OR SYMBOL (PAINT)
DURABLE LETTER OR SYMBOL (THERMOPLASTIC)

STA 310+30 LT	"STOP"
STA 311+10 LT	"STOP"
STA 311+25 LT	** 4 - ▼

** (REFER TO DETAIL ON SHEET 43) **

TEMPORARY 24in STOP BAR (PAINT)
DURABLE 24in STOP BAR (THERMOPLASTIC)

STA 310+30 LT	"TH #3"
STA 311+10 LT	"TH #3"

REMOVING SIGNS
4

DITCHING LOCATIONS (REFER TO SHEET 8 FOR DETAILS)
STA 311+75 TO 313+50 LT

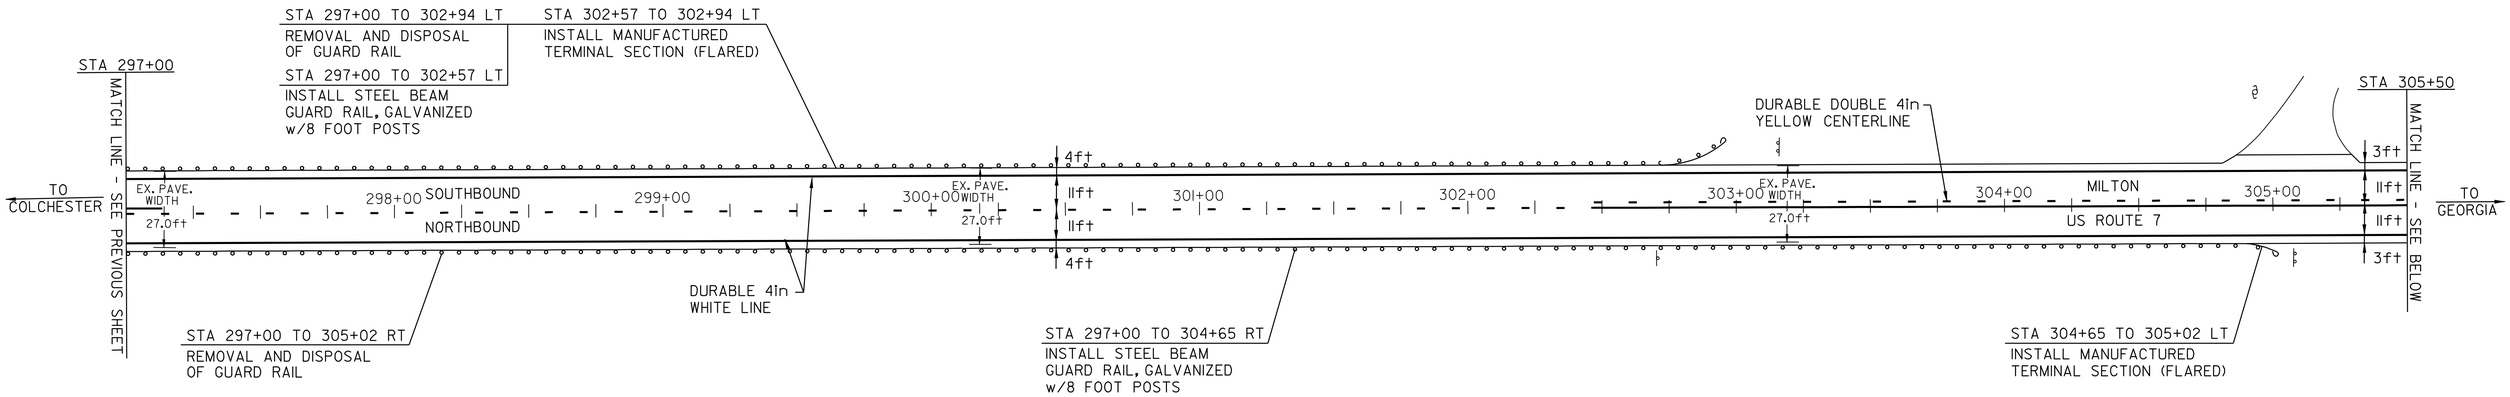

REMOVAL AND DISPOSAL OF GUARD RAIL
STA 297+00 TO 302+94 LT
STA 297+00 TO 305+02 RT

STEEL BEAM GUARD RAIL, GALVANIZED w/8 FOOT POSTS
STA 297+00 TO 302+57 LT
STA 297+00 TO 304+65 RT

MANUFACTURED TERMINAL SECTION, FLARED
STA 302+57 TO 302+94 LT
STA 304+65 TO 305+02 RT

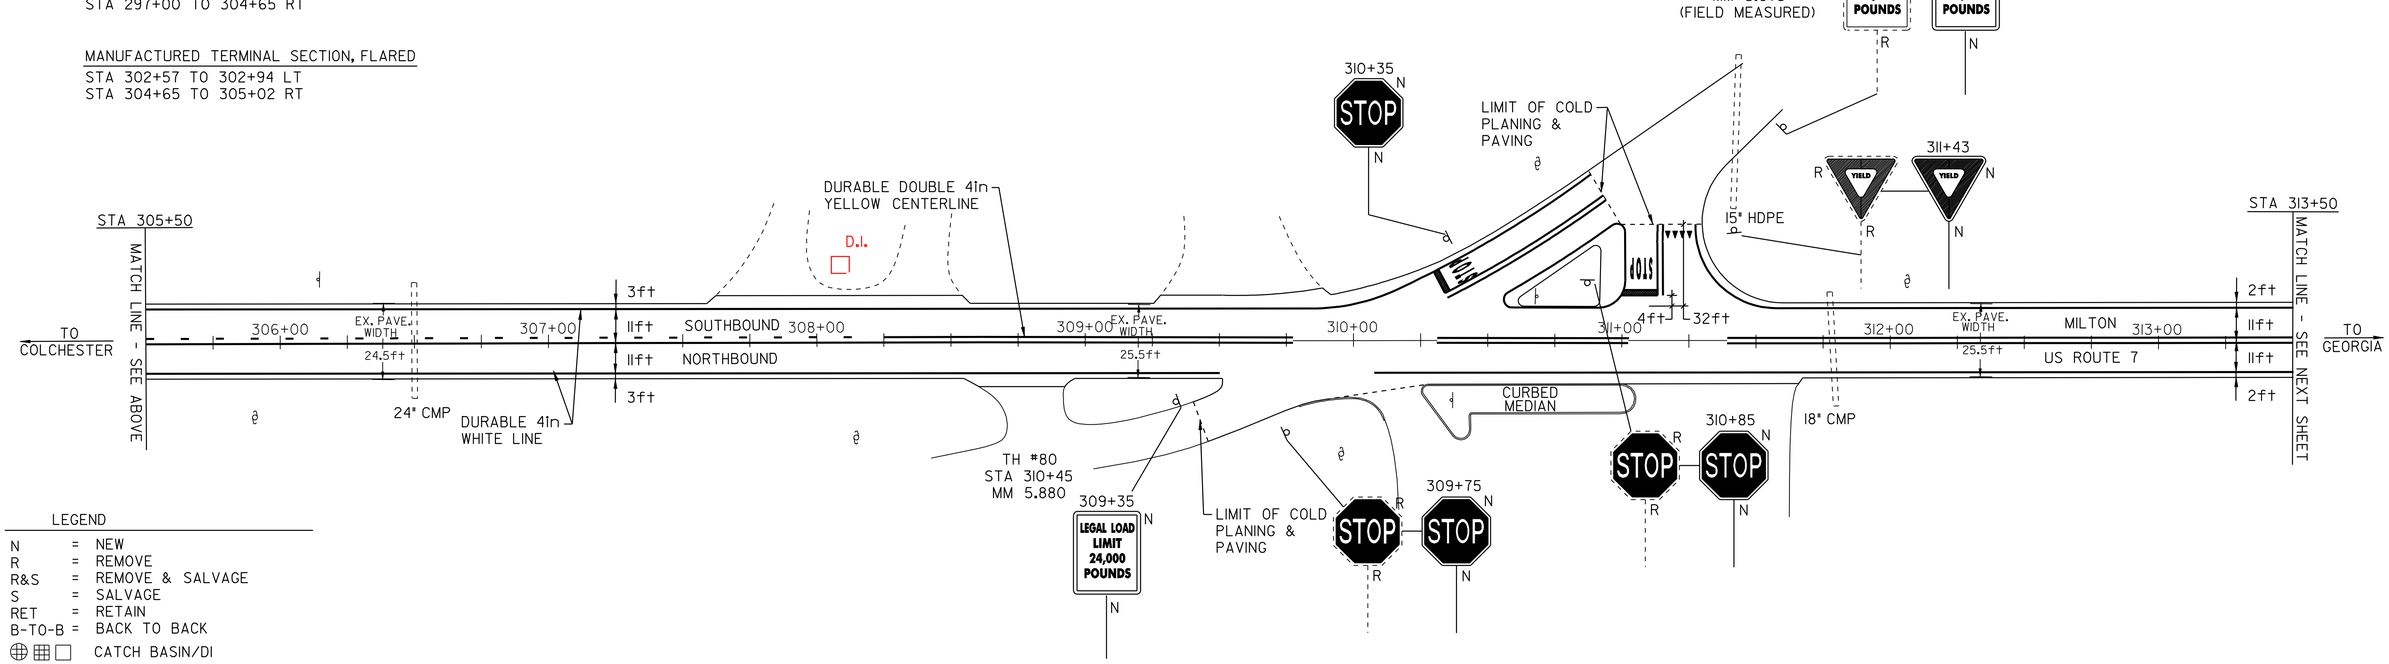

LEGEND

N	=	NEW
R	=	REMOVE
R&S	=	REMOVE & SALVAGE
S	=	SALVAGE
RET	=	RETAIN
B-TO-B	=	BACK TO BACK
⊕ ⊞ □		CATCH BASIN/DI
		EXISTING HYDRANT
		EXISTING VALVE (WATER,GAS)
○ S,E,T		EXISTING MANHOLE (SEWER,ELECTRIC,TEL.)
(N.W.)	=	NO WORK REQUIRED (TYP. FOR VALVES, M.H.'S, & C.B.'S WHERE NOTED)
		UTILITY POLE
		DRIVE

PAVING PROJECT LAYOUT SHEET #19

DESIGNED BY BCE/PJM DATE 8-06
DRAWN BY C.E.A., INC. DATE 8-06
DESIGN FILE NO. 05cl58.dgn
PRF FILE 05cl58pl9.1 DATE PLOTTED 19-MAY-2009 12
PROJ. NAME **MILTON - GEORGIA**
PROJ. NO. **STP 2510(1)S**
SHEET **27** OF **44** SHEETS