STATE OF VERMONT
AGENCY OF TRANSPORTATION

TRAFFIC SIGN SUMMARY SHEET

MILEMARKER, STATION, OR SIGN NUMBER	SIGN LEGEND	SIGN DIMENSIONS EA	WIDTH (in)	HEIGHT (in)	NEW & SALVAGED SIGNS "A"	"B"	SALV SIGN	SALV TIS	EXIST POST RETAIN	EXIST POST SALVAGE	NEW SIGN POSTS NO. OF POSTS	FLANGED CHANNEL lb/ft 1.12	2.0	3.0	SQUARE STEEL (in) lb/ft 1.75 1.88	2.0 2.16	2.5 3.35	ANCHOR	SLEEVE	TUBULAR ALUMINUM Ø (in) lb/ft 3.0 1.3	4.0 1.7	4.0 MOD 1.7	TUBULAR STEEL Ø (in) FOUND-ATION	lb/ft 3.0 7.6	3.5 9.0	4.0 10.8	5.0 14.6	W-SHAPE STEEL FTG. SIZE 24"	30"	WEIGHT	POST SIZE	SIGN FRAME REQUIRED	REMARKS	SIGN DETAIL DETAIL ON SHEET NUMBER	STD. SHEET NUMBER
												OPTION ITEMS																									
35+80 RT	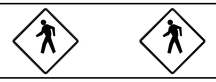	1	30	30	6.25						1					X																	W11-2 B-B WITH W11-2 SIGNS TO BE TYPE IX SHEETING BLACK/ YELLOW-GREEN SEE 2004 STANDARD HIGHWAY SIGN BOOK FOR SIGN DETAIL		
		1	30	30	6.25																														
		1	24	12	2.00																												W16-7P L B-B WITH W16-7P R SIGNS TO BE TYPE IX SHEETING BLACK/ YELLOW-GREEN SEE 2004 STANDARD HIGHWAY SIGN BOOK FOR SIGN DETAIL		
		1	24	12	2.00																														
37+76 RT	WATER ST	1	24	9	1.50						1					X																	STREET SIGN TO BE MOUNTED ABOVE STOP SIGN ON A NEW POST		E-123
		1	30	30	6.25																												R1-1 B-B WITH VR-017 & MILE MARKER SEE 2004 STANDARD HIGHWAY SIGN BOOK FOR SIGN DETAIL		E-141
		1	24	30	5.00																														
		1	6	10	0.42																												VD-700		E-138
37+56 LT	THIS SIGN WAS MOVE TO CORRECT SIDE AS THERE WAS ROOM. 1 NEW POST										1																								
39+28 RT		1	30	30	6.25						1					X																	W11-2 SIGN TO BE TYPE IX SHEETING AND COLORED BLACK/ YELLOW-GREEN SEE 2004 STANDARD HIGHWAY SIGN BOOK FOR SIGN DETAIL		
		1	24	12	2.00																												W16-7P SIGN TO BE TYPE IX SHEETING AND COLORED BLACK/ YELLOW-GREEN SEE 2004 STANDARD HIGHWAY SIGN BOOK FOR SIGN DETAIL		
40+44 LT		1	30	30	6.25						1					X																	W11-2 SIGN TO BE TYPE IX SHEETING AND COLORED BLACK/ YELLOW-GREEN SEE 2004 STANDARD HIGHWAY SIGN BOOK FOR SIGN DETAIL		
		1	24	12	2.00																												W16-7P SIGN TO BE TYPE IX SHEETING AND COLORED BLACK/ YELLOW-GREEN SEE 2004 STANDARD HIGHWAY SIGN BOOK FOR SIGN DETAIL		
43+77 RT	NORTH	1	24	12	2.00						1					X																	M3-1 SEE 2004 STANDARD HIGHWAY SIGN BOOK FOR SIGN DETAIL		
	5	1	24	24	4.00																												M1-4 SEE 2004 STANDARD HIGHWAY SIGN BOOK FOR SIGN DETAIL		
												FT	FT	FT	FT	FT 70.0	FT		EA	LB	LB	LB		LB	LB	LB	LB								
TOTALS		SF 52.17	SF	EA.	SF							FT				FT 70.0				LB			EA.	LB				EA.	EA.	LB					

FINAL POST LENGTHS ARE TO BE DETERMINED IN THE FIELD. POST SIZES ARE COMPUTED BASED ON INFORMATION FURNISHED ON THE STANDARD SHEETS AND THE TRAFFIC & SAFETY DIVISION'S "SIGN POST DESIGN GUIDELINE."

PROJECT NAME:	PUTNEY
PROJECT NUMBER:	STPG SIGN (13)
FILE NAME:	STPG SIGN (13).DGN
PROJECT LEADER:	N. AVERY
DESIGNED BY:	N. AVERY & M. MILLER
SIGN(13)TSS08	
PLOT DATE:	12-DEC-2008 13:2
DRAWN BY:	N. AVERY
CHECKED BY:	A. GAMBLE
SHEET	31 OF 38