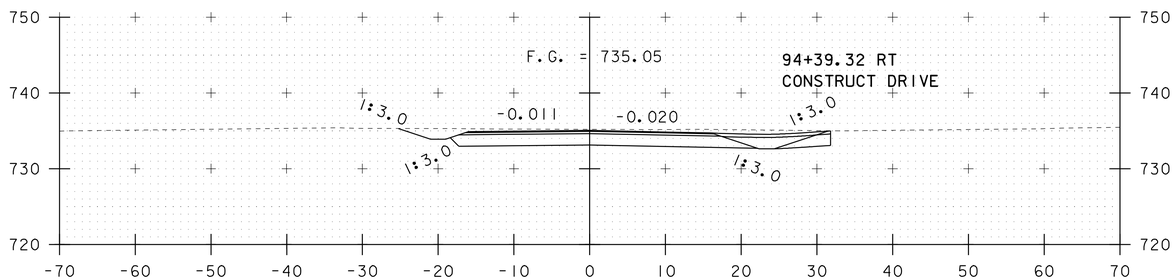

94+50

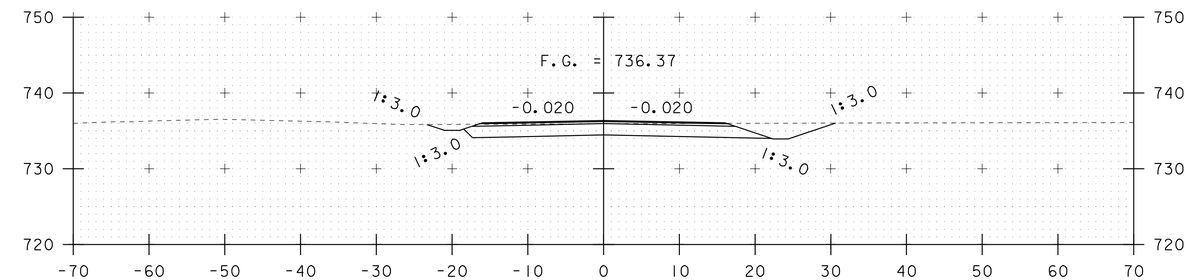

96+00

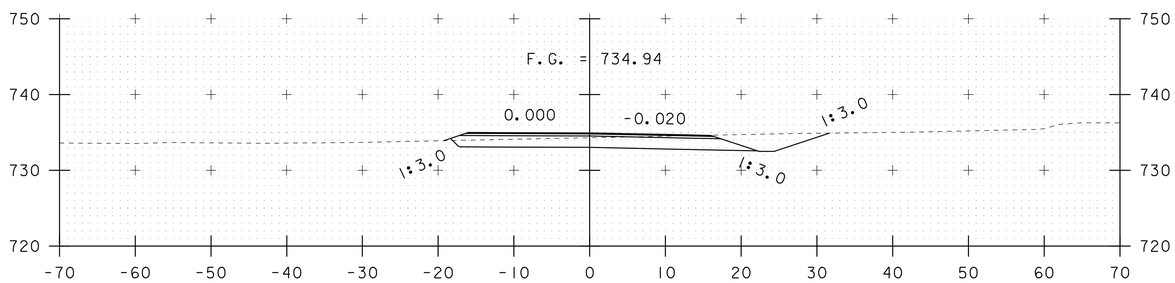

94+00

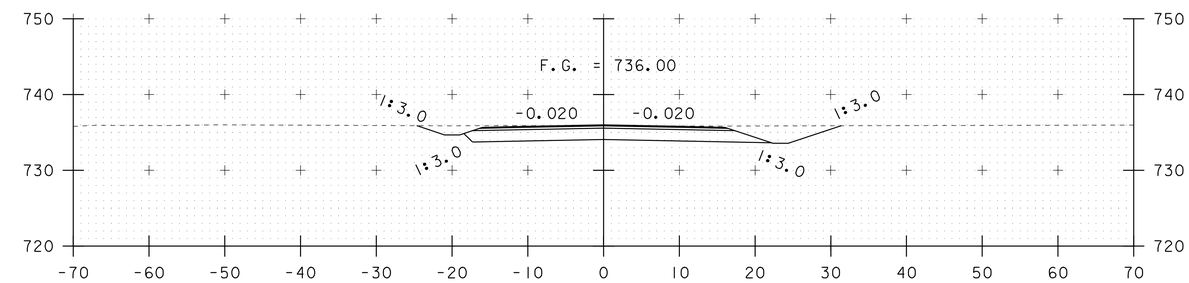

95+50

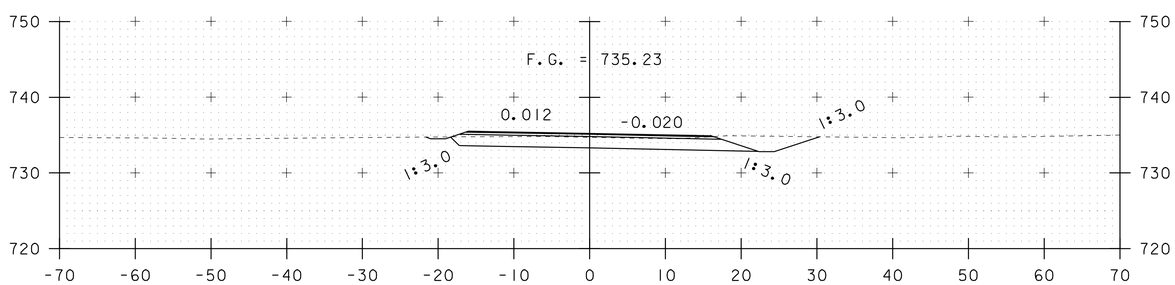

93+50

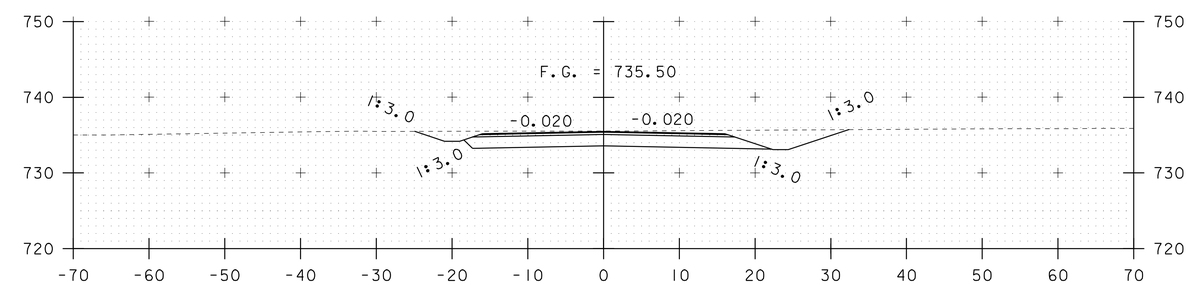

95+00

FRONTAGE ROAD CROSS-SECTION SHEET #2

PROJECT NAME:	BARRE TOWN
PROJECT NUMBER:	ST 0147(16)

FILE NAME: 05E290/Design/D05E290NUI	PLOT DATE: 18-MAR-2008
PROJECT LEADER: R. THOMPSON	DRAWN BY: P. BEYOR
DESIGNED BY: P. BEYOR	CHECKED BY:
D05E290XS2.I	SHEET 23 OF 26

STA. 93+50 TO STA. 96+00