PLANTING SCHEDULE FOR TOWN HALL – WORK WITH TOWN OF HINESBURG FOR EXACT PLANT LOCATIONS

ITEM	QTY#	BOTANICAL NAME	COMMON NAME	SIZE
TREES				
1	2	AMELANCHIER CUMULUS	SERVICEBERRY	2–2½" CALIPER & B&B
2	1	CATALPA SPECIOSA	CATALAPA	1½"–2" CALIPER & B&B
SHRUBS				
3	12	EUONYMUS COLORATUS	WINTERCREEPER	15–18" SPREAD
4	1	HYDRANGEA PANICULATA	HYDRANGEA PEE GEE	5–6' HEIGHT
5	8	MICROBIOTA DECUSSATA	SIBERIAN CYPRESS	12–15" SPREAD
6	7	RHODODENDRON OLGA MEZITT	RHODODENDRON	18–24" HEIGHT
7	4	SYRINGA MEYERII	DWARF KOREAN LILAC	3–4' HEIGHT
8	3	SYRINGA MONGE	MONGE LILAC	4–5' HEIGHT
9	7	TAXUS DENSIFORMIS	DENSE YEW	18–24" HEIGHT
10	15	VACCINIUM ANGUSTIFOLIUM	DWARF BLUEBERRY	18–24" HEIGHT
PERENNIALS				
	12	ASTILBE FANAL	ASTILBE RED	1 GALLON POT
	5	BAPTISIA AUSTRALIS	FALSE BLUE INDIGO	1 GALLON POT
	12	HEUCHERA AMERICANA	"GREEN SPICE" HEUCHERA	1 GALLON POT
	15	LAMIUM 'PINK PEWER'	DEAD NETTLE	4" POT
	30	NARCISSUS 'MT HOOD'	MT HOOD DAFFODIL	DNII
	4	PAEONIFA 'FESTIVA MAXIMA'	PEONY WHITE	2 GALLON POT

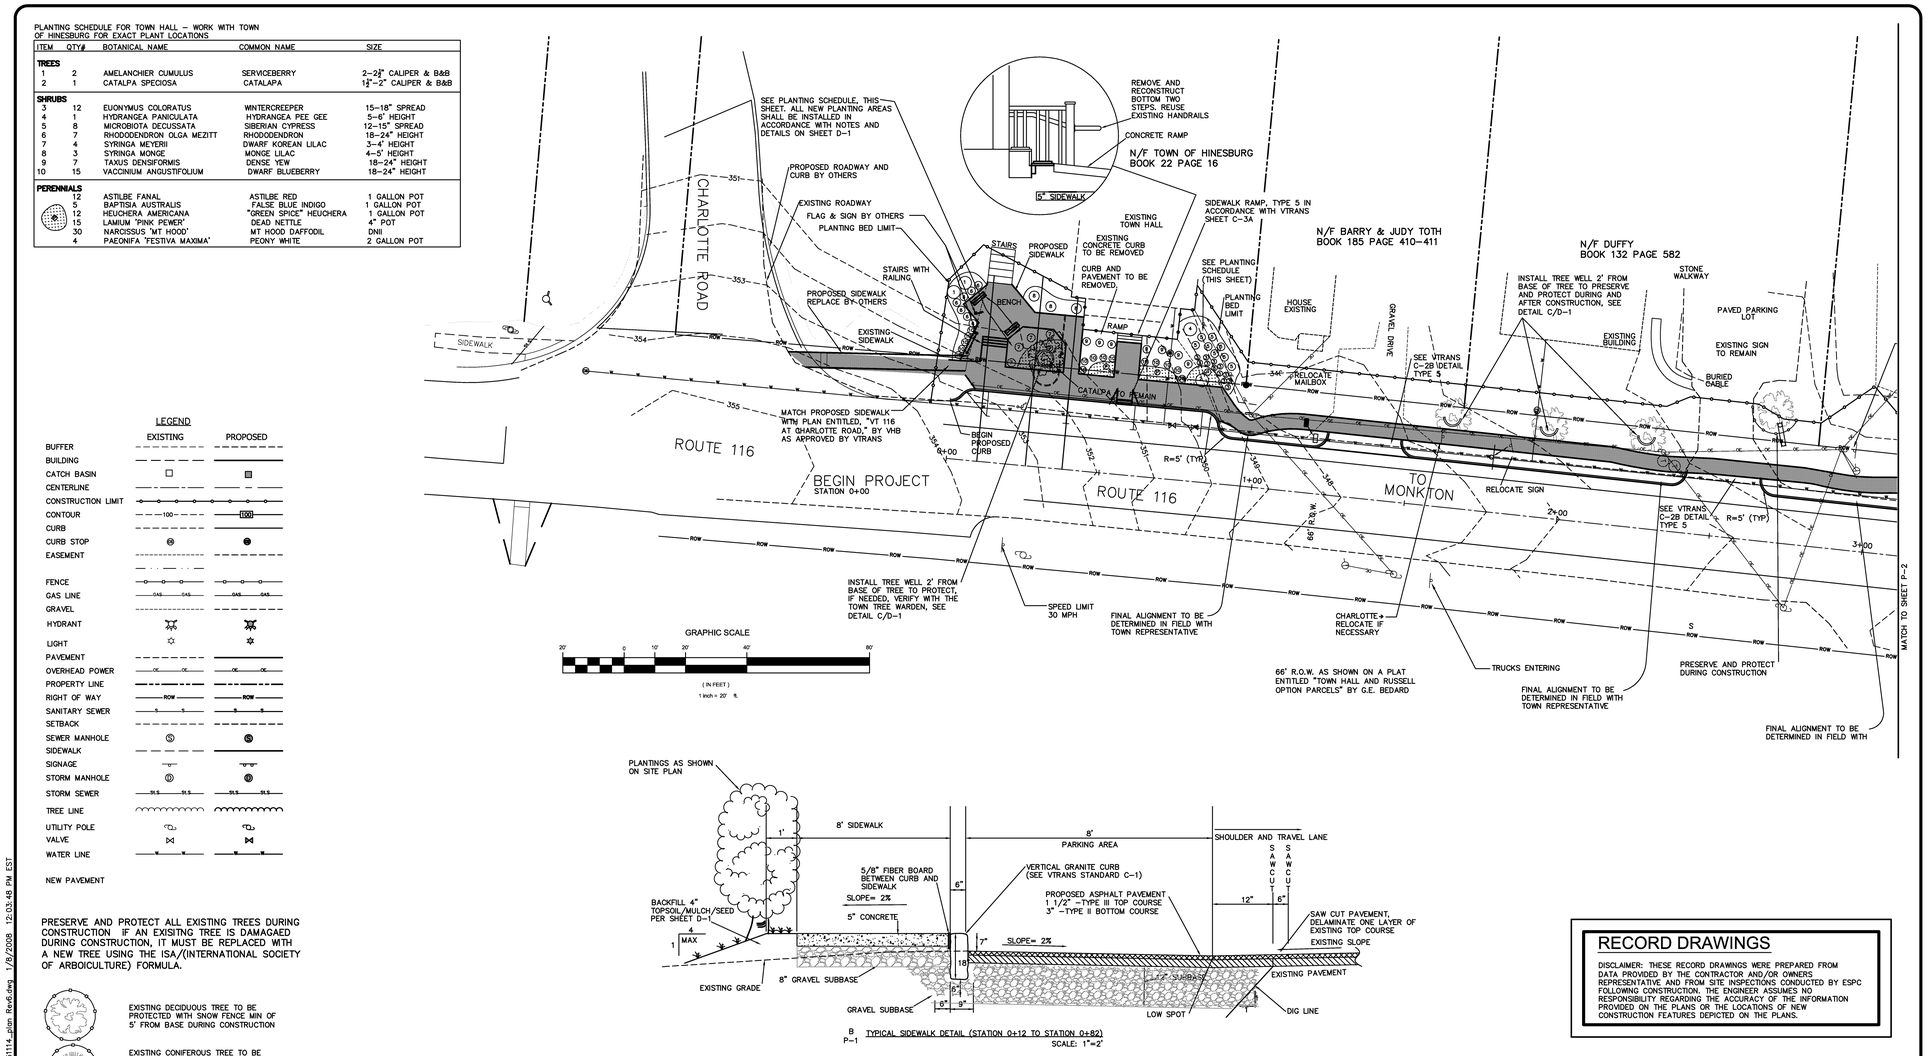

LEGEND

	EXISTING	PROPOSED
BUFFER		
BUILDING		
CATCH BASIN		
CENTERLINE		
CONSTRUCTION LIMIT		
CONTOUR	100	100
CURB		
CURB STOP		
EASEMENT		
FENCE		
GAS LINE	GAS GAS	GAS GAS
GRAVEL		
HYDRANT		
LIGHT		
PAVEMENT		
OVERHEAD POWER	OE OE	OE OE
PROPERTY LINE		
RIGHT OF WAY	ROW	ROW
SANITARY SEWER	S S	S S
SETBACK		
SEWER MANHOLE	S	S
SIDEWALK		
SIGNAGE		
STORM MANHOLE	D	D
STORM SEWER	SLS SLS	SLS SLS
TREE LINE		
UTILITY POLE		
VALVE		
WATER LINE		

NEW PAVEMENT

PRESERVE AND PROTECT ALL EXISTING TREES DURING CONSTRUCTION IF AN EXISITNG TREE IS DAMAGAED DURING CONSTRUCTION, IT MUST BE REPLACED WITH A NEW TREE USING THE ISA/(INTERNATIONAL SOCIETY OF ARBOICULTURE) FORMULA.

EXISTING DECIDUOUS TREE TO BE PROTECTED WITH SNOW FENCE MIN OF 5' FROM BASE DURING CONSTRUCTION

EXISTING CONIFEROUS TREE TO BE PROTECTED WITH SNOW FENCE MIN OF 5' FROM BASE DURING CONSTRUCTION

B P–1 TYPICAL SIDEWALK DETAIL (STATION 0+12 TO STATION 0+82)
SCALE: 1"=2'

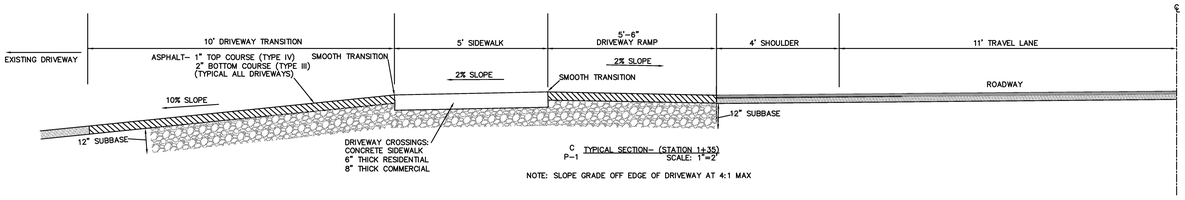

C P–1 TYPICAL SECTION– (STATION 1+35)
SCALE: 1"=2'

NOTE: SLOPE GRADE OFF EDGE OF DRIVEWAY AT 4:1 MAX

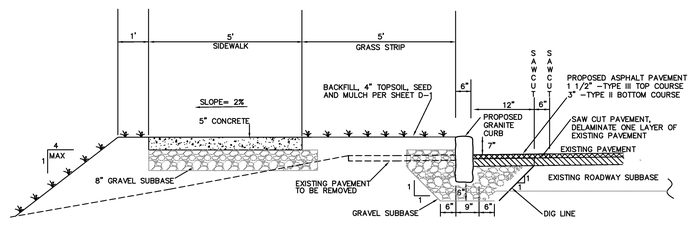

D P–1 TYPICAL SIDEWALK DETAIL (STATION 2+00 SHOWN)
SCALE: 1"=2'

RECORD DRAWINGS

DISCLAIMER: THESE RECORD DRAWINGS WERE PREPARED FROM DATA PROVIDED BY THE CONTRACTOR AND/OR OWNERS REPRESENTATIVE AND FROM SITE INSPECTIONS CONDUCTED BY ESPC FOLLOWING CONSTRUCTION. THE ENGINEER ASSUMES NO RESPONSIBILITY REGARDING THE ACCURACY OF THE INFORMATION PROVIDED ON THE PLANS OR THE LOCATIONS OF NEW CONSTRUCTION FEATURES DEPICTED ON THE PLANS.

REVISIONS	BY
1-INCLUDE COMMENTS FROM STATE AGENCIES	02-23-07 LMM
2-REMOVE THE PEDESTRIAN SIGNS	05-07-07 LMM
3-RELOCATED SIDEWALK AROUND UTILITY POLES	07-18-07 LMM

ESPC
CIVIL AND ENVIRONMENTAL ENGINEERING
P.O. BOX 212, WILLISTON, VT, 05495
WWW.ESPC-CONSULTING.COM
TEL: 802-383-0486

HINESBURG STP EH05(22)
VILLAGE STREETSCAPE IMPROVEMENTS
ROUTE 116
HINESBURG, VERMONT

DRAWN	DM
CHECKED	ES
DATE	01/22/08
SCALE	1"=20'
JOB NO.	20051114
SHEET	P-1

G:\drafting\ESPC_DRAFTING\ENGINEERING\200_1100\20051114\HINESBURG_SW\dwg\20051114_plan Rev6.dwg 1/8/2008 12:03:48 PM EST