HINESBURG STP EH 05(22)

VILLAGE STREETSCAPE IMPROVEMENTS
ROUTE 116, HINESBURG, VERMONT
DECEMBER, 2006

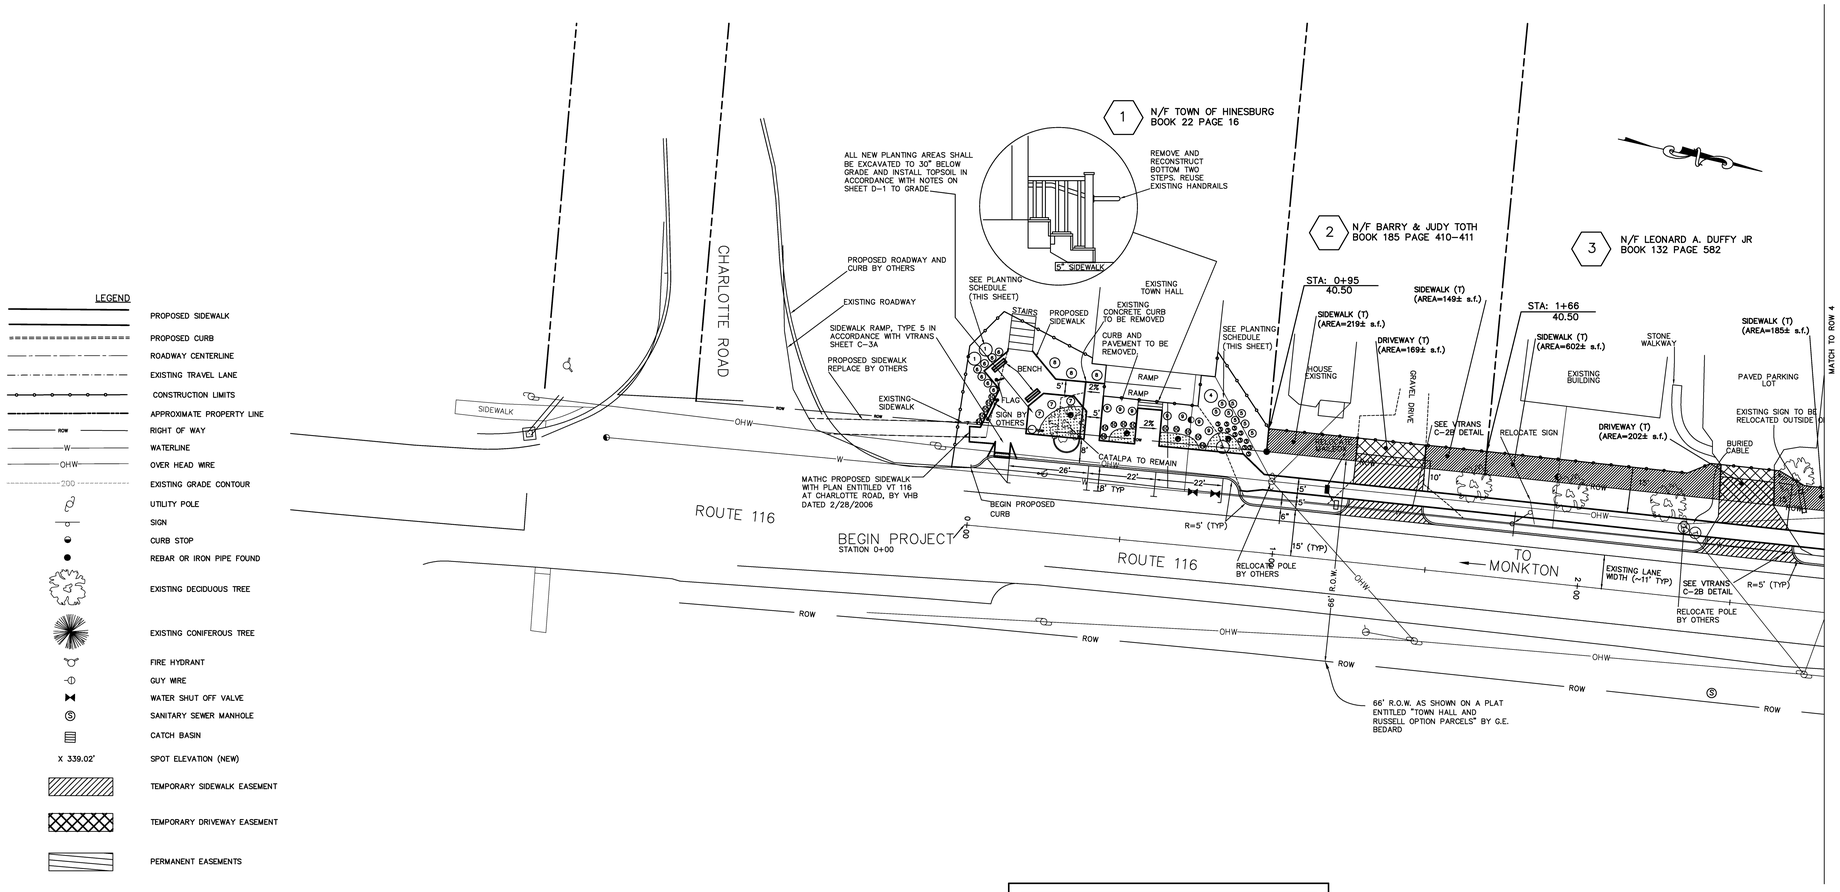

LEGEND

- PROPOSED SIDEWALK
- PROPOSED CURB
- ROADWAY CENTERLINE
- EXISTING TRAVEL LANE
- CONSTRUCTION LIMITS
- APPROXIMATE PROPERTY LINE
- ROW — RIGHT OF WAY
- W — WATERLINE
- OHW — OVER HEAD WIRE
- 200 — EXISTING GRADE CONTOUR
- UTILITY POLE
- SIGN
- CURB STOP
- REBAR OR IRON PIPE FOUND
- EXISTING DECIDUOUS TREE
- EXISTING CONIFEROUS TREE
- FIRE HYDRANT
- GUY WIRE
- WATER SHUT OFF VALVE
- SANITARY SEWER MANHOLE
- CATCH BASIN
- X 339.02' — SPOT ELEVATION (NEW)
- TEMPORARY SIDEWALK EASEMENT
- TEMPORARY DRIVEWAY EASEMENT
- PERMANENT EASEMENTS

GRAPHIC SCALE

20 0 10 20 40 80

(IN FEET)

1 inch = 20 ft.

RECORD DRAWINGS

DISCLAIMER: THESE RECORD DRAWINGS WERE PREPARED FROM DATA PROVIDED BY THE CONTRACTOR AND/OR OWNERS REPRESENTATIVE AND FROM SITE INSPECTIONS CONDUCTED BY ESPC FOLLOWING CONSTRUCTION. THE ENGINEER ASSUMES NO RESPONSIBILITY REGARDING THE ACCURACY OF THE INFORMATION PROVIDED ON THE PLANS OR THE LOCATIONS OF NEW CONSTRUCTION FEATURES DEPICTED ON THE PLANS.

RIGHT-OF-WAY PLANS

REVISIONS	BY
ADDED PERMANENT EASEMENTS TO PARCELS 5 & 6, REMOVED TEMPORARY EASEMENT FROM PARCEL 4 - 03-21-07	LMM

ESPC
CIVIL AND ENVIRONMENTAL ENGINEERING
P.O. BOX 212, MILTON, VT 05495
WWW.ESPC-CONSULTING.COM
TEL: 802-383-0486

HINESBURG STP EH05(22)
VILLAGE STREETSCAPE IMPROVEMENTS

ROUTE 116
HINESBURG, VERMONT

DRAWN	LMM
CHECKED	ES
DATE	12/21/06
SCALE	1"=20'
JOB NO.	20051114
SHEET	ROW-3