CURVE CN2
Δ = 91°06'59.6" LT.
R. = 468.400m
T. = 477.618m
L. = 744.889m
E. = 200.568m
BANK = 0.069
Ls = 61.177m
Os = 3°44'29.9"
Ts = 575.534m
Lt = 40.793m
St = 20.400m
PI STA. CN 2+187.929
N = 45346.7621
E = 442872.3761
TS N = 44808.0314
E = 442871.3593
SC N = 44848.7459
E = 442873.8348
CS N = 45335.9968
E = 442394.8794
ST N = 45335.5370
E = 442374.4841

CURVE RI
Δ = 84°46'06.2" RT.
R. = 70.000m
T. = 63.883m
L. = 103.564m
E. = 24.769m
BANK = 0.060
PI STA. RI+528.649
N = 45318.1042
E = 442458.0418
PC N = 45312.5036
E = 442394.4044
PT N = 45255.2425
E = 442469.4216

Δ = 236°03'34.7" RT.
R. = 90.000m
T. = N/A
L. = 370.802m
E. = N/A
BANK = 0.060
PI STA. GI+396.514
N = 45179.3415
E = 442268.2761
PC N = 45305.8601
E = 442346.1949
PCC N = 45159.4245
E = 442284.5381
PT N = 45200.7744
E = 442254.0714

CURVE HI
Δ = 93°31'06.3" RT.
R. = 200.000m
T. = 212.675m
L. = 326.441m
E. = 91.943m
BANK = 0.060
PI STA. H I+212.675
N = 45330.8404
E = 442166.8007
PC N = 45342.5925
E = 442379.1505
PT N = 45543.5112
E = 442168.1025

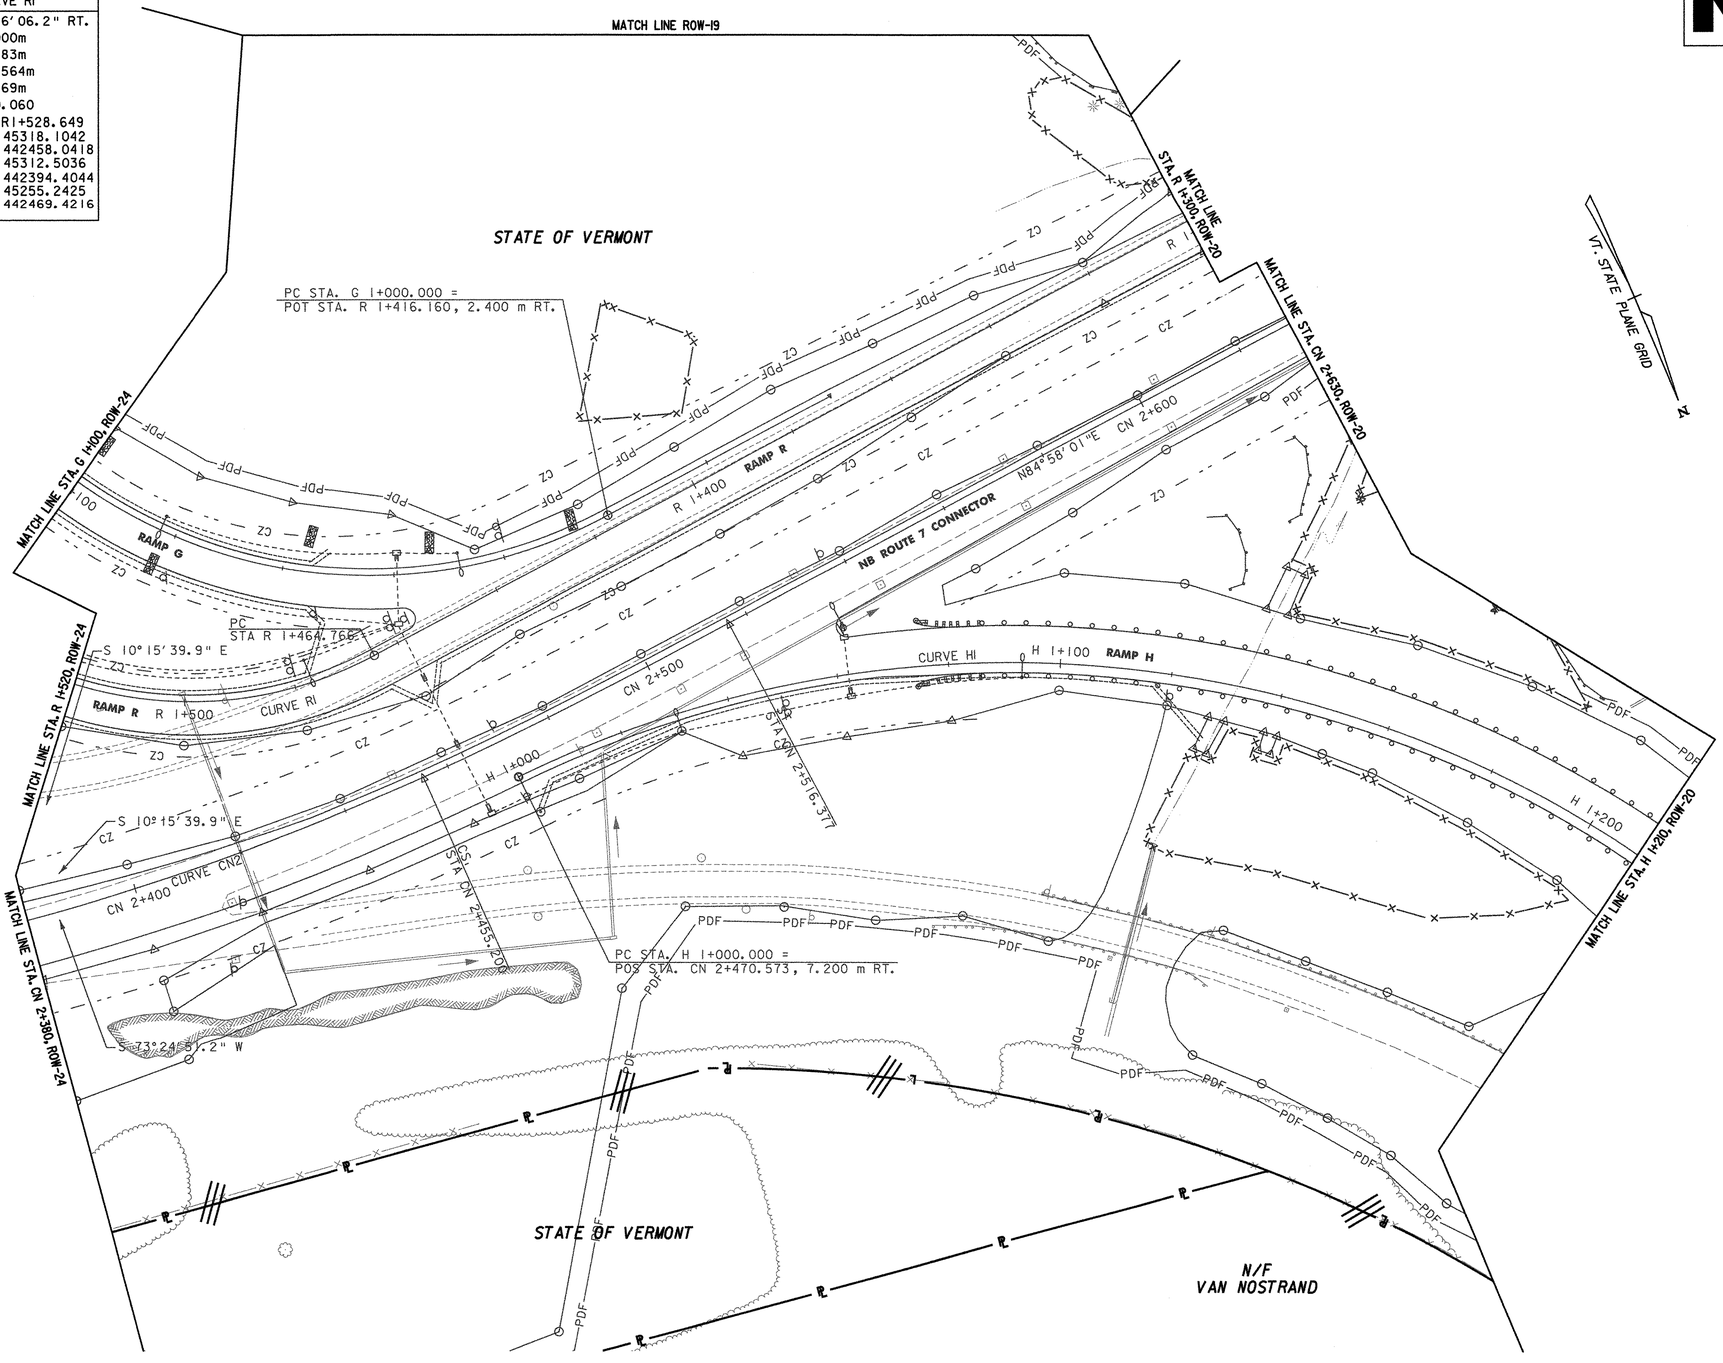

DATUM

VERTICAL NAVD 88

HORIZONTAL NAD 83 (1992)

LINES SHOWN ON THIS PLAN AS EXISTING PROPERTY LINES P/L ARE BELIEVED TO BE ACCURATE BUT SHOULD NOT BE RELIED UPON FOR PURPOSES UNRELATED TO THE STATE OF VERMONT'S ACQUISITION OF LAND AND RIGHTS FOR THIS PROJECT.

THIS SHEET TO BE USED FOR RIGHT-OF-WAY INFORMATION ONLY

0 10 20 30
SCALE 1:500
@ FULL SIZE

R.O.W. PLAN

ROW-25

PROJECT NAME: BENNINGTON

PROJECT NUMBER: AC NH 019-1(53)

DESIGN FILE NAME: c:\dh\bennington\row

PROJECT LEADER: JDP

PLOT DATE: 05-21-07
DRAWN BY: MBB
CHECKED BY: GAK

SHEET: 42 OF 577