



LEGEND

- AMC.OI (9) DECIDUOUS SHRUB GROUPING WITH PLANT TYPE AND (QUANTITY)
- AR.OI (3) DECIDUOUS TREE GROUPING WITH PLANT TYPE AND (QUANTITY)
- AC.OI (4) EVERGREEN TREE GROUPING WITH PLANT TYPE AND (QUANTITY)
- EXISTING DECIDUOUS TREE
- EXISTING EVERGREEN TREE
- TOE OF SLOPE
- LIMIT OF CUT
- APPROXIMATE ULTIMATE TOE OF SLOPE
- APPROXIMATE ULTIMATE LIMIT OF CUT
- TREELINE
- R.O.W.
- NEW ENGLAND EROSION CONTROL / RESTORATION MIX FOR MOIST SITES

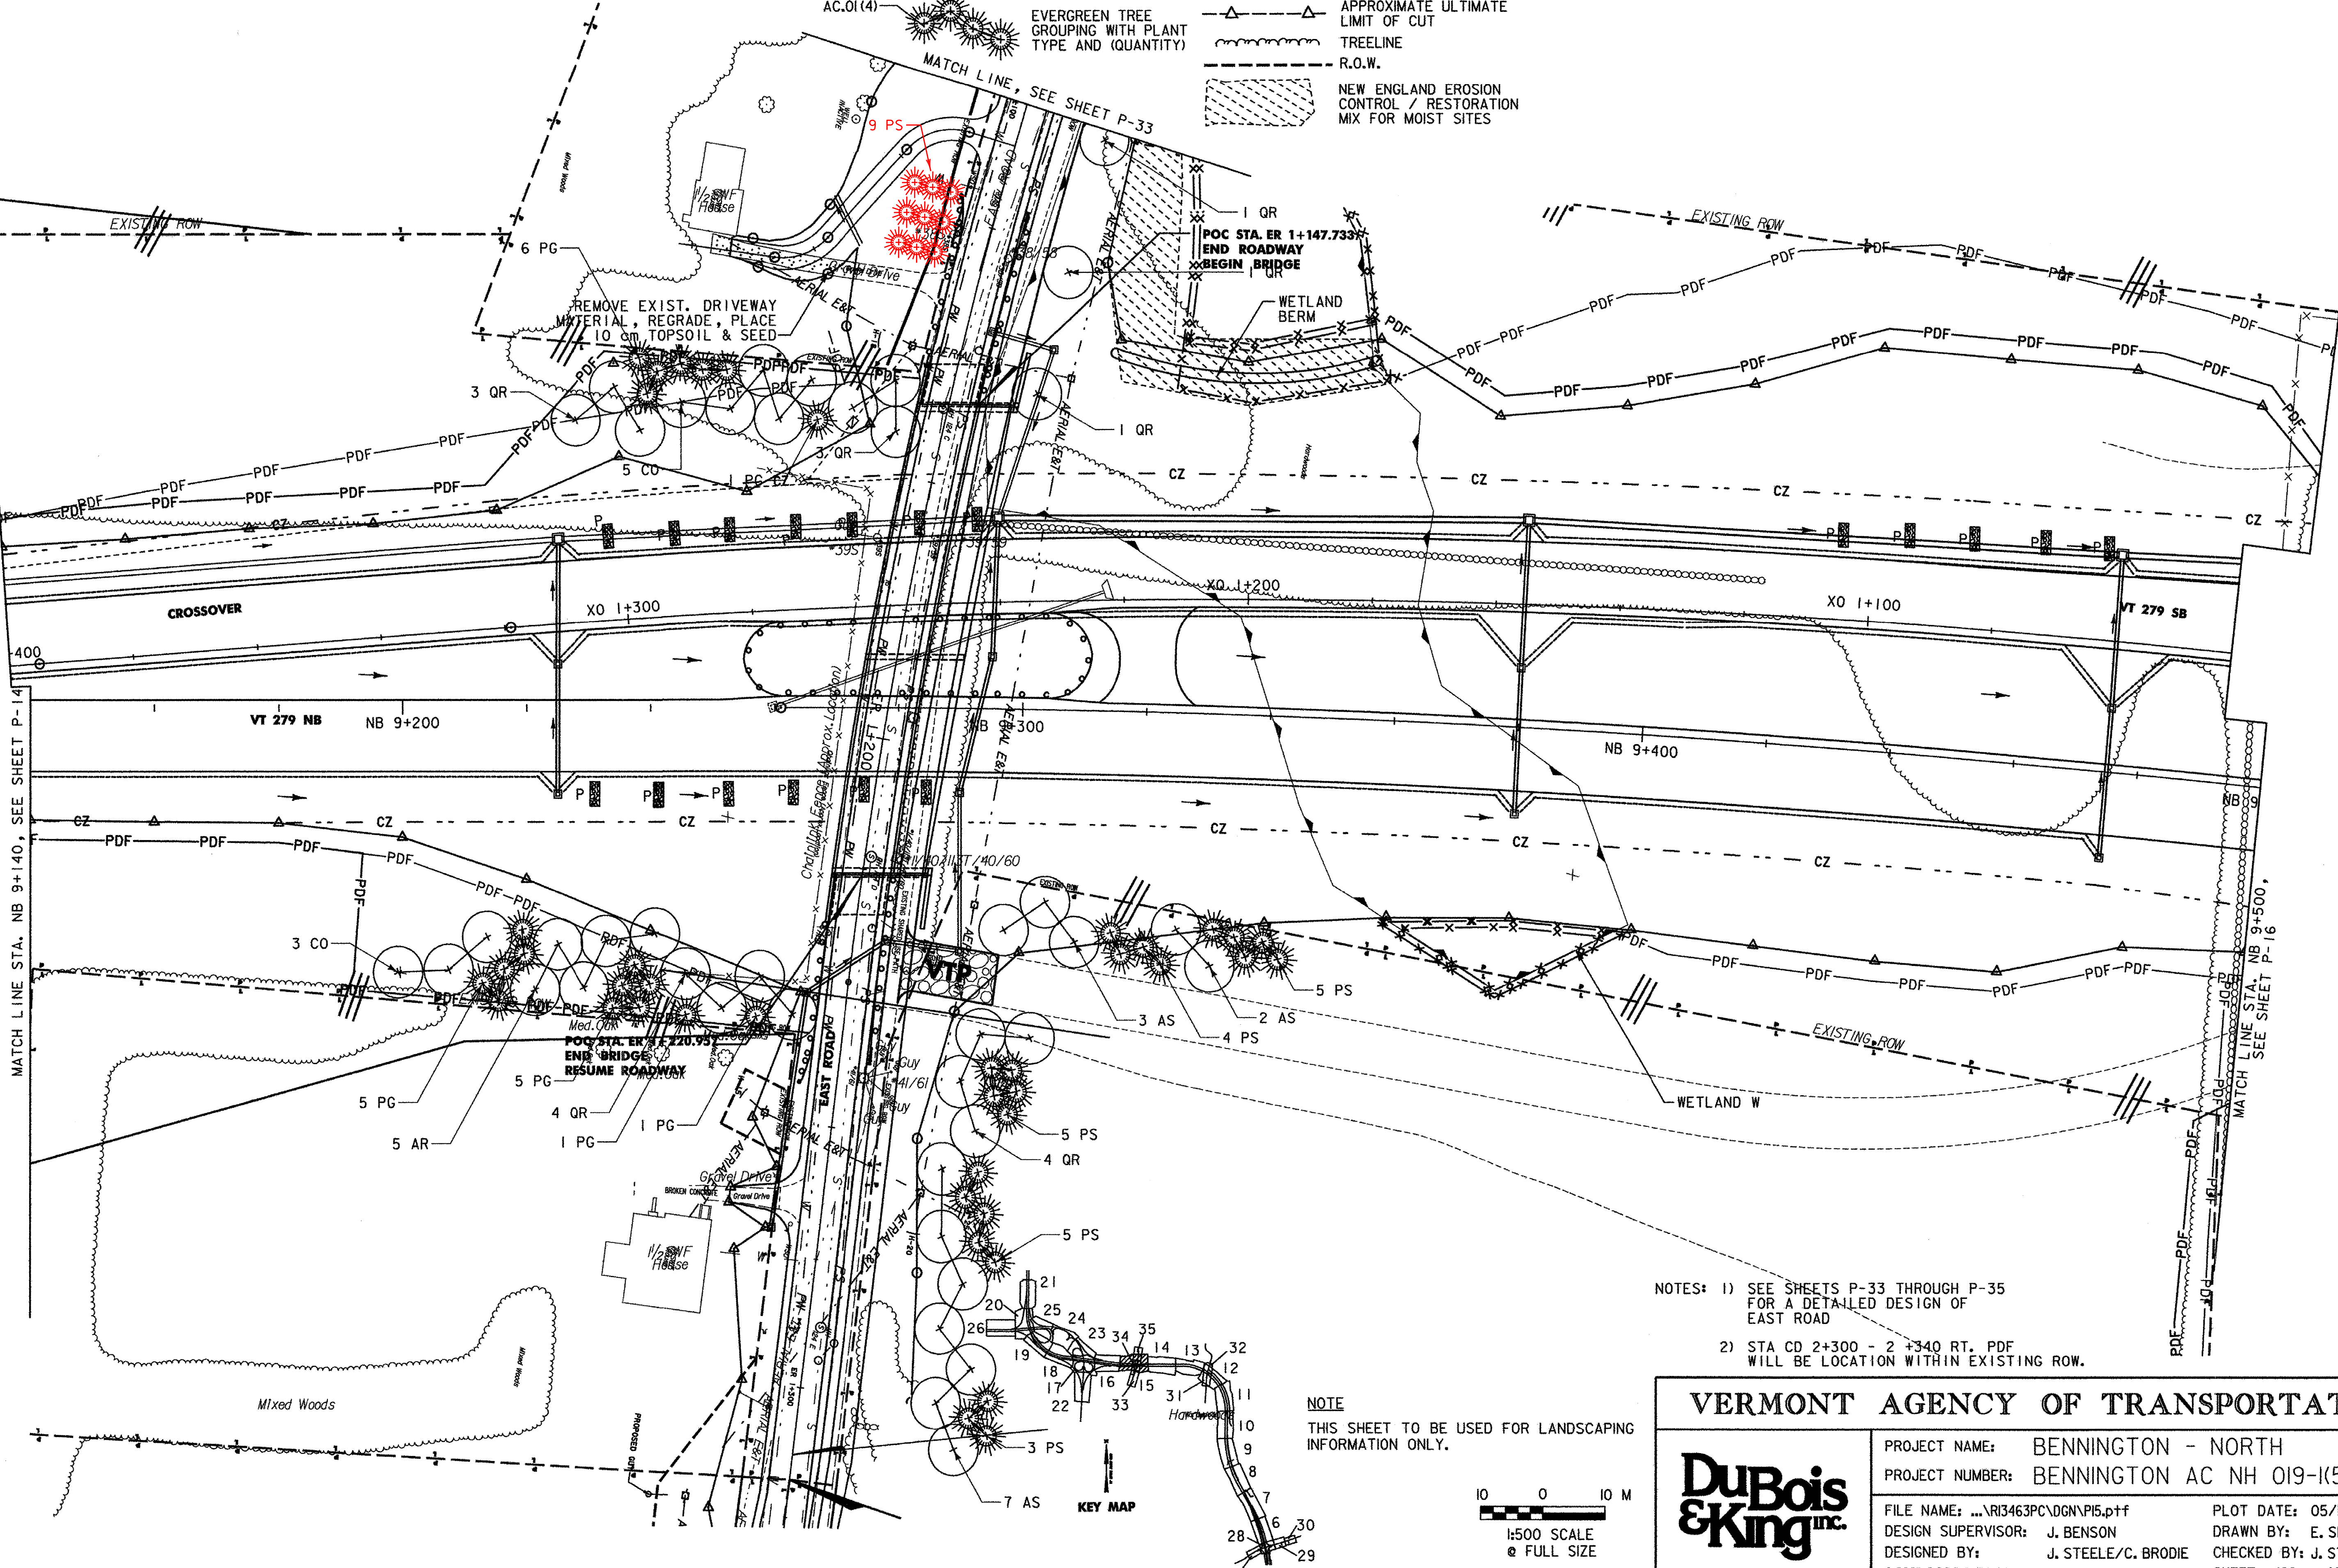

- NOTES:
- 1) SEE SHEETS P-33 THROUGH P-35 FOR A DETAILED DESIGN OF EAST ROAD
 - 2) STA CD 2+300 - 2+340 RT. PDF WILL BE LOCATION WITHIN EXISTING ROW.

NOTE
THIS SHEET TO BE USED FOR LANDSCAPING INFORMATION ONLY.

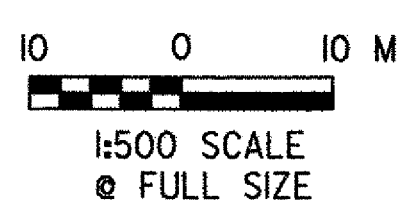

VERMONT AGENCY OF TRANSPORTATION

DuBois & King Inc.

PROJECT NAME:	BENNINGTON - NORTH	PLOT DATE:	05/18/2007
PROJECT NUMBER:	BENNINGTON AC NH 019-K(53)	DRAWN BY:	E. SMALL
FILE NAME:	...R13463PC\DGNNP15.p1f	CHECKED BY:	J. STEELE
DESIGN SUPERVISOR:	J. BENSON	SHEET	189 OF 577
DESIGNED BY:	J. STEELE/C. BRODIE		
LANDSCAPE PLAN L-5			