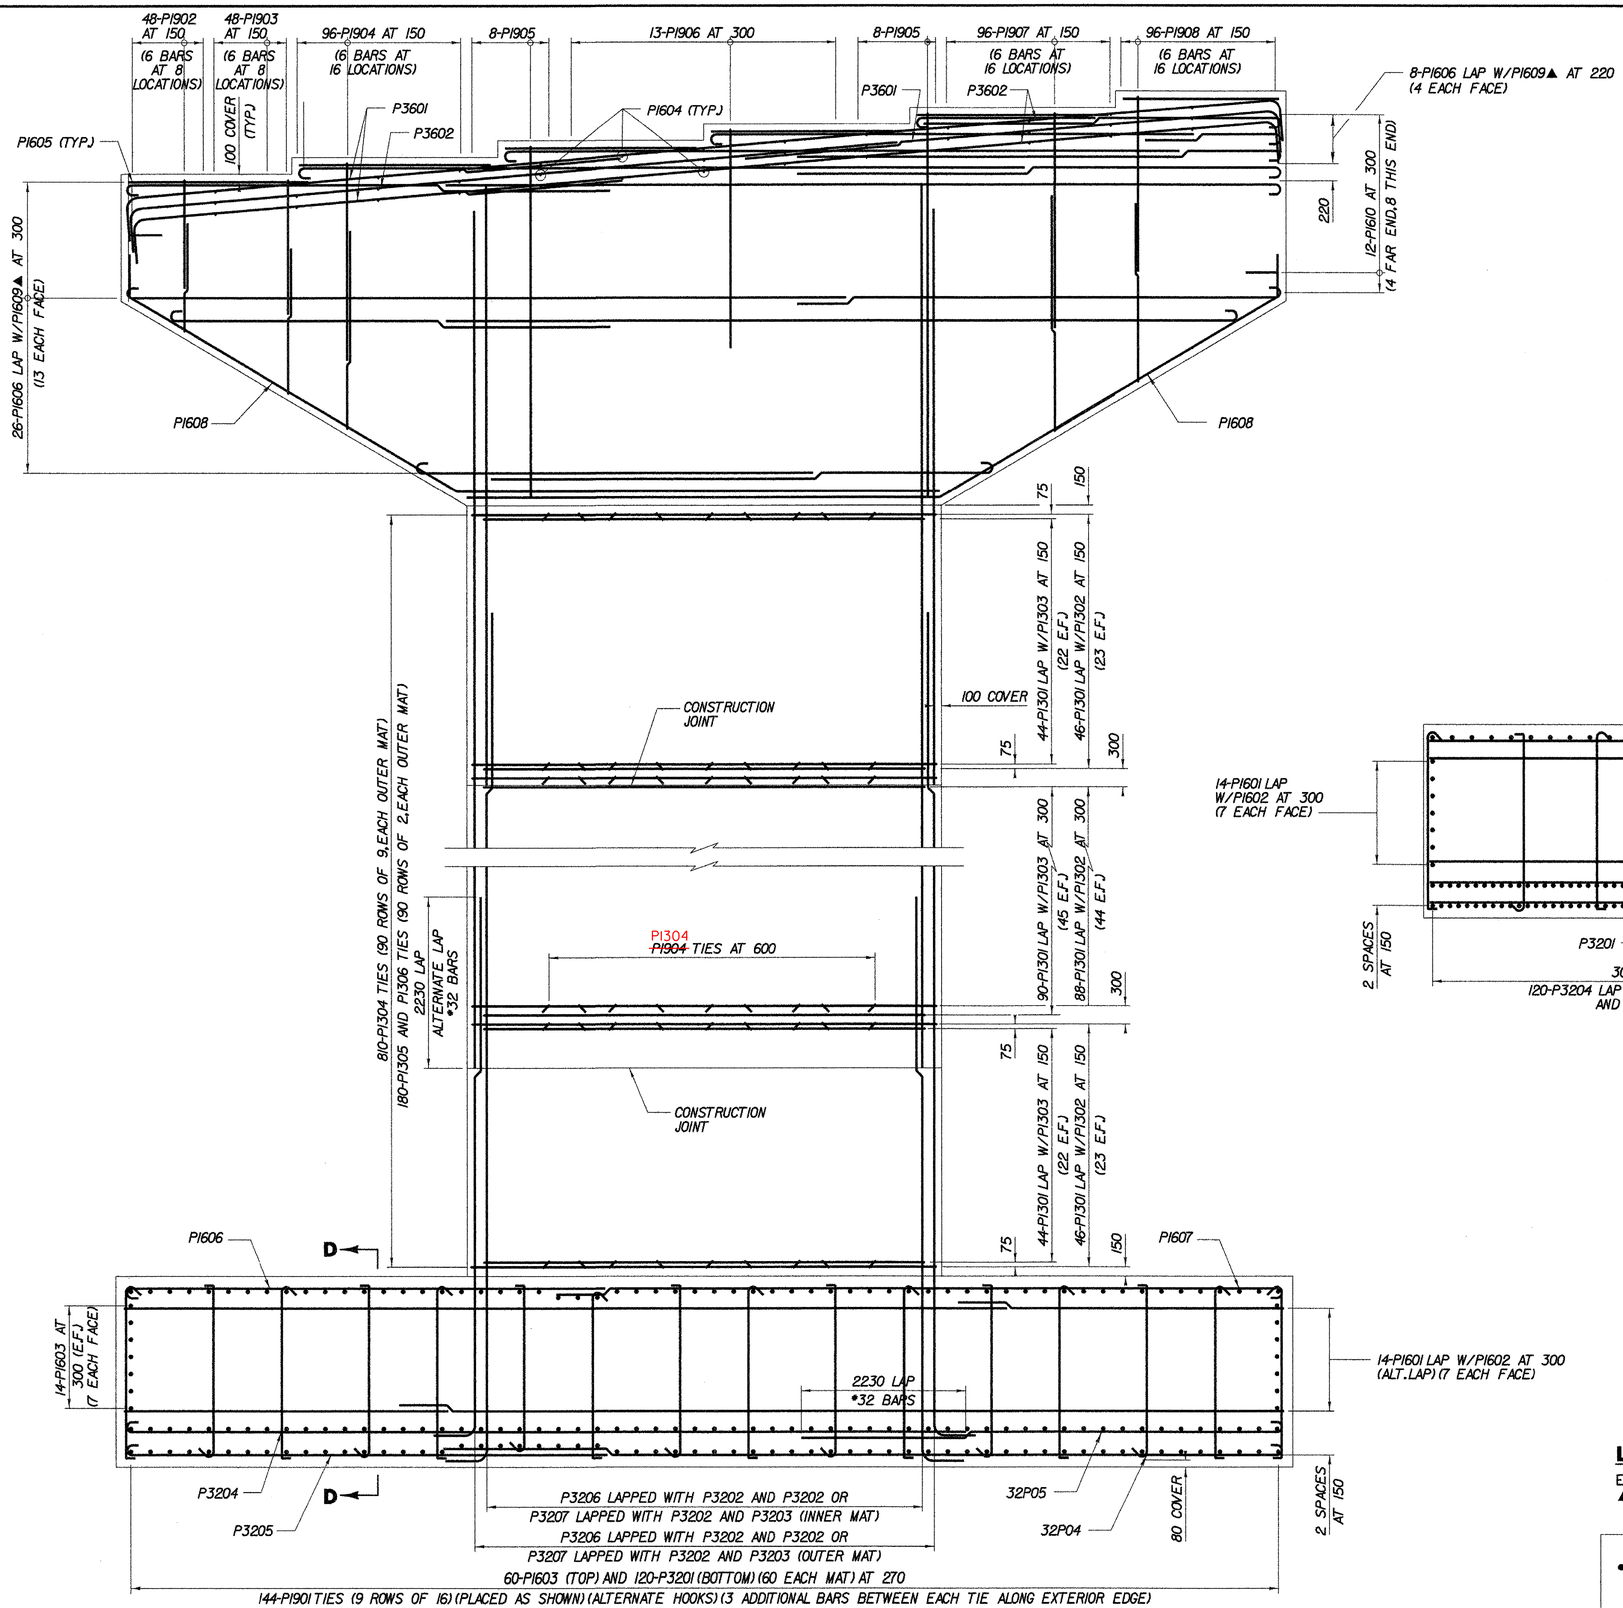

REINFORCEMENT ELEVATION

SCALE 1:40

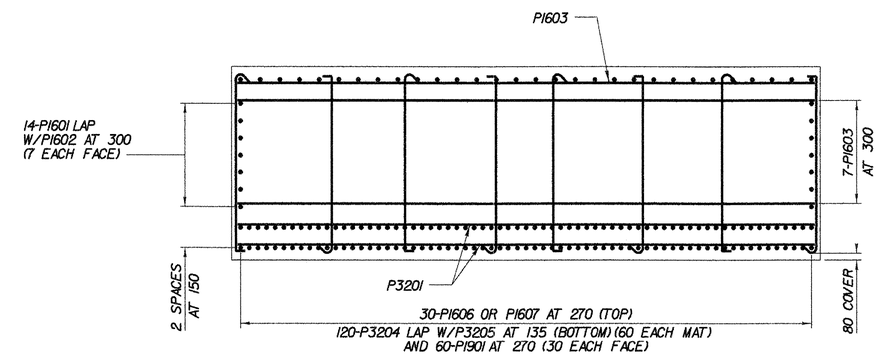

SECTION D-D

SCALE 1:40

0 0.8 1.6 2.4 3.2 4.0m

SCALE 1:40

LEGEND:

E.F. EACH FACE
▲ CUT TO FIT IN FIELD

TVGA CONSULTANTS

STATE OF VERMONT
AGENCY OF TRANSPORTATION

Town Of BENNINGTON		Bridge No. BI2	
Highway No. VT RTE 279		Log Sta. / Surv. Sta.	
VT ROUTE 279 OVER FURNACE BROOK			
PIER REINFORCEMENT (2 OF 2)			
Designed By M.D. BOWER		Drawn By D.J. HENDERSON	
Checked By B.J. CARLSON	Date 04/07	Bridge Design Supervisor K.M. WOJTKOWSKI	Date 04/07
PROJECT BENNINGTON		PROJECT NO. AC NH F019-1(53)	
TVGA CAD Drawing No. FBPierReb2.dgn		Date 04/16/2007	
Bridge Sheet No. BR539		Sheet 231 of 577	