Metric

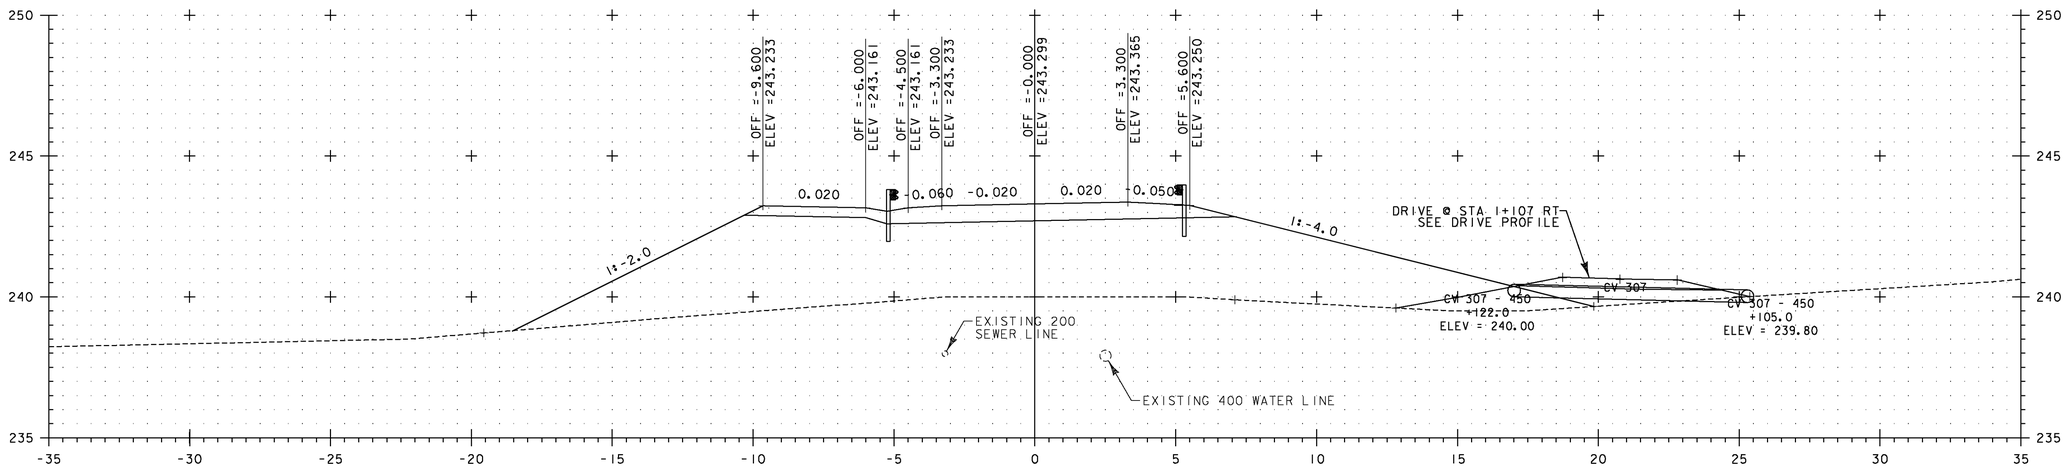

ER 1+120

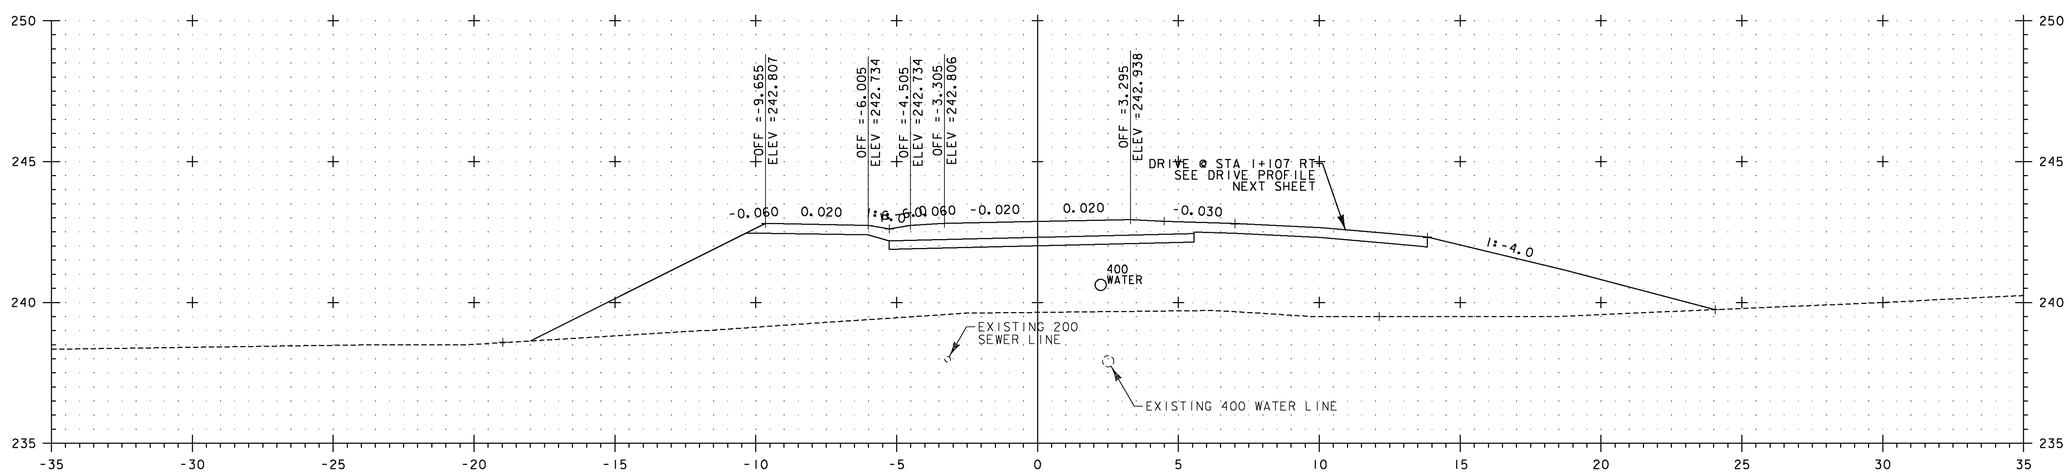

ER 1+107

5 METERS
2.5
H 1:100 SCALE
V 1:100 SCALE
@ FULL SIZE
2.5
5 METERS

VERMONT AGENCY OF TRANSPORTATION

Stantec

PROJECT NAME: BENNINGTON
PROJECT NUMBER: AC NH 019-1(53)

FILE NAME: ...\plot_files\zd307c3xs_east.ptf
PLOT DATE: 5/16/2011
DESIGN SUPERVISOR: GREG EDWARDS
DRAWN BY: STANTEC
DESIGNED BY: MARC FOISY
CHECKED BY: GARY SANTY
EAST ROAD CROSS SECTIONS
SHEET 354 OF 577

v:\193\active\19530002\transportation\drawing\contract_3\plot_files\zd307c3xs_east.ptf