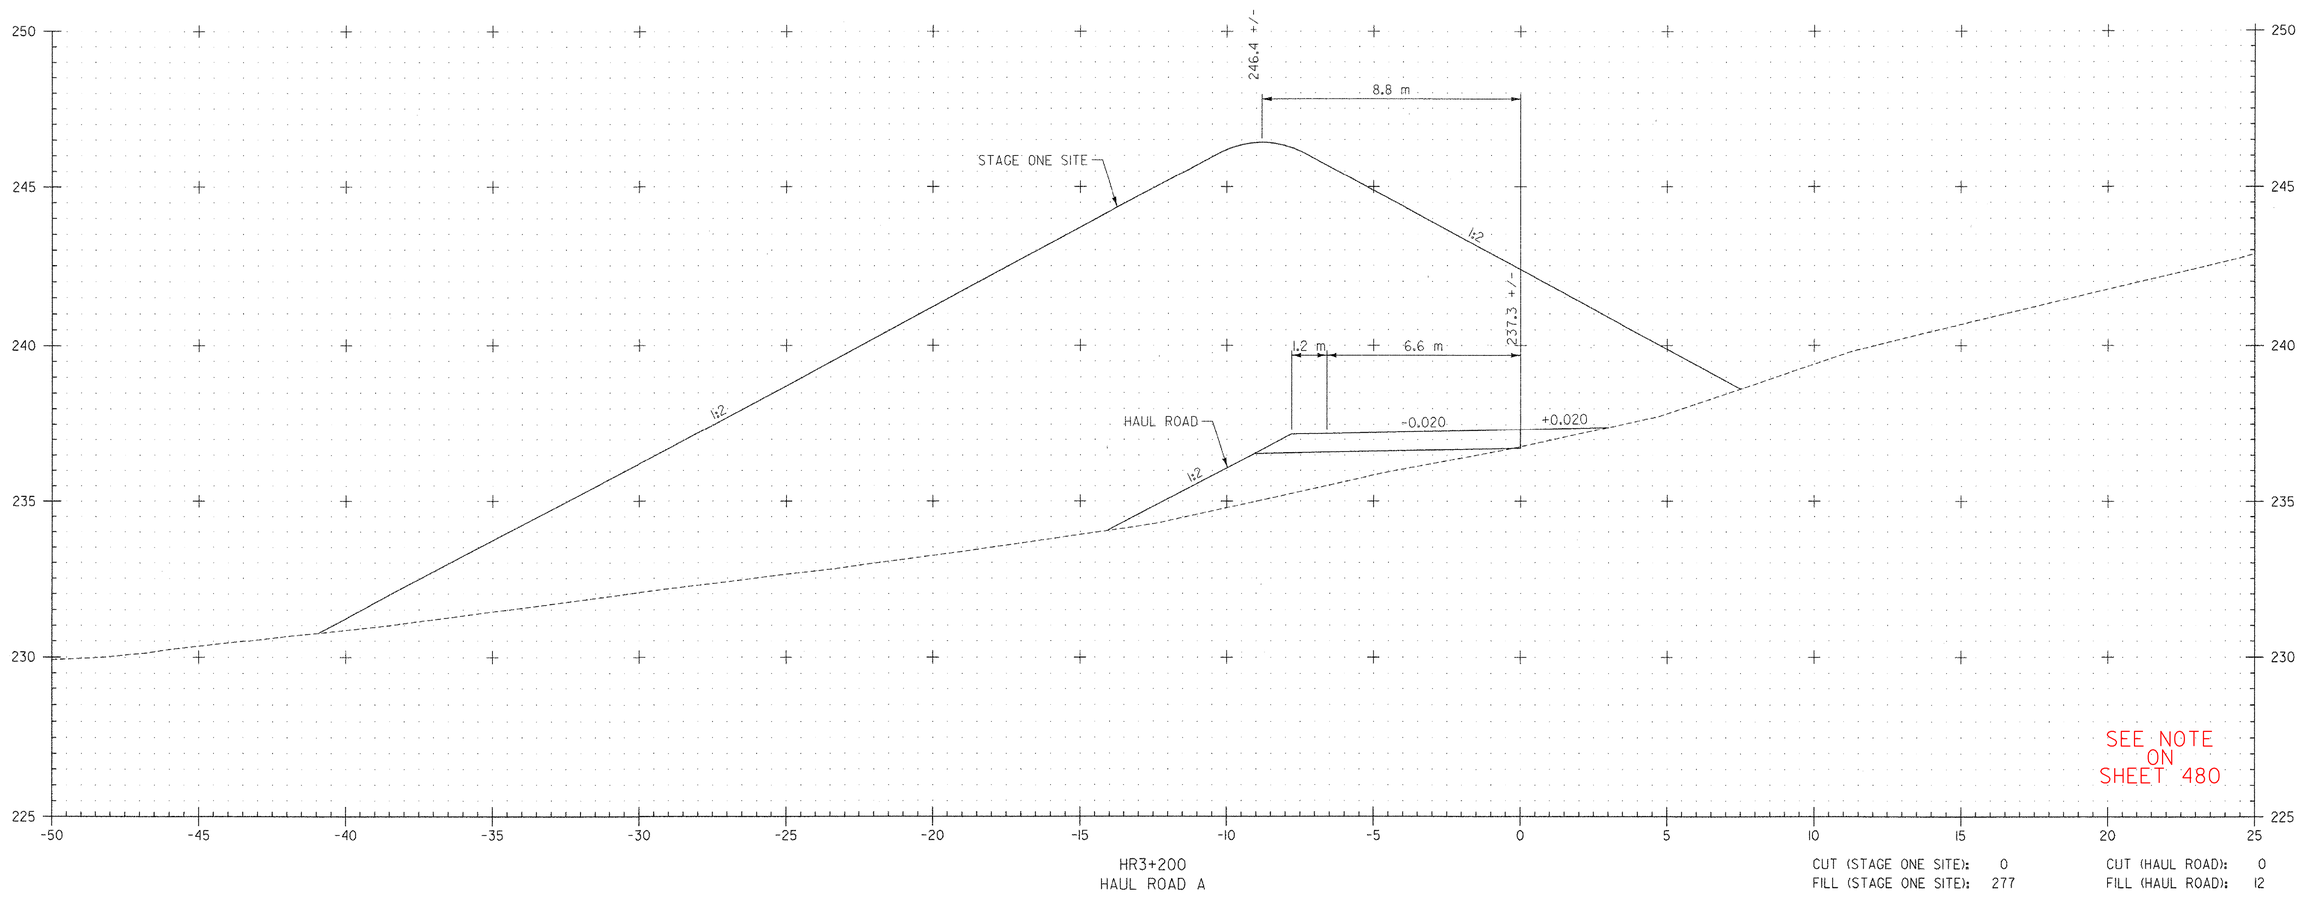

HR3+200
HAUL ROAD A

CUT (STAGE ONE SITE): 0
FILL (STAGE ONE SITE): 277
CUT (HAUL ROAD): 0
FILL (HAUL ROAD): 12

2 0 2 m
1: 100
@ FULL SIZE

DATUM
VERTICAL NAVD 88
HORIZONTAL NAD 83 (1992)

FILE NAME =U:\9819\mstn\03\clough\Stage One Sites\zd048xsc_f.dgn
DATE/TIME =5/18/2007
USER =1459

VERMONT AGENCY OF TRANSPORTATION

CLOUGH HARBOUR & ASSOCIATES LLP
© 2007
III Winners Circle, PO Box 5269, Albany, NY 12205
www.cloughharbour.com

PROJECT NAME: BENNINGTON
PROJECT NUMBER: AC NH 019-1(53)

FILE NAME: ZD048XSC.DGN
PROJECT LEADER: D.E.G.
DESIGNED BY: J.S.P.
PLOT DATE: 5/18/2007
DRAWN BY: J.S.P.
CHECKED BY: D.E.G.

CROSS SECTIONS XSC-67

SHEET 546 OF 577