METRIC

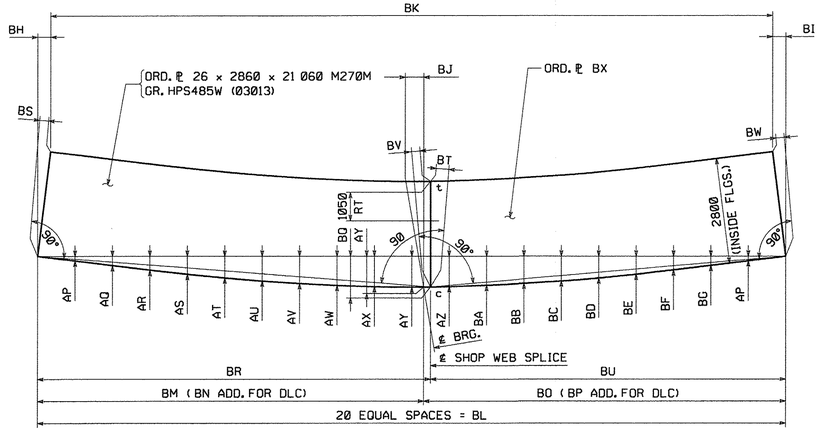

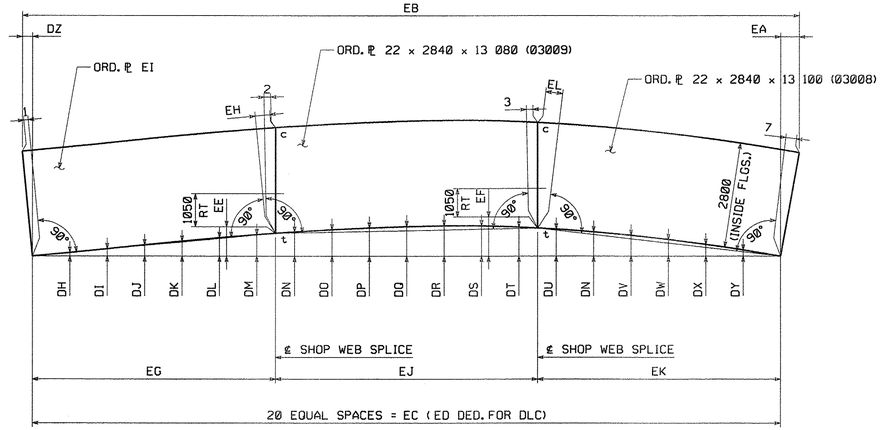

MARK	AP	AQ	AR	
G1C	-15	-31	-45	-59	-71	-81	-90	-96	-100	-102	-100	-95	-89	-82	-72	-59	-45	-31	21	21	78	39 915	39 957	19 979	7	19 978	7	-101
G2C	-16	-33	-48	-62	-74	-84	-93	-100	-104	-106	-104	-99	-93	-85	-74	-62	-48	-33	22	23	77	40 111	40 156	20 079	8	20 077	8	-105
G3C	-17	-34	-50	-64	-77	-88	-97	-103	-107	-109	-107	-103	-96	-87	-77	-64	-49	-34	23	23	77	40 308	40 354	20 178	8	20 176	8	-108
G4C	-17	-35	-52	-67	-81	-93	-102	-109	-113	-114	-112	-108	-101	-92	-81	-67	-52	-35	23	24	76	40 504	40 551	20 276	8	20 275	8	-114
G5C	-18	-36	-52	-68	-82	-94	-103	-110	-115	-118	-116	-111	-104	-94	-82	-68	-52	-35	24	25	75	40 700	40 749	20 375	8	20 374	9	-117
G6C	-19	-37	-55	-71	-87	-99	-108	-116	-121	-123	-121	-116	-109	-99	-87	-72	-55	-37	26	26	75	40 895	40 947	20 474	9	20 473	9	-122

MARK	DH	DI	DJ	DK	DL	DM	DN	DO	DP	DQ	DR	DS	DT	DU	DV	DW	DX	DY	DZ	EA	EB	EC	ED	EE	EF	EG	EH
G5D	8	17	25	34	42	49	55	60	64	67	69	69	66	61	47	38	27	14	12	21	38 905	38 872	19	52	64	12 837	11
G6D	9	18	27	36	44	52	59	64	69	71	73	72	70	65	50	39	28	15	13	22	39 094	39 059	20	57	68	13 025	12

MARK	BR	BS	BT	BU	BV	BW	BX
G1C	21 003	8	13	18 954	15	6	26 x 2860 x 19 020 M270M GR. HPS485W (03018)
G2C	21 005	8	14	19 151	15	8	26 x 2860 x 19 400 M270M GR. HPS485W (03017)
G3C	21 005	9	14	19 349	16	7	26 x 2860 x 19 400 M270M GR. HPS485W (03017)
G4C	21 004	8	15	19 547	16	8	26 x 2860 x 19 600 M270M GR. HPS485W (03016)
G5C	21 005	8	16	19 744	16	8	26 x 2860 x 19 800 M270M GR. HPS485W (03015)
G6C	21 005	10	16	19 942	18	9	26 x 2860 x 20 000 M270M GR. HPS485W (03014)

MARK	EI	EJ	EK	EL
G5D	22 x 2840 x 12 960 (03011)	13 019	13 016	13
G6D	22 x 2840 x 13 100 (03008)	13 018	13 015	14

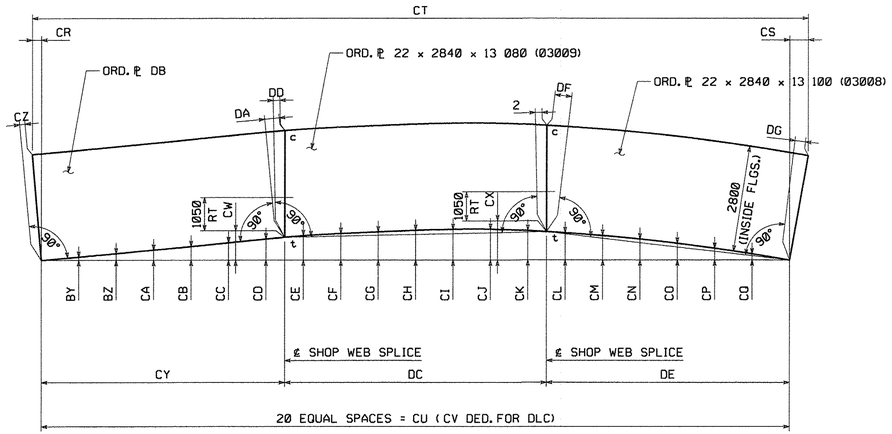

MARK	BY	BZ	CA	
G1D	6	11	17	23	30	36	41	45	48	50	52	52	50	46	42	36	29	20	11	8	16	38 146	38 122	15	38	49	12 085	1	9
G2D	7	13	20	26	33	39	45	50	53	55	56	55	53	49	44	38	31	22	12	10	18	38 337	38 309	17	42	52	12 273	0	10
G3D	7	14	21	28	35	42	48	53	57	59	59	59	57	53	48	40	32	23	13	10	19	38 525	38 496	18	45	56	12 461	0	10
G4D	7	15	23	31	39	46	52	57	60	63	64	63	61	57	51	44	35	25	14	11	20	38 715	38 684	19	49	60	12 649	0	11

MARK	DB	DC	DD	DE	DF	DG
G1D	22 x 2860 x 12 160 (03004)	13 020	3	13 017	11	5
G2D	22 x 2840 x 12 540 (03012)	13 019	3	13 016	11	7
G3D	22 x 2840 x 12 540 (03012)	13 019	2	13 016	12	7
G4D	22 x 2860 x 12 720 (03002)	13 019	2	13 016	13	7

TVGA CONSULTANTS

☒ NO EXCEPTIONS TAKEN ☐ REJECTED
☐ FURNISH AS CORRECTED
☐ REVISE AND RESUBMIT

ENGINEER has reviewed Shop Drawings and Samples and other data which Contractor is required to submit, only for conformance with the information given in the Contract Documents and compatibility with the design concept of the completed Project as a functioning whole as indicated in the Contract Documents. Such reviews do not extend to means, methods, techniques, sequences or procedures of construction or to safety precautions and programs incident thereto. Contractor is responsible for dimensions to be confirmed and correlated at the job site; for information that pertains solely to the fabrication processes or to techniques of construction; and for coordination of the work of all trades.

BY: _____
DATE: 12/6/07

NOTES:

FOR WELDING AND OTHER NOTES, SEE DWG. WC1.

NO.	REVISION	BY	CHK'D	DATE
△				
△				
△				

HOLES
BOLTS
COATING
CODE(S) 30
SCALE N.T.S.

HIGH STEEL STRUCTURES INC.
An Affiliate of High Industries Inc.
An ISO 9001:2000 Certified Company
Lancaster Facility, 915 Old Philadelphia Pike, Lancaster, PA 17605-0008, Phone (717) 299-5211
Williamsport Facility, 3501 W. 4th Street, Williamsport, PA 17701, Phone (570) 326-9051
www.highsteel.com

WEB CAMBER DIAGRAMS
VT ROUTE 279 OVER FURNACE BROOK
VT ROUTE 279 STA. 8+542.000 TO STA. 8+685.000
TOWN OF BENNINGTON VERMONT, BRIDGE B12
STATE OF VERMONT
AGENCY OF TRANSPORTATION

	AC NH F019-1(53)	FED. AID PROJ. NO.	
GENERAL CONTRACTOR	J.A. McDONALD, INC.	HSSI PROJ. MGR	DEB KUPRES
SHPMT 3	DRAWING MANAGER: BRITIGAN (IH)	MADE BY: KMA	CHK'D BY: SJA	DATE: 9/13/07
STATE VT	HSSI PROJECT NUMBER: S-1070147	HSSI STRUCT. ID: A	DRAWING NUMBER: WC2 OF WC3

1070147A X1 12/3/07 12/3/07Approval TO:J.A. McDonald, Inc.

PLOTTED: 11/30/2007 12:43:27 PM
BY: MKreidel
SHIPMENT 01
P&ENG: 5802812 PRO: 5802818 SHIP&ERECT: 5802819