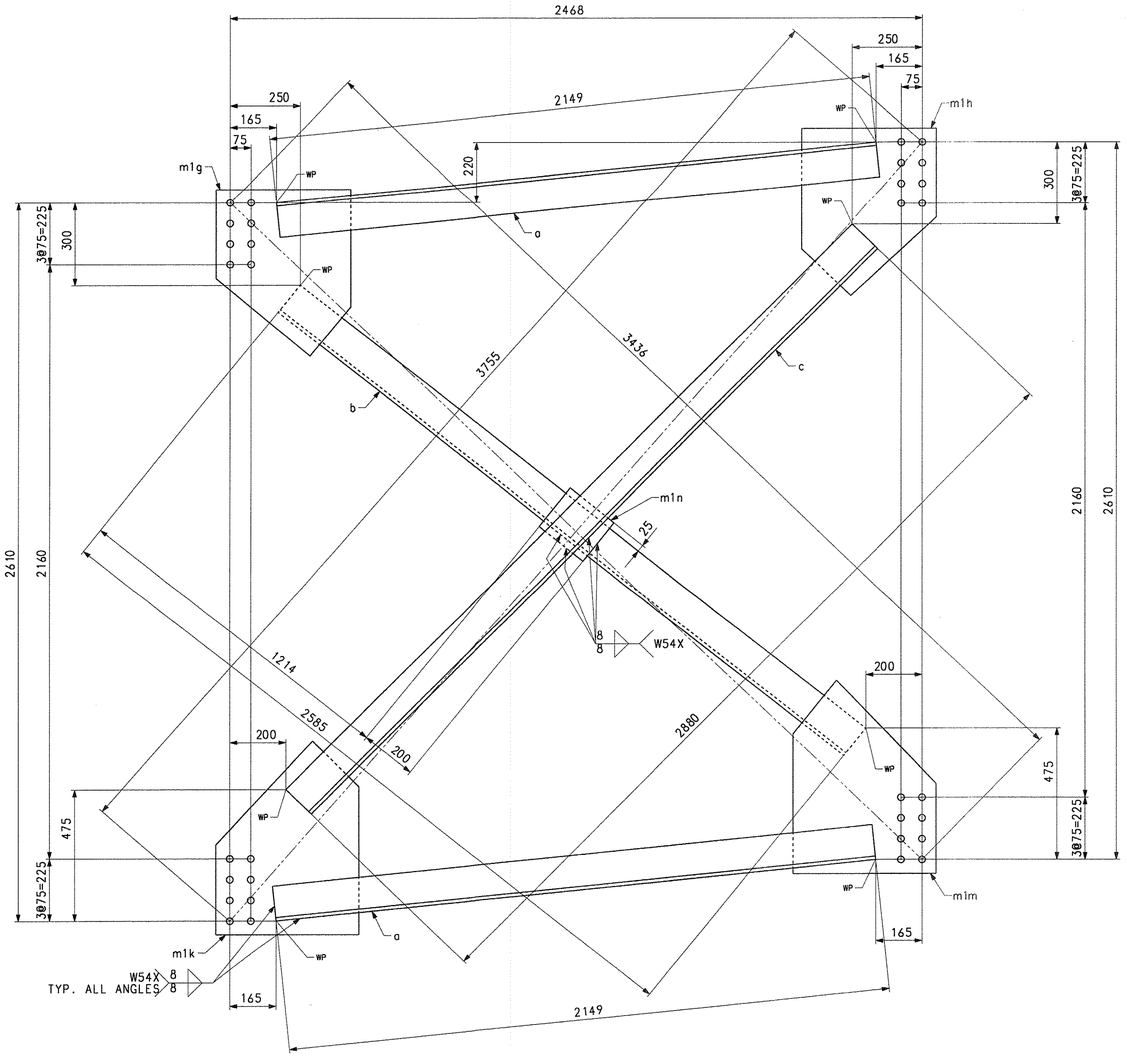

CROSSFRAME – MK. CF4 (PAINT)
CROSSFRAME – MK. CF5 (NO PAINT)

BILL OF MATERIAL

QTY	MARK	COMM.	DESCRIPTION	LENGTH	SPEC	GRADE	TEST	REMARKS	ITEM	GROSS WEIGHT EA.	DEDUCTED WEIGHT EA.	NET WEIGHT EA.
10	CF4		CROSSFRAME							334.56	0	334.56
2	a	L	127 x 127 x 12.7	2149	M270M	345W	T	(L5 x 5 x 1/2)	11002	52.13	0	52.13
1	b	L	127 x 127 x 12.7	2585	M270M	345W	T	(L5 x 5 x 1/2)	11002	62.71	0	62.71
1	c	L	127 x 127 x 12.7	2880	M270M	345W	T	(L5 x 5 x 1/2)	11002	69.87	0	69.87
1	m1g	PL	14.3 x 480	610	M270M	345W	T		11003	32.86	0	32.86
1	m1h	PL	14.3 x 480	610	M270M	345W	T		11003	32.86	0	32.86
1	m1k	PL	14.3 x 510	700	M270M	345W	T		11003	40.07	0	40.07
1	m1m	PL	14.3 x 510	700	M270M	345W	T		11003	40.07	0	40.07
1	m1n	PL	14.3 x 177	200	M270M	345W	T	FILL	11003	3.97	0	3.97
130	CF5		CROSSFRAME							334.56	0	334.56
2	a	L	127 x 127 x 12.7	2149	M270M	345W	T	(L5 x 5 x 1/2)	11002	52.13	0	52.13
1	b	L	127 x 127 x 12.7	2585	M270M	345W	T	(L5 x 5 x 1/2)	11002	62.71	0	62.71
1	c	L	127 x 127 x 12.7	2880	M270M	345W	T	(L5 x 5 x 1/2)	11002	69.87	0	69.87
1	m1g	PL	14.3 x 480	610	M270M	345W	T		11003	32.86	0	32.86
1	m1h	PL	14.3 x 480	610	M270M	345W	T		11003	32.86	0	32.86
1	m1k	PL	14.3 x 510	700	M270M	345W	T		11003	40.07	0	40.07
1	m1m	PL	14.3 x 510	700	M270M	345W	T		11003	40.07	0	40.07
1	m1n	PL	14.3 x 177	200	M270M	345W	T	FILL	11003	3.97	0	3.97

TOTAL WEIGHT THIS SHEET: 46838.11 kgs

TVGA CONSULTANTS

☒ NO EXCEPTIONS TAKEN ☐ REJECTED
☐ FURNISH AS CORRECTED
☐ REVISE AND RESUBMIT

ENGINEER has reviewed Shop Drawings and Samples and other data which Contractor is required to submit, only for conformance with the information given in the Contract Documents and compatibility with the design concept of the completed Project as a functioning whole as indicated in the Contract Documents. Such review shall not extend to means, methods, techniques, sequences or procedures of construction or to safety precautions and programs incident thereto. Contractor is responsible for dimensions to be confirmed and correlated at the job site; for information that pertains solely to the fabrication processes or to techniques of construction, and for coordination of the work of all trades.

BY: _____
DATE: 12/6/07

NOTE:
FOR GENERAL SHOP NOTES, SEE DRAWING GN1.

NO.	REVISION	BY	CHK'D	DATE

HOLES: 15/16" Ø
BOLTS: NONE
COATING: SEE DWG. GN1
CODE(S): 63
SCALE: N.T.S.

HIGH STEEL STRUCTURES INC.
An ISO 9001:2000 Certified Company
An Affiliate of High Industries Inc.
1915 Old Philadelphia Pike
Lancaster, PA 17602-0008
Phone (717) 293-5211
www.highsteel.com

CROSSFRAMES CF4 & CF5
VT ROUTE 279 OVER FURNACE BROOK
VT ROUTE 279 STA. 8+542.000 TO STA. 8+685.000
TOWN OF BENNINGTON VERMONT, BRIDGE B12
STATE OF VERMONT
AGENCY OF TRANSPORTATION

STATE CONT. OR REF. NO.	AC NH F019-1(53)	FED. AID PROJ. NO.	
GENERAL CONTRACTOR	J.A. McDONALD, INC.	HSSI PROJ. MGR	DEB KUPRES
SHPMT 3	DRAWING MANAGER: BRITIGAN (IH)	MADE BY: ERS	CHK'D. BY: CS	DATE: 11-14-07
STATE VT	HSSI PROJECT NUMBER: S-1070147	HSSI STRUCT. ID: A	DRAWING NUMBER: 33 OF 34

SHIPMENT 1 PM&ENG: 5002817 PRD: 5002818 SHIP&ERECT: 5002819
PLOTTED: 11/30/07 12:46:52 BY: MKreidel