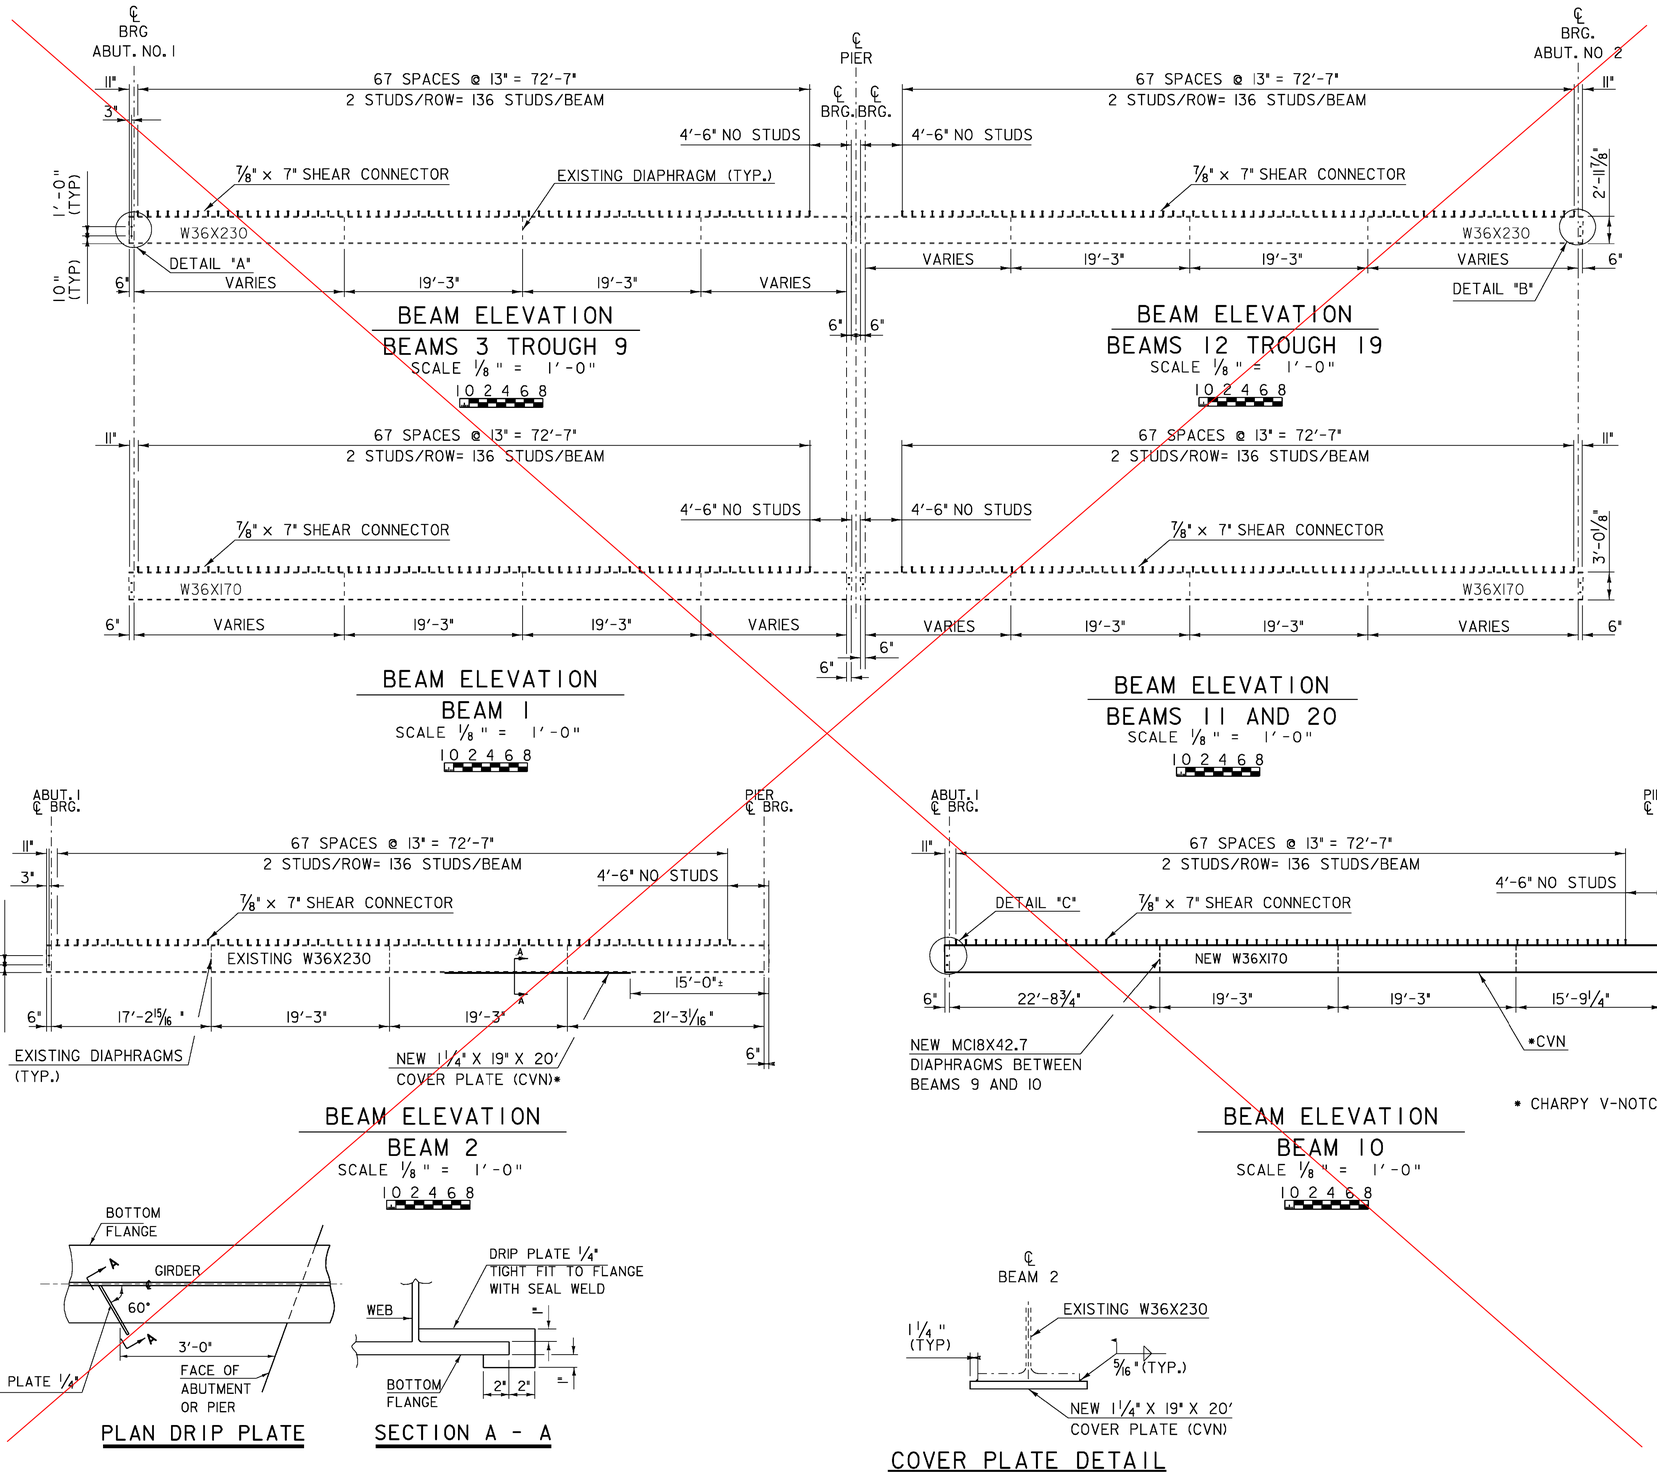


NOTE:
DRIP PLATES SHALL BE PLACED ON OUTSIDE EDGE OF BEAM NO. 10 AT ABUTMENT NO. 1.

| | |
|---|---|
| PROJECT NAME: SPRINGFIELD | |
| PROJECT NUMBER: BHF 016-2(14) | |
| FILE NAME: s06j004sup.dgn | PLOT DATE: 04-MAR-2009 |
| PROJECT LEADER: R. WHITCOMB | DRAWN BY: C. MOONEY |
| DESIGNED BY: C. CARLSON | CHECKED BY: D. PETERSON |
| STRUCTURAL STEEL ELEVATION SHEET | SHEET 27 OF 72 |