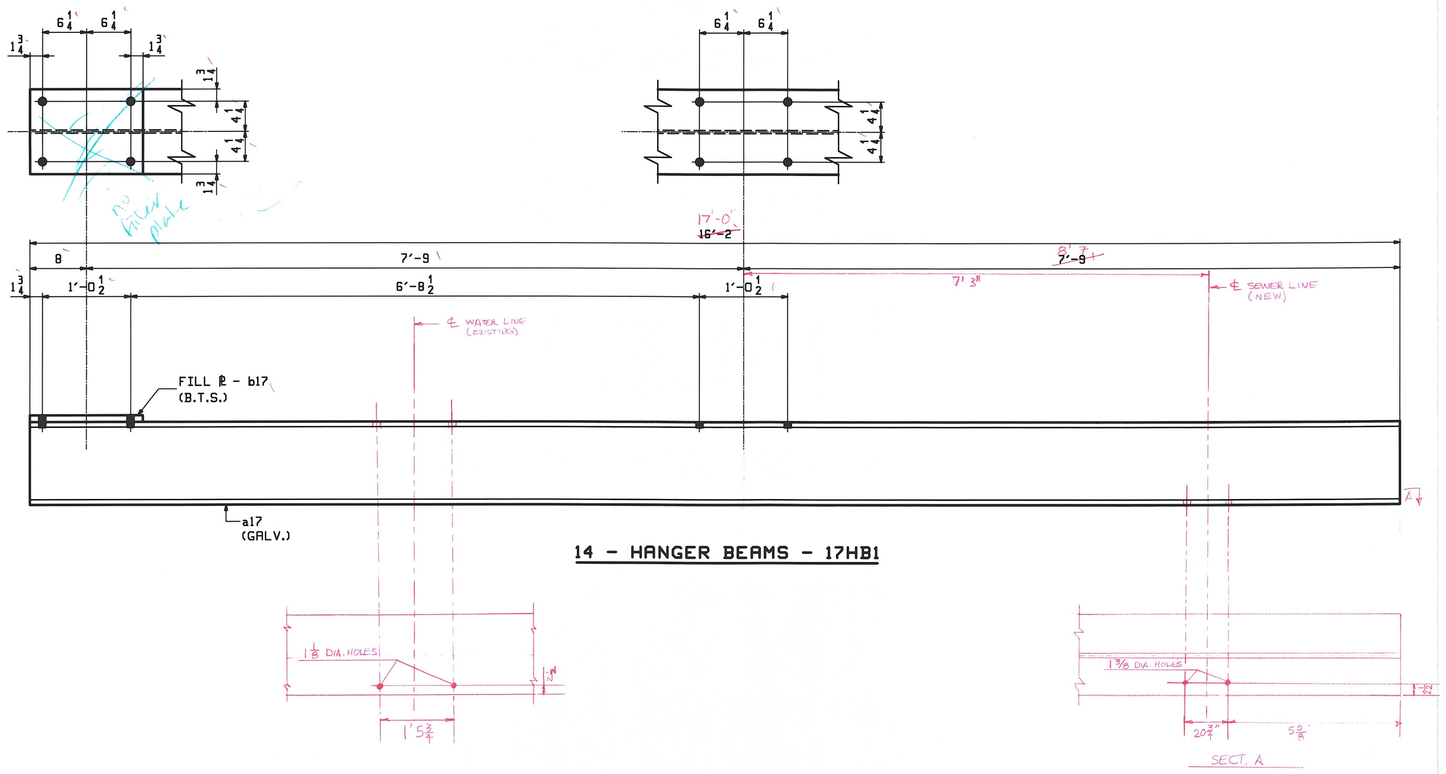

14 - HANGER BEAMS - 17HB1

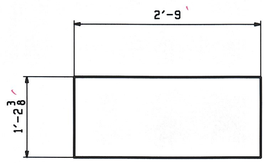

14 - END PLATES - 17M1

ABM INFO		SHIP	BILL OF MATERIAL					JOB NO.	DRAWING NO.	REV.
								406-1	17	
PAGE	LINE	MARK	QTY	MARK	MATERIAL	LENGTH FT	LENGTH INCHES	REMARKS	WT	PROCUREMENT NOTES
		17HB1	14		HANGER BEAM				908	
3	P		14	a17	HP 12x53	16	2	GALV M270-50		
3	Q		14	b17	PL 15/16x12	1	4	FILL B.T.S. GALV M270-36		
		17M1	14		END PLATE				34	
2	M		14		PL 1/4x14 3/8	2	9			

NOTES:
FOR GENERAL NOTES SEE DRAWING GN1.
B.T.S. = BOLT TO SHIP

REV.	DATE	REMARKS	DWN	CHK	APVL	SHOP
0						

MATERIAL:	SURFACE PREP. & PAINT:	HOLES:	SHOP BOLTS:
M270-50W (UN)	SEE GN1	15/16"ø U.N.	NONE

DESCRIPTION: HANGER BEAMS

CASCO BAY STEEL STRUCTURES, INC.
75 SPRING HILL ROAD SACO, MAINE 04072
PHONE (207) 282-7360 FAX. (207) 282-1179
TENSOR 2879

STRUCTURE:	VT 11 OVER BLACK RIVER BRIDGE NO. 64 SPRINGFIELD, VERMONT COUNTY OF WINDSOR	DRAWN: WJF	DATE: 06/15
		CHKD: DO	DATE: 06/24
LOCATION:	TOWN OF SPRINGFIELD	JOB NO.	DWG NO.
PROJ NO.	BHF 016-2(14)	406-1	17
CUSTOMER:	COLD RIVER BRIDGES, LLC		REV. △

RECEIVED
CK'D BY DRP OK'D BY CWC
JUN 26 2009
RESUBMIT ___ APPROVED ✓AS NOTED
BY CWC DATE 7-13-09

DO Thu, Jun 25, 2009 02:05:15 PM /users/jobs/2879/17 : Rev0