STATE OF VERMONT
AGENCY OF TRANSPORTATION

TRAFFIC SIGN SUMMARY SHEET 4

MILEMARKER, STATION, OR SIGN NUMBER	SIGN LEGEND	SIGN DIMENSIONS EA	SIGN DIMENSIONS WIDTH (in)	SIGN DIMENSIONS HEIGHT (in)	NEW & SALVAGED SIGNS "A"	NEW & SALVAGED SIGNS "B"	NEW & SALVAGED SIGNS SALV SIGN	NEW & SALVAGED SIGNS SALV TIS	EXIST POST RETAIN	EXIST POST SALVAGE	NEW SIGN POSTS NO. OF POSTS	FLANGED CHANNEL lb/ft 1.12	FLANGED CHANNEL lb/ft 2.0	FLANGED CHANNEL lb/ft 3.0	SQUARE STEEL (in) 2.0 lb/ft 2.16	SQUARE STEEL (in) 2.0 lb/ft 2.42	SQUARE STEEL (in) 2.5 lb/ft 3.35	ANCHOR	SLEEVE	TUBULAR ALUMINUM Ø (in) 3.0 lb/ft 1.3	TUBULAR ALUMINUM Ø (in) 4.0 lb/ft 1.7	TUBULAR ALUMINUM Ø (in) 4.0 MOD lb/ft 1.7	TUBULAR STEEL Ø (in) FOUND-ATION	TUBULAR STEEL Ø (in) 3.0 lb/ft 7.6	TUBULAR STEEL Ø (in) 3.5 lb/ft 9.0	TUBULAR STEEL Ø (in) 4.0 lb/ft 10.8	TUBULAR STEEL Ø (in) 5.0 lb/ft 14.6	W-SHAPE STEEL FTG. SIZE 24"	W-SHAPE STEEL FTG. SIZE 30"	W-SHAPE STEEL WEIGHT	W-SHAPE STEEL POST SIZE	SIGN FRAME REQUIRED	REMARKS	SIGN DETAIL DETAIL ON SHEET NUMBER	SIGN DETAIL STD. SHEET NUMBER
												OPTION ITEMS																							
129+41.28, LT.		1	30	30	6.25						1					×																	RI-1		E-143
130+03.80, LT.		1	30	30	6.25						1					×																	RI-1		E-143
130+03.80, LT.		1	24	30	5.00						1					×																	VR-017		E-141
~~130+94.40~~, RT. 130+30.82	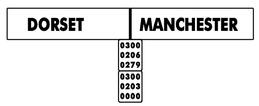	1 2	72 6	10 10	5.00 0.84						1					×																	VD-024 VD-702 VD-702		E-124 E-138 E-138
133+21.44, LT.		1 1	30 24	30 8	6.25 1.33						1					×																	W2-2 W16-8	29	E-142 E-123
143+19.36, LT.		1	24	30	5.00						1					×																	R2-1		E-142
147+52.32, LT.	RETAINED SIGN										1					×																			
151+48.32, RT.		1	6	10	0.42						1					×																	VR-702		E-138
155+12.01, LT.		1	24	30	5.00						1					×																	RI-1		E-142 E-138
156+21.68, LT.		1	30	30	6.25						1					×																	RI-1		E-143
157+92.48, RT.		1	24	30	5.00						1					×																	RI-1		E-142 E-138
												FT	FT	FT	FT	FT 165	FT		EA	LB	LB	LB		LB	LB	LB	LB								
	TOTALS				SF 52.59	SF	EA.	SF				FT			FT 165					LB			EA.	LB				EA.	EA.	LB					

FINAL POST LENGTHS ARE TO BE DETERMINED IN THE FIELD. POST SIZES ARE COMPUTED BASED ON INFORMATION FURNISHED ON THE STANDARD SHEETS AND THE ROADWAY, TRAFFIC & SAFETY SECTION'S "SIGN POST DESIGN GUIDELINE."

PROJECT NAME: MANCHESTER-PAWLET
PROJECT NUMBER: STPG_SIGN_(14)

FILE NAME: STP_SIGN_14.dgn
PROJECT LEADER: N. AVERY
DESIGNED BY: N. AVERY
TRAFFIC_SIGN_SUMMARY_SHEET_4

PLOT DATE: 22-APR-2009 16:
DRAWN BY: ROADWAY
CHECKED BY: A. GAMBLE
SHEET 33 OF 60