STATE OF VERMONT
AGENCY OF TRANSPORTATION

TRAFFIC SIGN SUMMARY SHEET 26

MILEMARKER, STATION, OR SIGN NUMBER	SIGN LEGEND	SIGN DIMENSIONS EA	SIGN DIMENSIONS WIDTH (in)	SIGN DIMENSIONS HEIGHT (in)	NEW & SALVAGED SIGNS "A"	NEW & SALVAGED SIGNS "B"	NEW & SALVAGED SIGNS SALV SIGN	NEW & SALVAGED SIGNS SALV TIS	EXIST POST RETAIN	EXIST POST SALVAGE	NEW SIGN POSTS NO. OF POSTS	FLANGED CHANNEL lb/ft 1.12	FLANGED CHANNEL lb/ft 2.0	FLANGED CHANNEL lb/ft 3.0	SQUARE STEEL (in) 2.0 lb/ft 2.16	SQUARE STEEL (in) 2.0 lb/ft 2.42	SQUARE STEEL (in) 2.5 lb/ft 3.35	ANCHOR	SLEEVE	TUBULAR ALUMINUM Ø (in) 3.0 lb/ft 1.3	TUBULAR ALUMINUM Ø (in) 4.0 lb/ft 1.7	TUBULAR ALUMINUM Ø (in) 4.0 MOD lb/ft 1.7	TUBULAR STEEL Ø (in) FOUND-ATION	TUBULAR STEEL Ø (in) 3.0 lb/ft 7.6	TUBULAR STEEL Ø (in) 3.5 lb/ft 9.0	TUBULAR STEEL Ø (in) 4.0 lb/ft 10.8	TUBULAR STEEL Ø (in) 5.0 lb/ft 14.6	W-SHAPE STEEL FTG. SIZE 24"	W-SHAPE STEEL FTG. SIZE 30"	W-SHAPE STEEL WEIGHT	W-SHAPE STEEL POST SIZE	SIGN FRAME REQUIRED	REMARKS	SIGN DETAIL DETAIL ON SHEET NUMBER	SIGN DETAIL STD. SHEET NUMBER
												OPTION ITEMS																							
978+74.00, LT.		2 2 2	24 24 21	12 24 15	4.00 8.00 4.38						2					X																	M3-1 M1-5 M6-1L	M3-3 M1-5 M6-1R		E-136B E-136C E-136B E-136C E-136B
978+84.57, LT.		1	30	30	6.25						1					X																	R1-1			E-143
980+39.04, LT.		2 1 1 2	24 24 30 21	12 24 24 15	4.00 4.00 5.00 4.38						2					X																	M3-3 M1-5 M6-3	M3-4 M1-6 M6-1R		E-136B E-136C E-136B E-136C E-136B E-136C
980+81.28, RT.		1 1	24 24	12 24	2.00 4.00						1					X																	M3-1 M1-5			E-136B E-136B
~~985+67.04~~, LT. 986+88.48	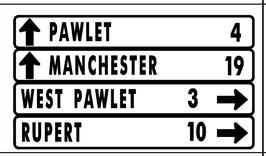	4	72	12	24.00						2						X	X															D1-1A D1-1A D1-1A D1-1A			E-123 E-123 E-123 E-123
~~987+67.04~~, LT. 989+63.04		1 1	21 30	15 24	2.19 5.00						1					X																	M2-1 M1-6			E-136C E-136C
991+94.72, LT.		1	30	30	6.25						1					X																	R1-1			E-143
992+50.02, LT.		1	24	30	5.00						1					X																	VR-017			E-141
												FT	FT	FT	FT	FT 135	FT 30		EA	LB	LB	LB		LB	LB	LB	LB								
												FT			FT 165					LB			EA.	LB				EA.	EA.	LB					
TOTALS					SF 88.45	SF	EA.	SF																											

FINAL POST LENGTHS ARE TO BE DETERMINED IN THE FIELD. POST SIZES ARE COMPUTED BASED ON INFORMATION FURNISHED ON THE STANDARD SHEETS AND THE ROADWAY, TRAFFIC & SAFETY SECTION'S "SIGN POST DESIGN GUIDELINE."

PROJECT NAME: MANCHESTER-PAWLET
PROJECT NUMBER: STPG_SIGN_(14)

FILE NAME: STP_SIGN_14.dgn
PROJECT LEADER: N. AVERY
DESIGNED BY: N. AVERY
TRAFFIC_SIGN_SUMMARY_SHEET_26

PLOT DATE: 22-APR-2009 16:4
DRAWN BY: ROADWAY
CHECKED BY: A. GAMBLE
SHEET 55 OF 60