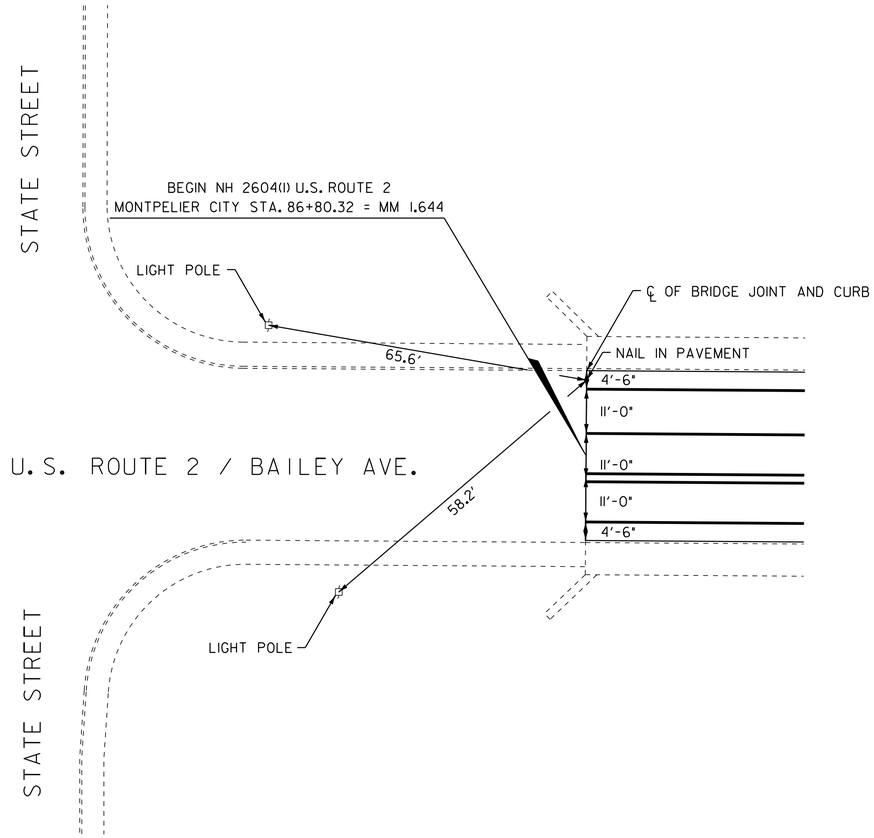

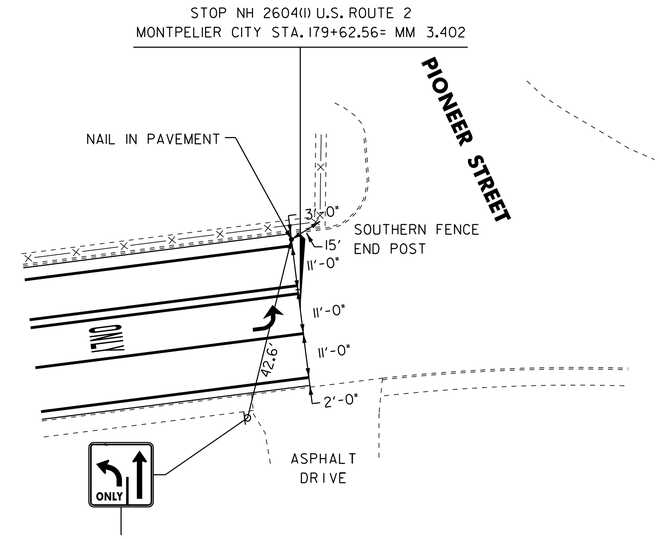

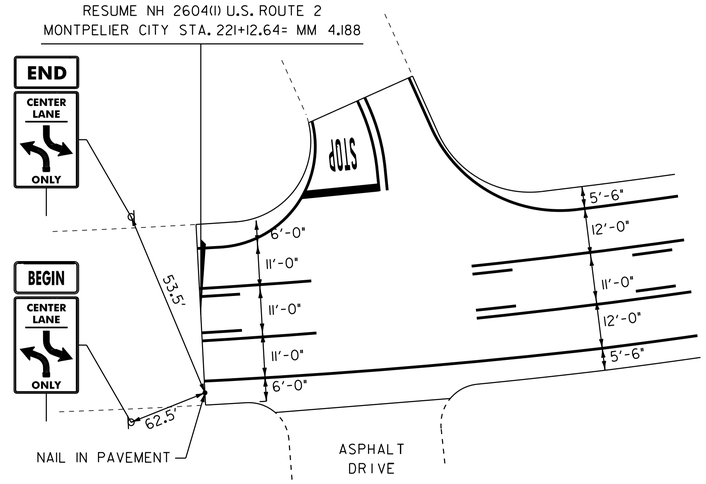

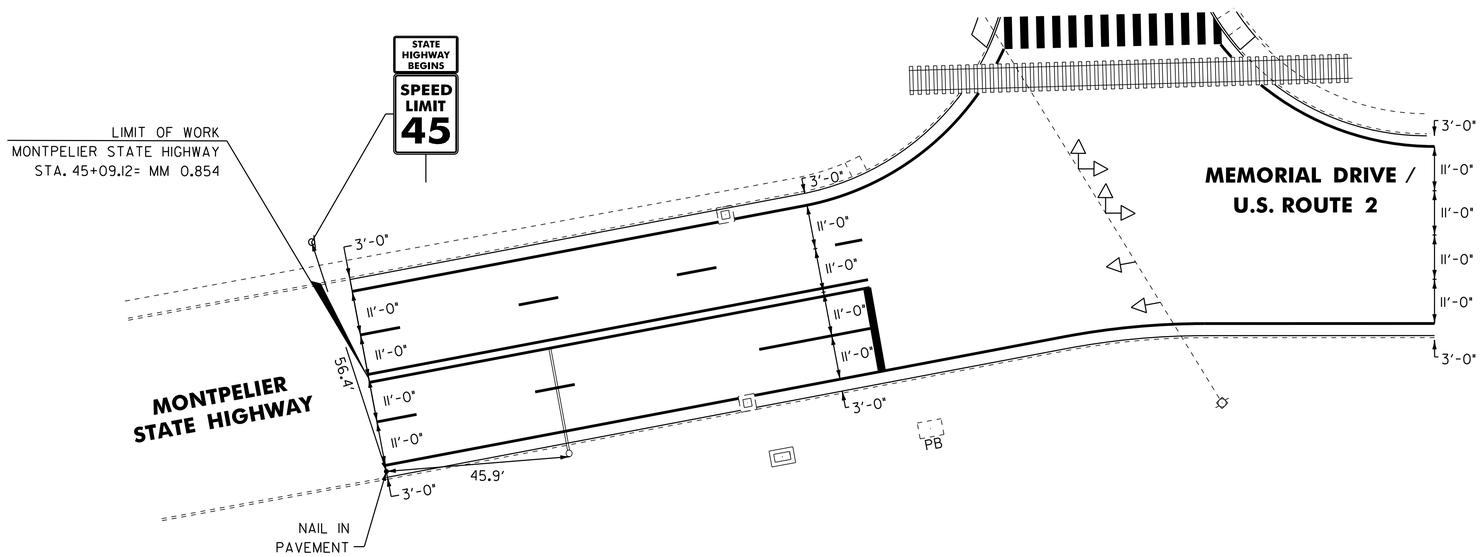

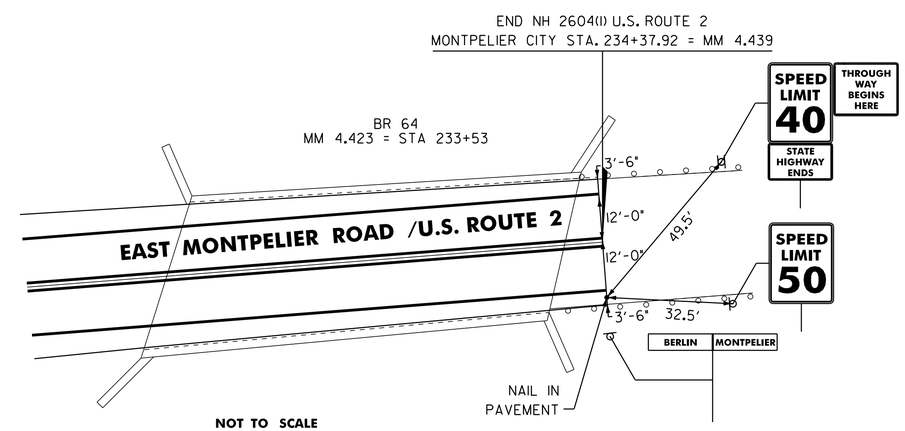

NOT TO SCALE

Stantec

MISCELLANEOUS DETAIL SHEET #2

PROJECT NAME: MONTPELIER
PROJECT NUMBER: NH 2604(I)

FILE NAME: p06b034.dgn
PROJECT LEADER: JLL
DESIGNED BY: MCF
IPARM FILE: p06b034md02.i

PLOT DATE: 03-AUG-2011 14:06
DRAWN BY: STANTEC
CHECKED BY: JLL
SHEET 10 OF 84