STATE OF VERMONT
AGENCY OF TRANSPORTATION

TRAFFIC SIGN SUMMARY SHEET 03

MILEMARKER, STATION, OR SIGN NUMBER	SIGN LEGEND	SIGN DIMENSIONS EA	SIGN DIMENSIONS WIDTH (in)	SIGN DIMENSIONS HEIGHT (in)	NEW & SALVAGED SIGNS "A"	NEW & SALVAGED SIGNS "B"	NEW & SALVAGED SIGNS SALV SIGN	NEW & SALVAGED SIGNS SALV TIS	EXIST POST RETAIN	EXIST POST SALVAGE	NEW SIGN POSTS NO. OF POSTS				SQUARE STEEL (in) 1.75 lb/ft 1.88	SQUARE STEEL (in) 2.0 lb/ft 2.16	SQUARE STEEL (in) 2.5 lb/ft 3.35	ANCHOR	SLEEVE	TUBULAR ALUMINUM Ø (in) 3.0 lb/ft 1.3	TUBULAR ALUMINUM Ø (in) 4.0 lb/ft 1.7	TUBULAR ALUMINUM Ø (in) 4.0 MOD lb/ft 1.7	TUBULAR STEEL Ø (in) FOUND-ATION	TUBULAR STEEL Ø (in) 3.0 lb/ft 7.6	TUBULAR STEEL Ø (in) 3.5 lb/ft 9.0	TUBULAR STEEL Ø (in) 4.0 lb/ft 10.8	TUBULAR STEEL Ø (in) 5.0 lb/ft 14.6	W-SHAPE STEEL FTG. SIZE 24"	W-SHAPE STEEL FTG. SIZE 30"	W-SHAPE STEEL WEIGHT	W-SHAPE STEEL POST SIZE	SIGN FRAME REQUIRED	REMARKS	SIGN DETAIL DETAIL ON SHEET NUMBER	SIGN DETAIL STD. SHEET NUMBER
89+81, LT		1 1	30 24	30 12	6.25 2.0		1				1						X	X															SIGN ID CODE S1-1 SIGN ID CODE W16-7P		E-153 E-152
90+20, RT		1	18 R	-	7.1						1				X			X															SIGN ID CODE W10-1		E-190
90+75, LT		1	36	30	7.5						1					X																	SIGN ID CODE VR-922		E-145A
91+00, RT					5.0		1								X																				
91+05, RT	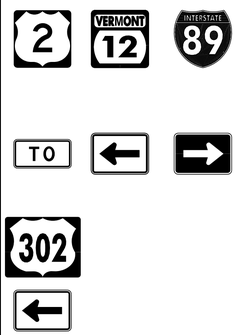	1 1 1 1 1 1 1 1 1 1	24 24 24 24 24 24 21 21 24 30 21	12 12 12 24 24 24 15 15 12 24 15	2.0 2.0 2.0 4.0 4.0 4.0 2.2 2.2 2.0 5.0 2.2						2						X	X													#2	SIGN ID CODE M3-2 SIGN ID CODE M4-5 SIGN ID CODE M4-5 SIGN ID CODE M1-4 SIGN ID CODE M1-1 SIGN ID CODE M4-5 SIGN ID CODE M6-1 SIGN ID CODE M6-1 SIGN ID CODE M6-1		E-136A E-136A E-135 E-136A E-136B E-135 E-136A E-136A E-135 E-136B E-136A
91+77, RT		1	30	30	6.25						1				X			X															SIGN ID CODE R1-1		E-143
															FT ~~31~~ 35.5	FT ~~15~~ 10.5	FT ~~56~~ 46		EA	LB	LB	LB		LB	LB	LB	LB							
TOTALS					SF ~~60.70~~ 65.70	SF	EA. ~~1~~ 2	SF							FT ~~102~~ 92					LB			EA.	LB				EA.	EA.	LB				

FINAL POST LENGTHS ARE TO BE DETERMINED IN THE FIELD. POST SIZES ARE COMPUTED BASED ON INFORMATION FURNISHED ON THE STANDARD SHEETS AND THE VTRANS "SIGN POST DESIGN GUIDELINE."

Stantec

PROJECT NAME: MONTPELIER
PROJECT NUMBER: NH 2604(1)

FILE NAME: p06b034.dgn
PROJECT LEADER: JLL
DESIGNED BY: MCF
IPARM FILE: p06b034tss03.i

PLOT DATE: 03-AUG-2011 14:09
DRAWN BY: STANTEC
CHECKED BY: JLL
SHEET 41 OF 84