STATE OF VERMONT
AGENCY OF TRANSPORTATION

TRAFFIC SIGN SUMMARY SHEET 08

MILEMARKER, STATION, OR SIGN NUMBER	SIGN LEGEND	SIGN DIMENSIONS EA	WIDTH (in)	HEIGHT (in)	NEW & SALVAGED SIGNS "A"	"B"	SALV SIGN	SALV TIS	EXIST POST RETAIN	EXIST POST SALVAGE	NEW SIGN POSTS NO. OF POSTS	SQUARE STEEL (in) 1.75 lb/ft 1.88	2.0 lb/ft 2.16	2.5 lb/ft 3.35	ANCHOR	SLEEVE	TUBULAR ALUMINUM Ø (in) 3.0 lb/ft 1.3	4.0 lb/ft 1.7	4.0 MOD lb/ft 1.7	TUBULAR STEEL Ø (in) FOUND-ATION	3.0 lb/ft 7.6	3.5 lb/ft 9.0	4.0 lb/ft 10.8	5.0 lb/ft 14.6	W-SHAPE STEEL FTG. SIZE 24"	30"	WEIGHT	POST SIZE	SIGN FRAME REQUIRED	REMARKS	SIGN DETAIL DETAIL ON SHEET NUMBER	STD. SHEET NUMBER
109+77, RT		1	24	30	5.0						1	X			X																SIGN ID CODE R2-1		E-142
		1	12	12	1.0																										SIGN ID CODE R8-3A		E-143
110+00, LT		1	24	12	2.0						1			X	X																SIGN ID CODE M3-4		E-136A
		1	24	24	4.0																										SIGN ID CODE MI-4		E-136A
		1	24	12	2.0																										SIGN ID CODE M4-5		E-135
		1	24	24	4.0																										SIGN ID CODE MI-1		E-135
		1	21	15	2.2																										SIGN ID CODE M6-3		E-135
110+88, RT	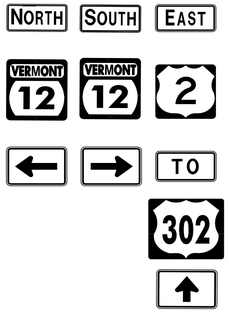	1	24	12	2.0						2			X	X															# 2	SIGN ID CODE M3-1		E-136B
		1	24	12	2.0																										SIGN ID CODE M3-2		E-136A
		1	24	12	2.0																										SIGN ID CODE M3-3		E-136B
		1	24	24	4.0																												E-136B
		1	24	24	4.0																										SIGN ID CODE MI-4		E-136A
		1	24	24	4.0																												E-136B
		1	21	15	2.0																												E-136B
		1	21	15	2.2																												E-136B
		1	24	12	2.0																										SIGN ID CODE M4-5		E-136A
		1	30	24	5.0																										SIGN ID CODE MI-4		E-136A
		1	21	15	2.2																										SIGN ID CODE M6-3		E-136A
111+74, LT		1	30	30	6.25						1	X			X																SIGN ID CODE VR-923		E-145A
112+15, RT	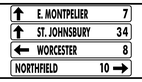	1	72	12	6.0						2			X	X																SIGN ID CODE DI-1		E-123
		1	72	12	6.0																										SIGN ID CODE DI-1		E-123
		1	72	12	6.0																										SIGN ID CODE DI-1		E-123
		1	72	12	6.0																										SIGN ID CODE DI-1		E-123
TOTALS		SF 81.85	SF	EA.	SF							FT ~~30~~ 21.5	FT	FT ~~90~~ 64	EA	LB	LB	LB	EA.	LB	LB	LB	LB	EA.	EA.	LB							
												FT ~~120~~ 85.5				LB			EA.	LB				EA.	EA.	LB							

FINAL POST LENGTHS ARE TO BE DETERMINED IN THE FIELD. POST SIZES ARE COMPUTED BASED ON INFORMATION FURNISHED ON THE STANDARD SHEETS AND THE VTRANS "SIGN POST DESIGN GUIDELINE."

Stantec

PROJECT NAME: MONTPELIER
PROJECT NUMBER: NH 2604(I)

FILE NAME: p06b034.dgn
PROJECT LEADER: JLL
DESIGNED BY: MCF
IPARM FILE: p06b034tss08.i
PLOT DATE: 03-AUG-2011 4:10
DRAWN BY: STANTEC
CHECKED BY: JLL
SHEET 46 OF 84