TEMPORARY 100mm WHITE LINE, PAINT
DURABLE 100mm WHITE LINE, THERMOPLASTIC
STA 1+620 TO 1+632 SOLID LT EDGE LINE
STA 1+620 TO 1+625 SOLID RT PARKING
STA 1+625 TO 1+632 SOLID RT NO PARKING
STA 1+635 TO 1+712 SOLID LT EDGE LINE
STA 1+655 TO 1+660 SOLID RT NO PARKING
STA 1+660 TO 1+724 SOLID RT EDGE LINE
STA 1+724 TO 1+729 SOLID RT NO PARKING
STA 1+746 TO 1+753 SOLID LT EDGE LINE
STA 1+767 TO 1+773 SOLID LT NO PARKING
STA 1+773 TO 1+780 SOLID LT PARKING
STA 2+008 TO 2+041 SOLID LT EDGE LINE
STA 2+043 TO 2+055 SOLID RT EDGE LINE
STA 2+044 TO 2+080 SOLID LT EDGE LINE
STA 2+055 TO 2+080 SOLID RT PARKING

TEMPORARY 100mm WHITE LINE, PAINT
STA 2+025 TO 2+041 SOLID RT
STA 2+044 TO 2+060 SOLID LT LANE LINE

DURABLE 100mm WHITE LINE, TYPE I TAPE
STA 2+025 TO 2+041 SOLID RT
STA 2+044 TO 2+060 SOLID LT LANE LINE

TEMPORARY 100mm YELLOW LINE, PAINT
DURABLE 100mm YELLOW LINE, THERMOPLASTIC
STA 1+620 TO 1+632 SOLID LT & RT
STA 1+635 TO 1+641 SOLID LT & RT
STA 1+648 DOUBLE SOLID RT (PROSPECT ST)
STA 1+653 TO 1+705 SOLID LT & RT
STA 1+705 TO 1+734 SOLID RT
STA 1+733 DOUBLE SOLID RT (PROSPECT ST)
STA 2+000 TO 2+041 SOLID LT

TEMPORARY 600mm STOP BAR, PAINT
DURABLE 600mm STOP BAR, TYPE I TAPE
STA 1+649 RT (PROSPECT ST)
STA 1+733 RT (PROSPECT ST)

TEMPORARY LETTER OR SYMBOL, PAINT
STA 1+622 RT - DISABLED MARKING
STA 1+650 RT - "STOP" (PROSPECT ST)
STA 1+730 RT - "STOP" (PROSPECT ST)
STA 1+735 TO 1+745 LT - YIELD MARKINGS (12)

DURABLE LETTER OR SYMBOL, TYPE I TAPE
STA 1+622 RT - DISABLED MARKING
STA 1+650 RT - "STOP" (PROSPECT ST)
STA 1+730 RT - "STOP" (PROSPECT ST)
STA 1+735 TO 1+745 LT - YIELD MARKINGS (12)
STA 2+046 RT - "ONLY"
STA 2+059 RT - LEFT TURN ARROW

TEMPORARY CROSSWALK MARKING, PAINT
STA 1+634 LT TO RT
STA 2+042 LT TO RT

SPECIAL PROVISION (DURABLE CROSSWALK MARKING, IMPRINTED/COLORIZED)
STA 1+634 LT TO RT
STA 2+042 LT TO RT

SPECIAL PROVISION (IMPRINTED/COLORIZED SURFACE)
STA 2+001 TO 2+041 RT

CONSTRUCT SIDEWALK RAMP W/DETECTABLE WARNING SURFACE (RED)
STA 1+634 LT (TYPE 6)
STA 1+634 RT (CONCRETE LANDING)
STA 2+042 LT (CONCRETE LANDING)
STA 2+042 RT (TYPE 6)

REHAB. DROP INLETS, CATCH BASINS, OR MANHOLES CLASS I
STA 1+637 RT (DI)
STA 1+655 RT (DI) CHANGE ELEV.
STA 1+673 RT (DI)

CHANGING ELEVATION OF DROP INLETS, CATCH BASINS, OR MANHOLES
STA 1+655 LT (DI) REHAB
STA 1+768 RT (DI)

CHANGING ELEVATION OF DROP INLETS, CATCH BASINS, OR MANHOLES (BY OTHERS)
STA 1+650 RT (ELECTRIC MH)
STA 1+716 RT (CABLE TV MH)

CHANGING ELEVATION OF SEWER MANHOLES
STA 1+645 LT
STA 1+707 CL REHAB
STA 1+755 RT
I+655 RT

ADJUST ELEVATION OF VALVE BOX DONE BY TOWN
STA 1+644 RT
STA 1+657 RT

VERTICAL GRANITE CURB (100mm REVEAL)
STA 1+753 TO 1+780 LT
STA 2+043 TO 2+080 RT

~~REMOVING AND RESETTING FENCE~~
~~STA 1+629 TO 1+638 LT~~

SPECIAL PROVISION (REMOVE AND RESET PARKING METER)
FROM STA 2+060 TO 2+056 RT
FROM STA 2+066 TO 2+063 RT
FROM STA 2+072 TO 2+069 RT
FROM STA 2+079 TO 2+076 RT

SPECIAL PROVISION (REMOVE PARKING METER) (TO BE RETURNED TO THE TOWN)
STA 2+053 RT

REMOVING SIGNS
AS SHOWN - 42

ERECTING SALVAGED SIGNS
AS SHOWN - 1

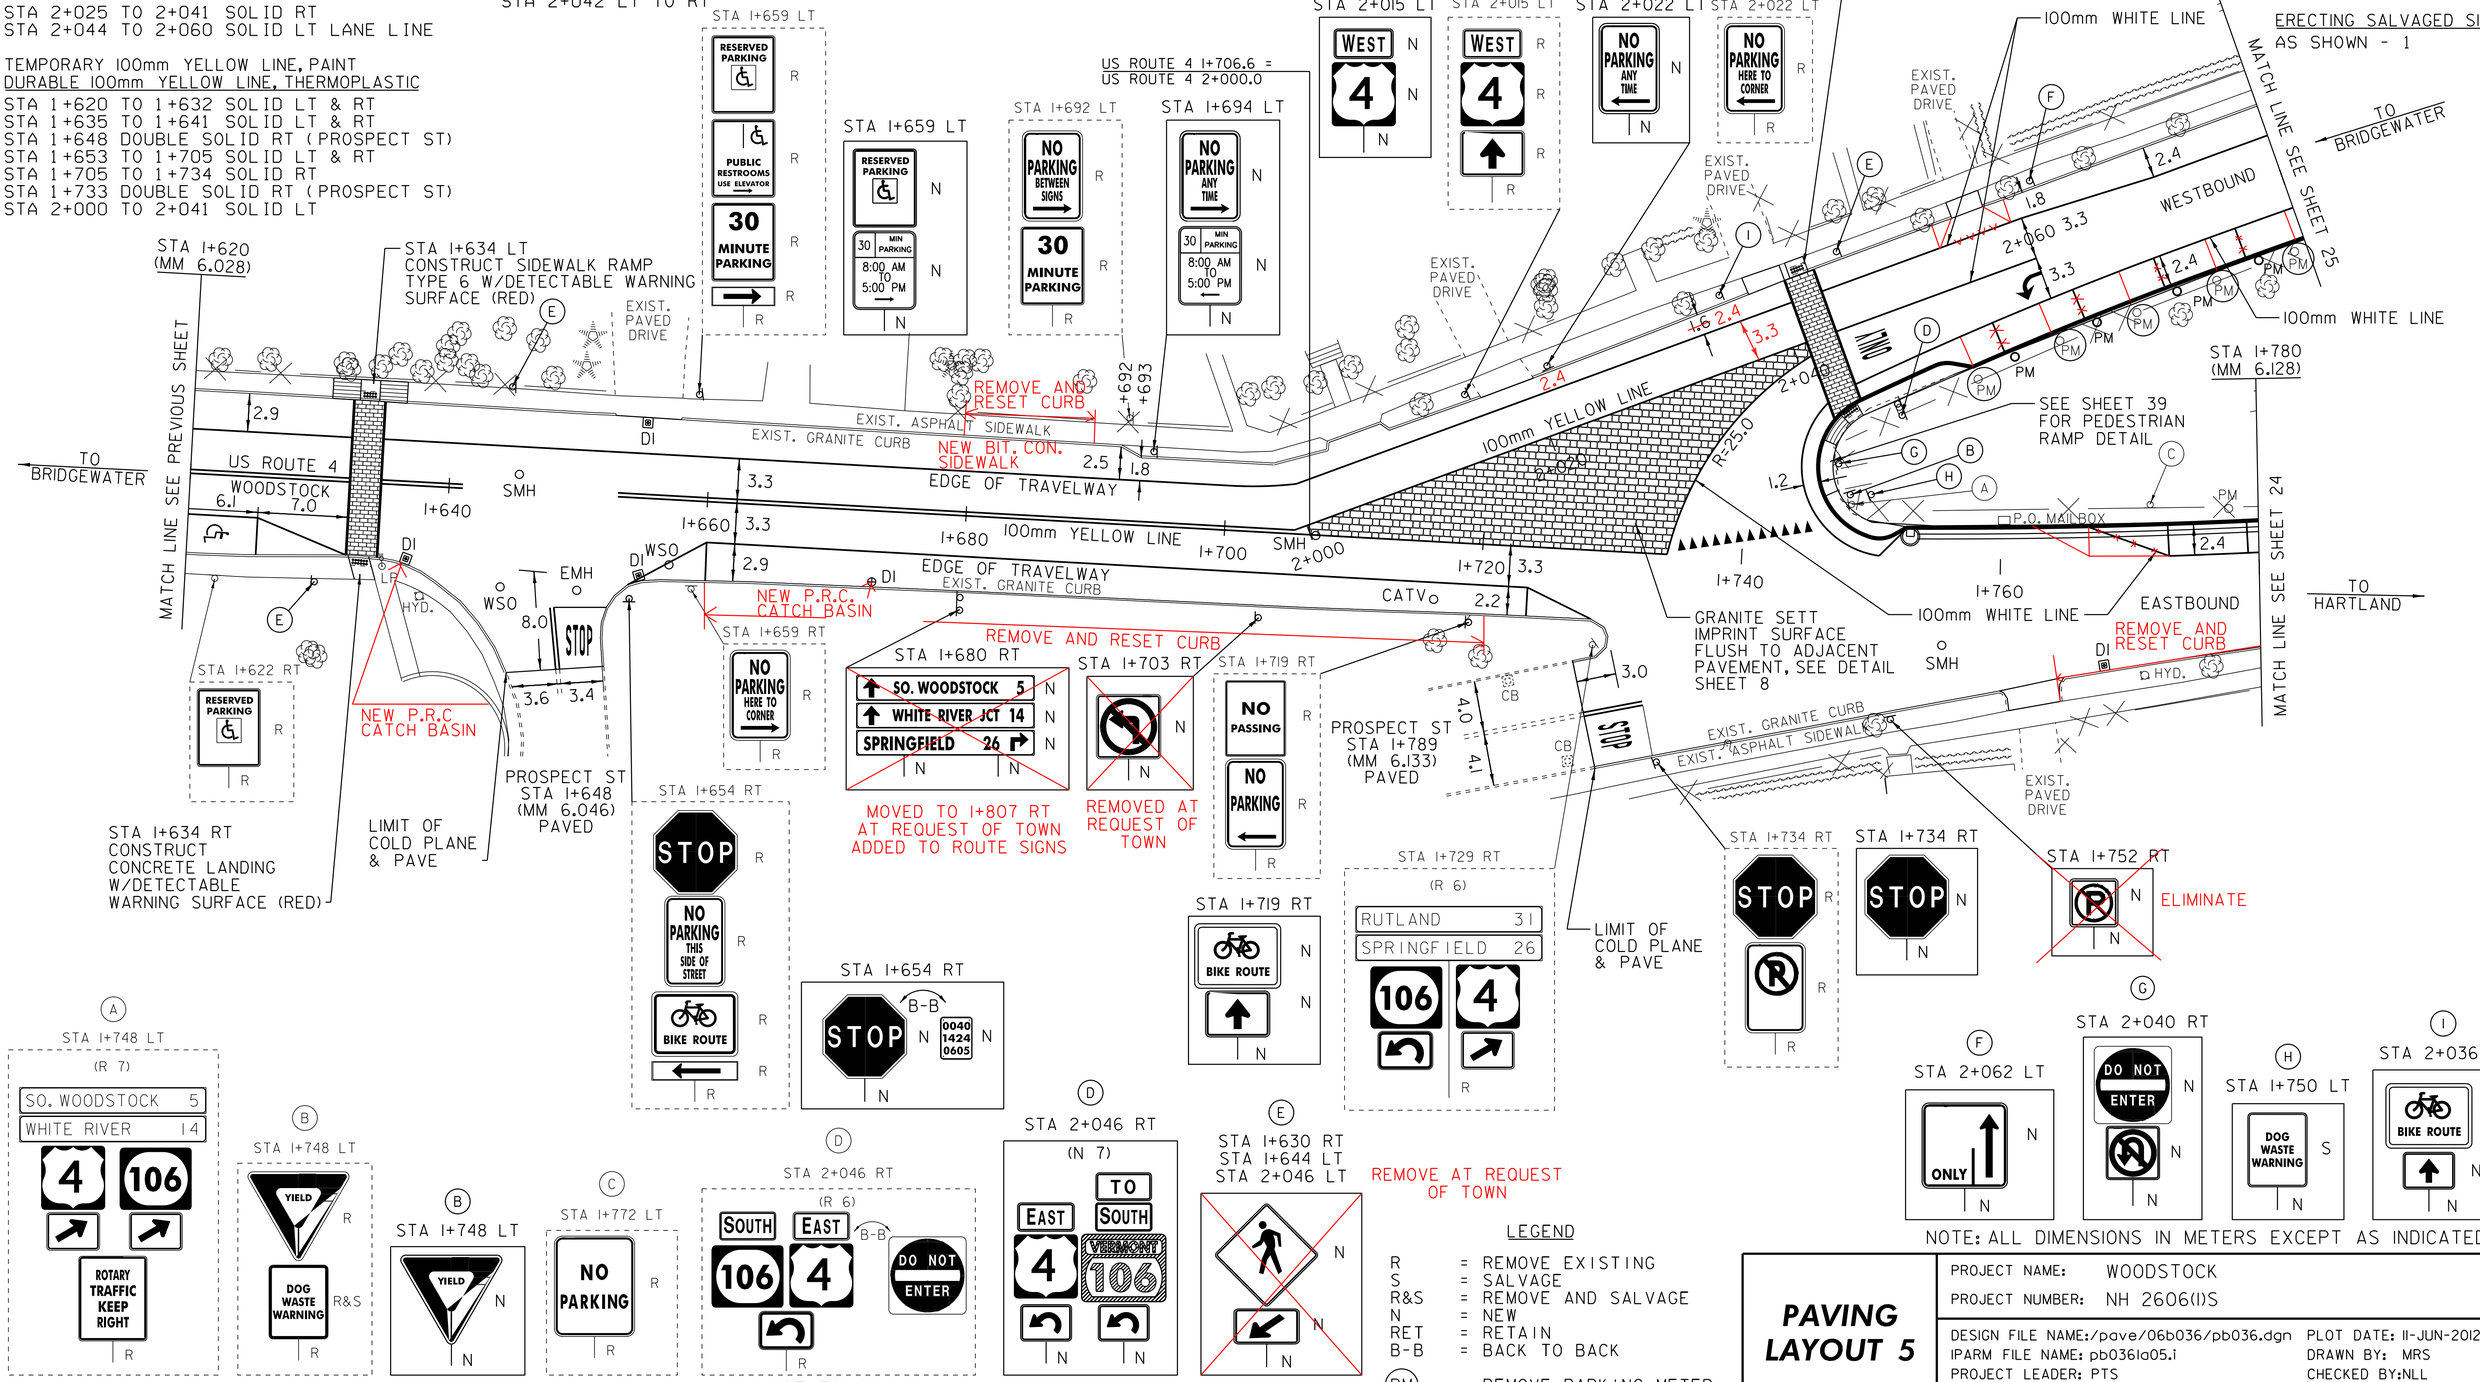

NOT TO SCALE

NOTE: ALL DIMENSIONS IN METERS EXCEPT AS INDICATED

LEGEND
R = REMOVE EXISTING
S = SALVAGE
R&S = REMOVE AND SALVAGE
N = NEW
RET = RETAIN
B-B = BACK TO BACK
(PM) = REMOVE PARKING METER

PAVING LAYOUT 5

PROJECT NAME: WOODSTOCK
PROJECT NUMBER: NH 2606(I)S

DESIGN FILE NAME:/pave/06b036/pb036.dgn
IPARM FILE NAME: pb036ia05.i
PROJECT LEADER: PTS
DESIGNED BY: NLL
PLOT DATE: 11-JUN-2012 16:15
DRAWN BY: MRS
CHECKED BY:NLL
SHEET 23 OF 73