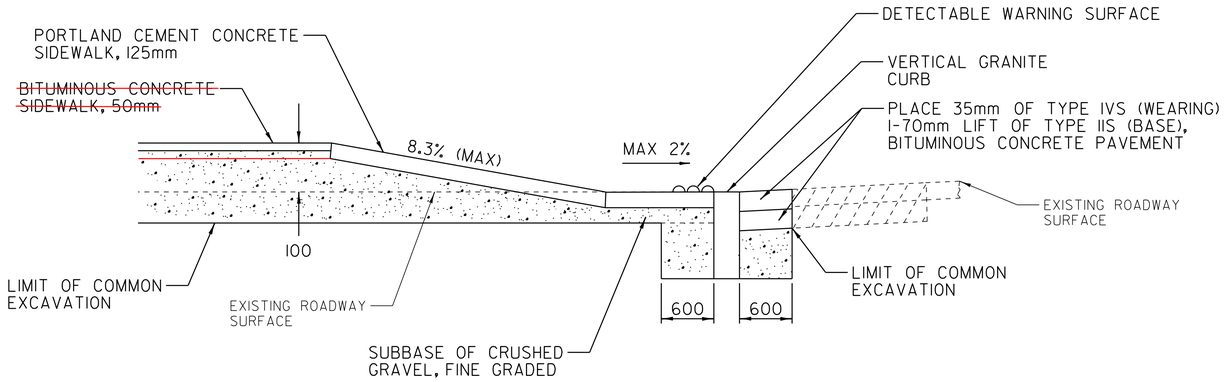

SECTION A – A

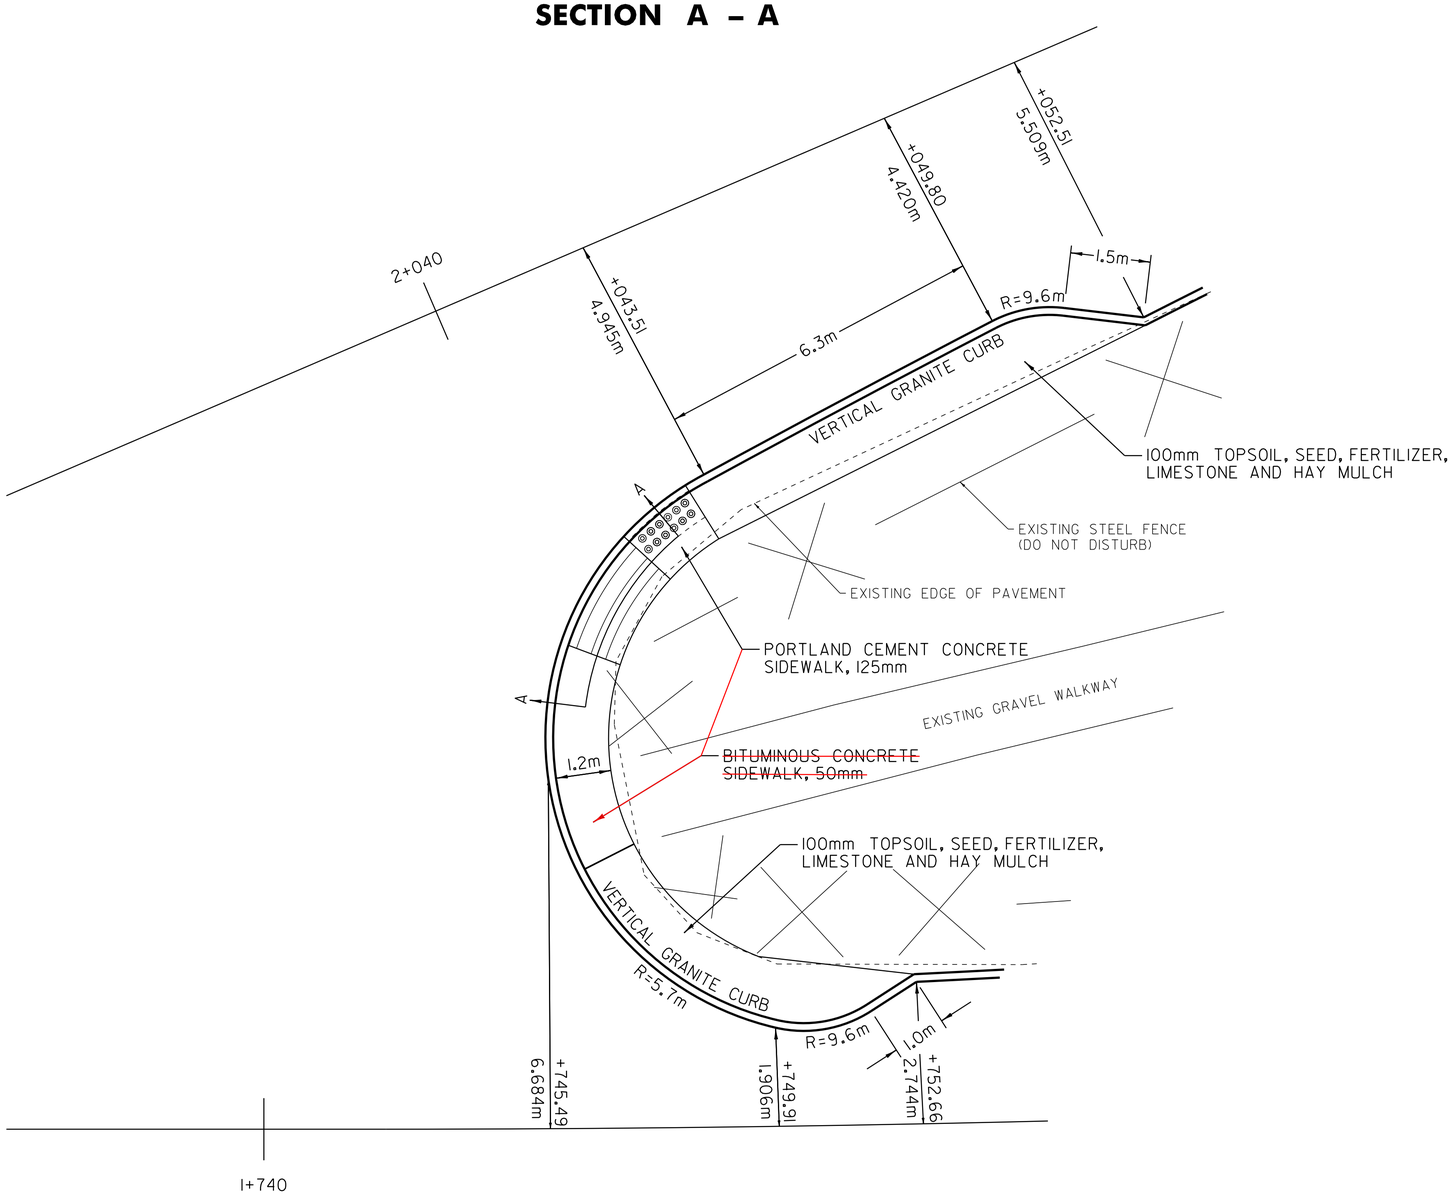

BULB-OUT DETAIL
WEST END VILLAGE GREEN

NOT TO SCALE

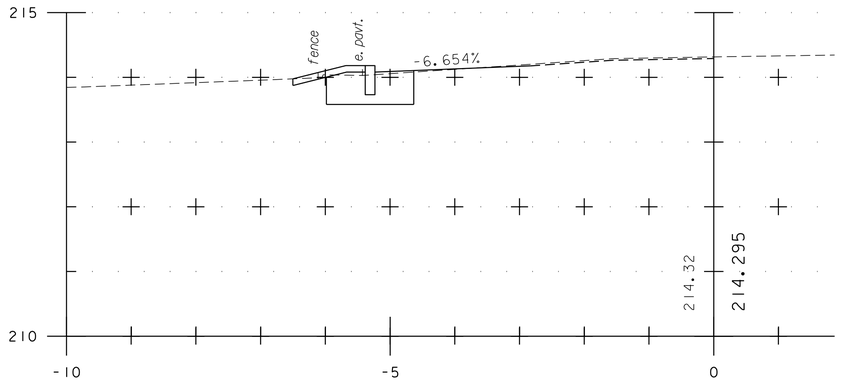

STA 1+840

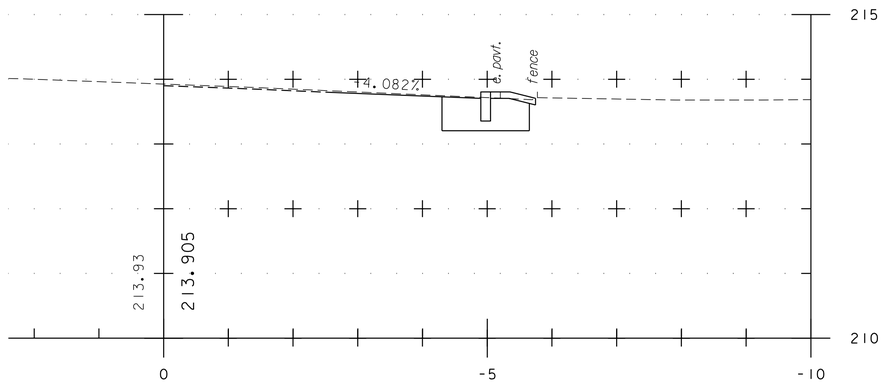

STA 2+100

CROSS SECTION CURB CONSTRUCTION DETAIL

NOT TO SCALE

NOTE: ALL DIMENSIONS IN MILLIMETERS EXCEPT AS INDICATED

VILLAGE GREEN CURB DETAILS 1	PROJECT NAME: WOODSTOCK	
	PROJECT NUMBER: NH 2606(I)S	
	DESIGN FILE NAME:/pave/06b036/pb036.dgn	PLOT DATE: 11-JUN-2012 16:16
	IPARM FILE NAME: pb036dt04.i	DRAWN BY: MRS
	PROJECT LEADER: PTS	CHECKED BY:NLL
	DESIGNED BY: NLL	SHEET 39 OF 73